


SPECIAL DITCH, ITEM 101-A
 REST AREA 2+50-3+25 RT /
 TRUCK LANE 7+00-8+62 RT /

GRANITE SLOPE EDGING, ITEM 556-A
 SB REST AREA 1+35-1+85 LT
 SB 3639+66 - 3640+16 LT

Bituminous Concrete Surface
 1/2" Asphalt Binder
 1 1/2" Hot Mix Aggregate
 1 1/2" Hot Mix Aggregate
PROPERTY LINE FENCE W/STEEL POSTS,
 ITEM 583-B
 SB REST AREA 1+84-11+40 RT /
 DELETE SB 3631+95-3633+00 LT
 DELETE SB 3639+00-3640+00 LT

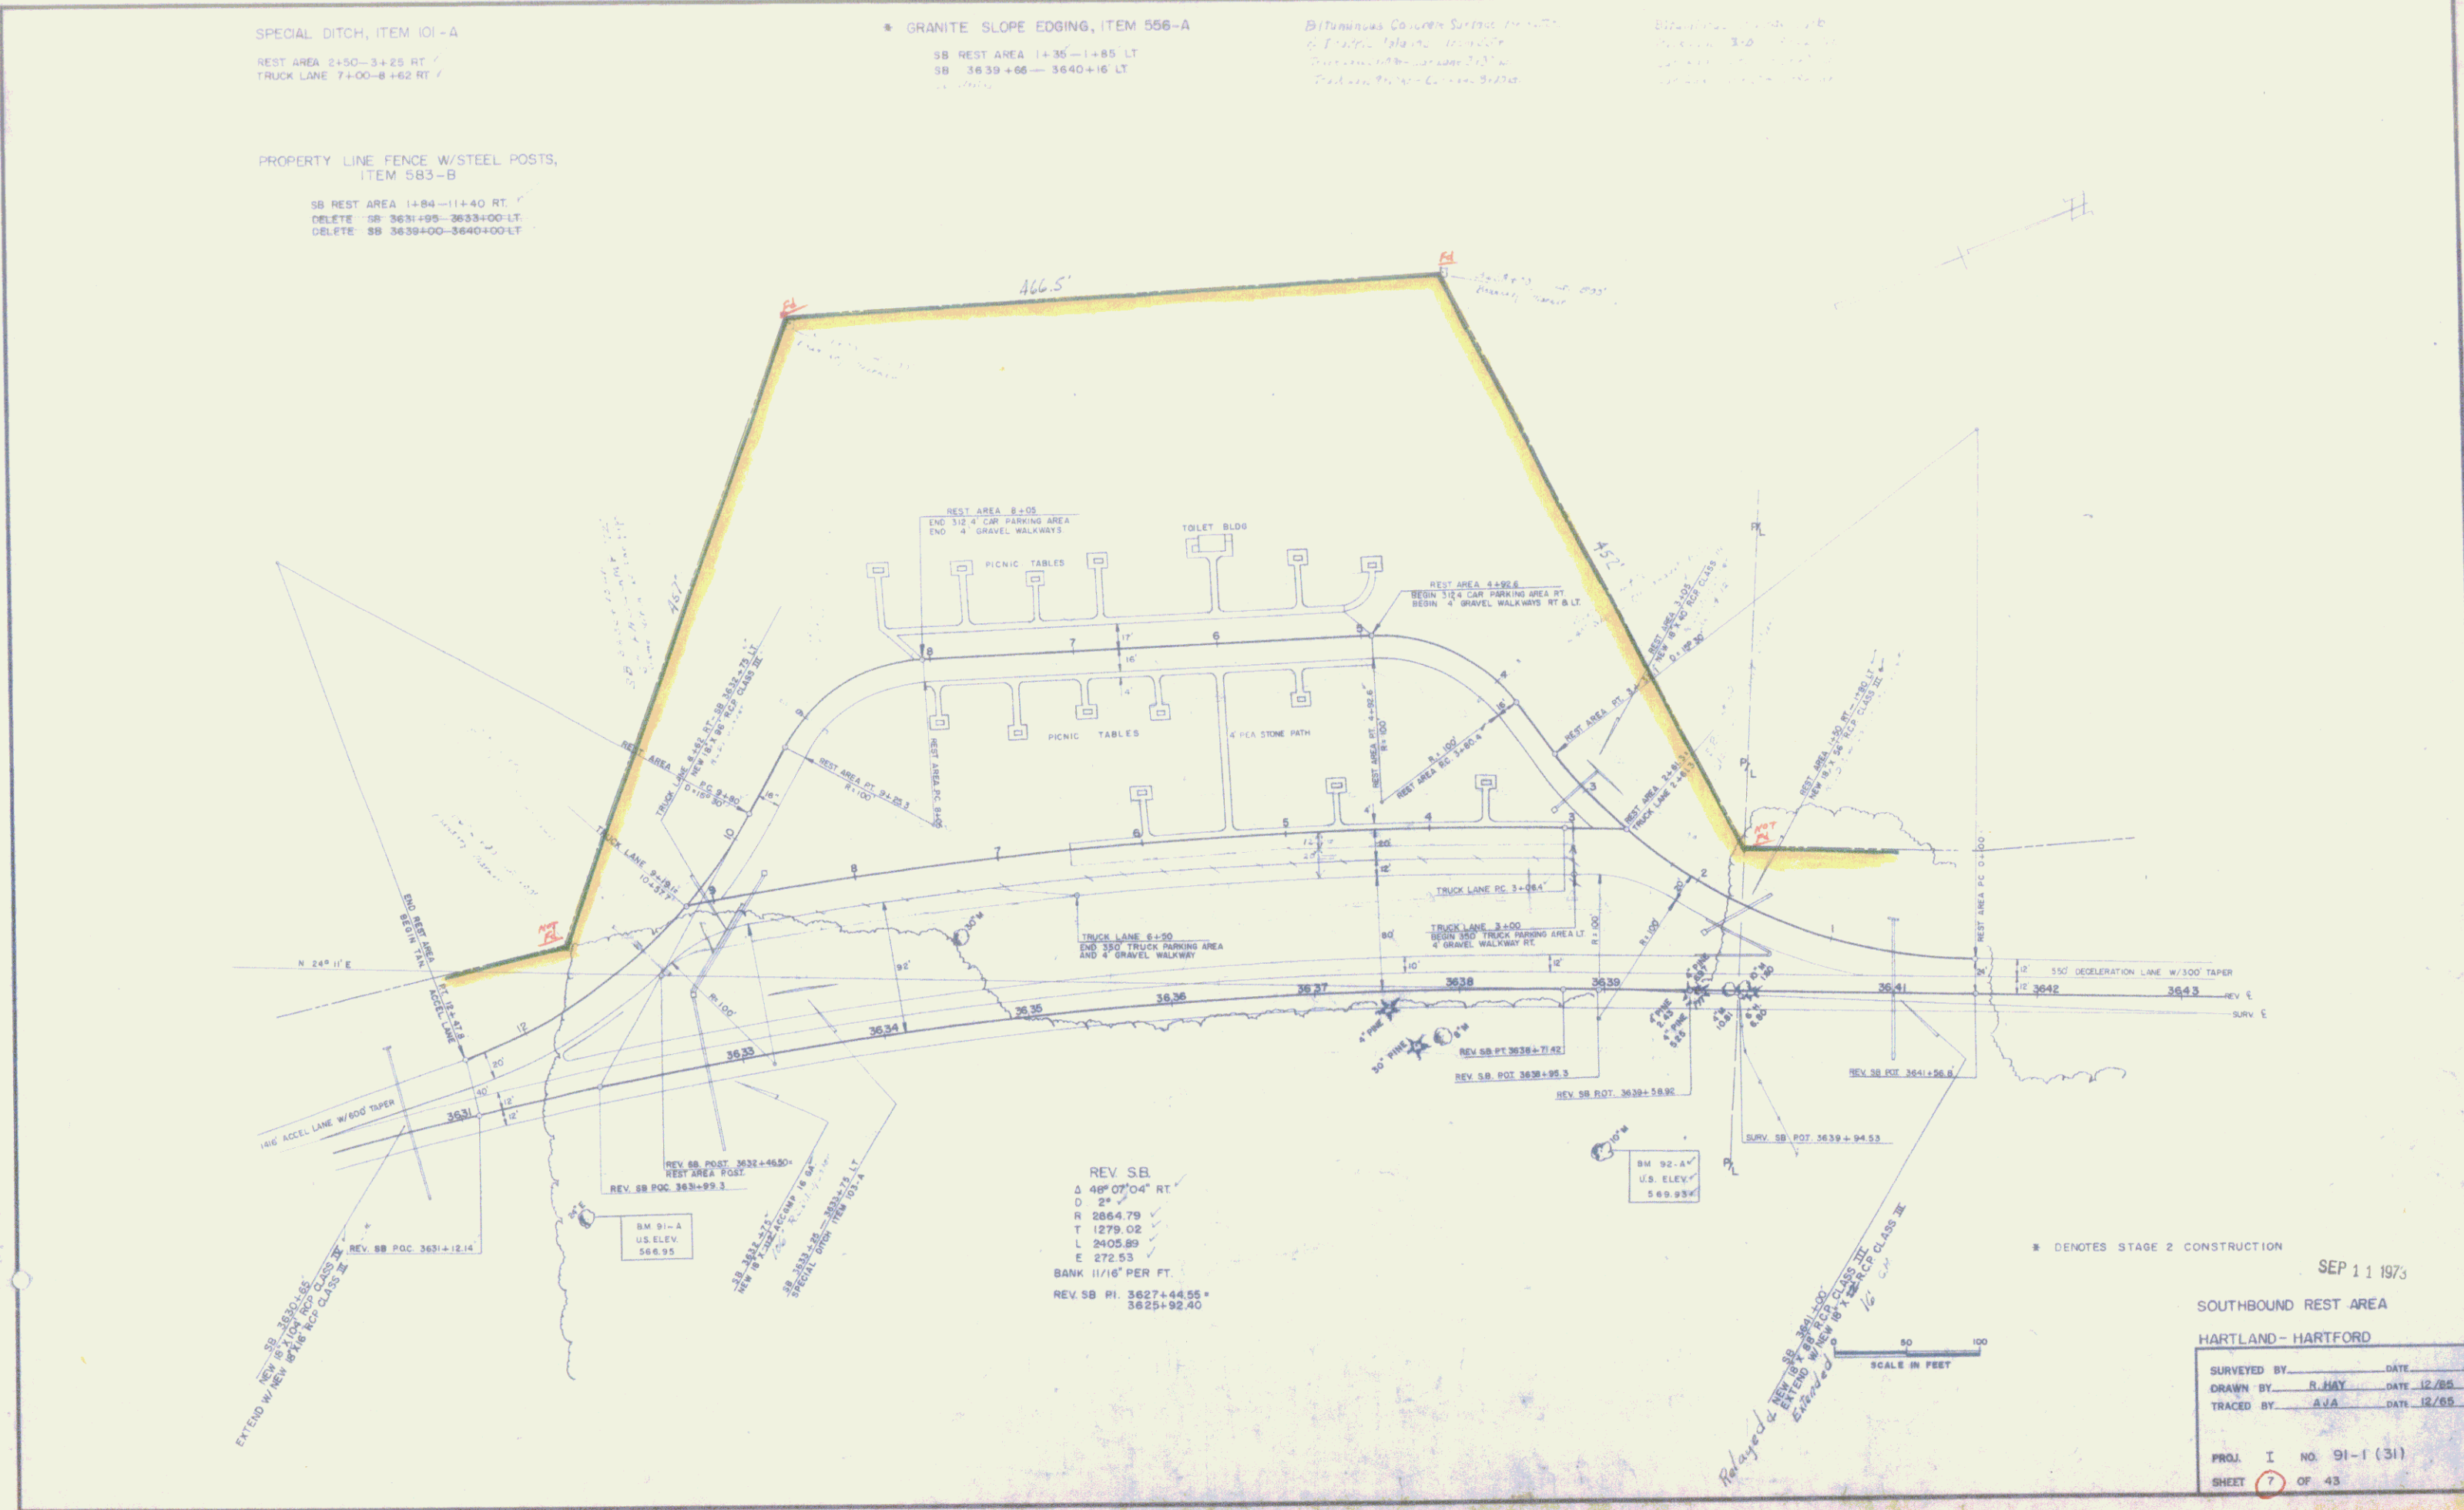

REV SB
 Δ 48° 07' 04" RT
 D 2"
 R 2864.79
 T 1279.02
 L 2405.89
 E 272.53
 BANK 11/10" PER FT.
 REV SB PI. 3627+44.55
 3625+92.40

• DENOTES STAGE 2 CONSTRUCTION

SEP 11 1973

SOUTHBOUND REST AREA
 HARTLAND - HARTFORD

SURVEYED BY	DATE
DRAWN BY R. JAY	DATE 12/65
TRACED BY A.V.A.	DATE 12/65
PROJ. I NO. 91-1 (31)	
SHEET 7	OF 43

Relayed & REV SB 3631+95
 EXTEND W/ 1/2" ASPHALT BINDER
 1 1/2" HOT MIX AGGREGATE
 1 1/2" HOT MIX AGGREGATE
 1 1/2" HOT MIX AGGREGATE

508