

* THREE RAIL GUARD RAIL W/
STEEL POSTS - ITEM 543, 542
3232+00 - 3239+00 N.B. RT
3232+92 - 3239+00 S.B.-LT

* BITUMINOUS CONCRETE CURB
ITEM 555
3233+50 - 3239+00 S.B.-LT

* STAGE 2 CONSTRUCTION

DEMOLITION / REMOVAL OF BUILDING
ITEM 536
3231+30 S.B.-LT SHED
3231+00 S.B.-LT SAWMILL

SUB-BASE OF SAND, ITEM 207
3223+00 - 3231+20 NB


PROPERTY LINE FENCE ITEM 563 D
3220+00 - 3230+00 S.S.-LT
3226+00 - 3234+00 NB H.F.

CONTROL OF ACCESS COMPLETE ON THIS SHEET

SB
A 21° 27' 45" LT
D 2° 03' 11"
R 2770.83
T 522.00
L 1045.42
E 47.68
Bnk. 1/8 per ft.


NB
A 16° 55' 55" LT
D 2° 00'
R 2864.79
T 426.41
L 876.60
E 31.56
Bnk. 1/8 per ft.

Conc. Arch Culvert Designed
by Bridge Dept.
See Sheets Br. 100 thru Br. 119
for Details

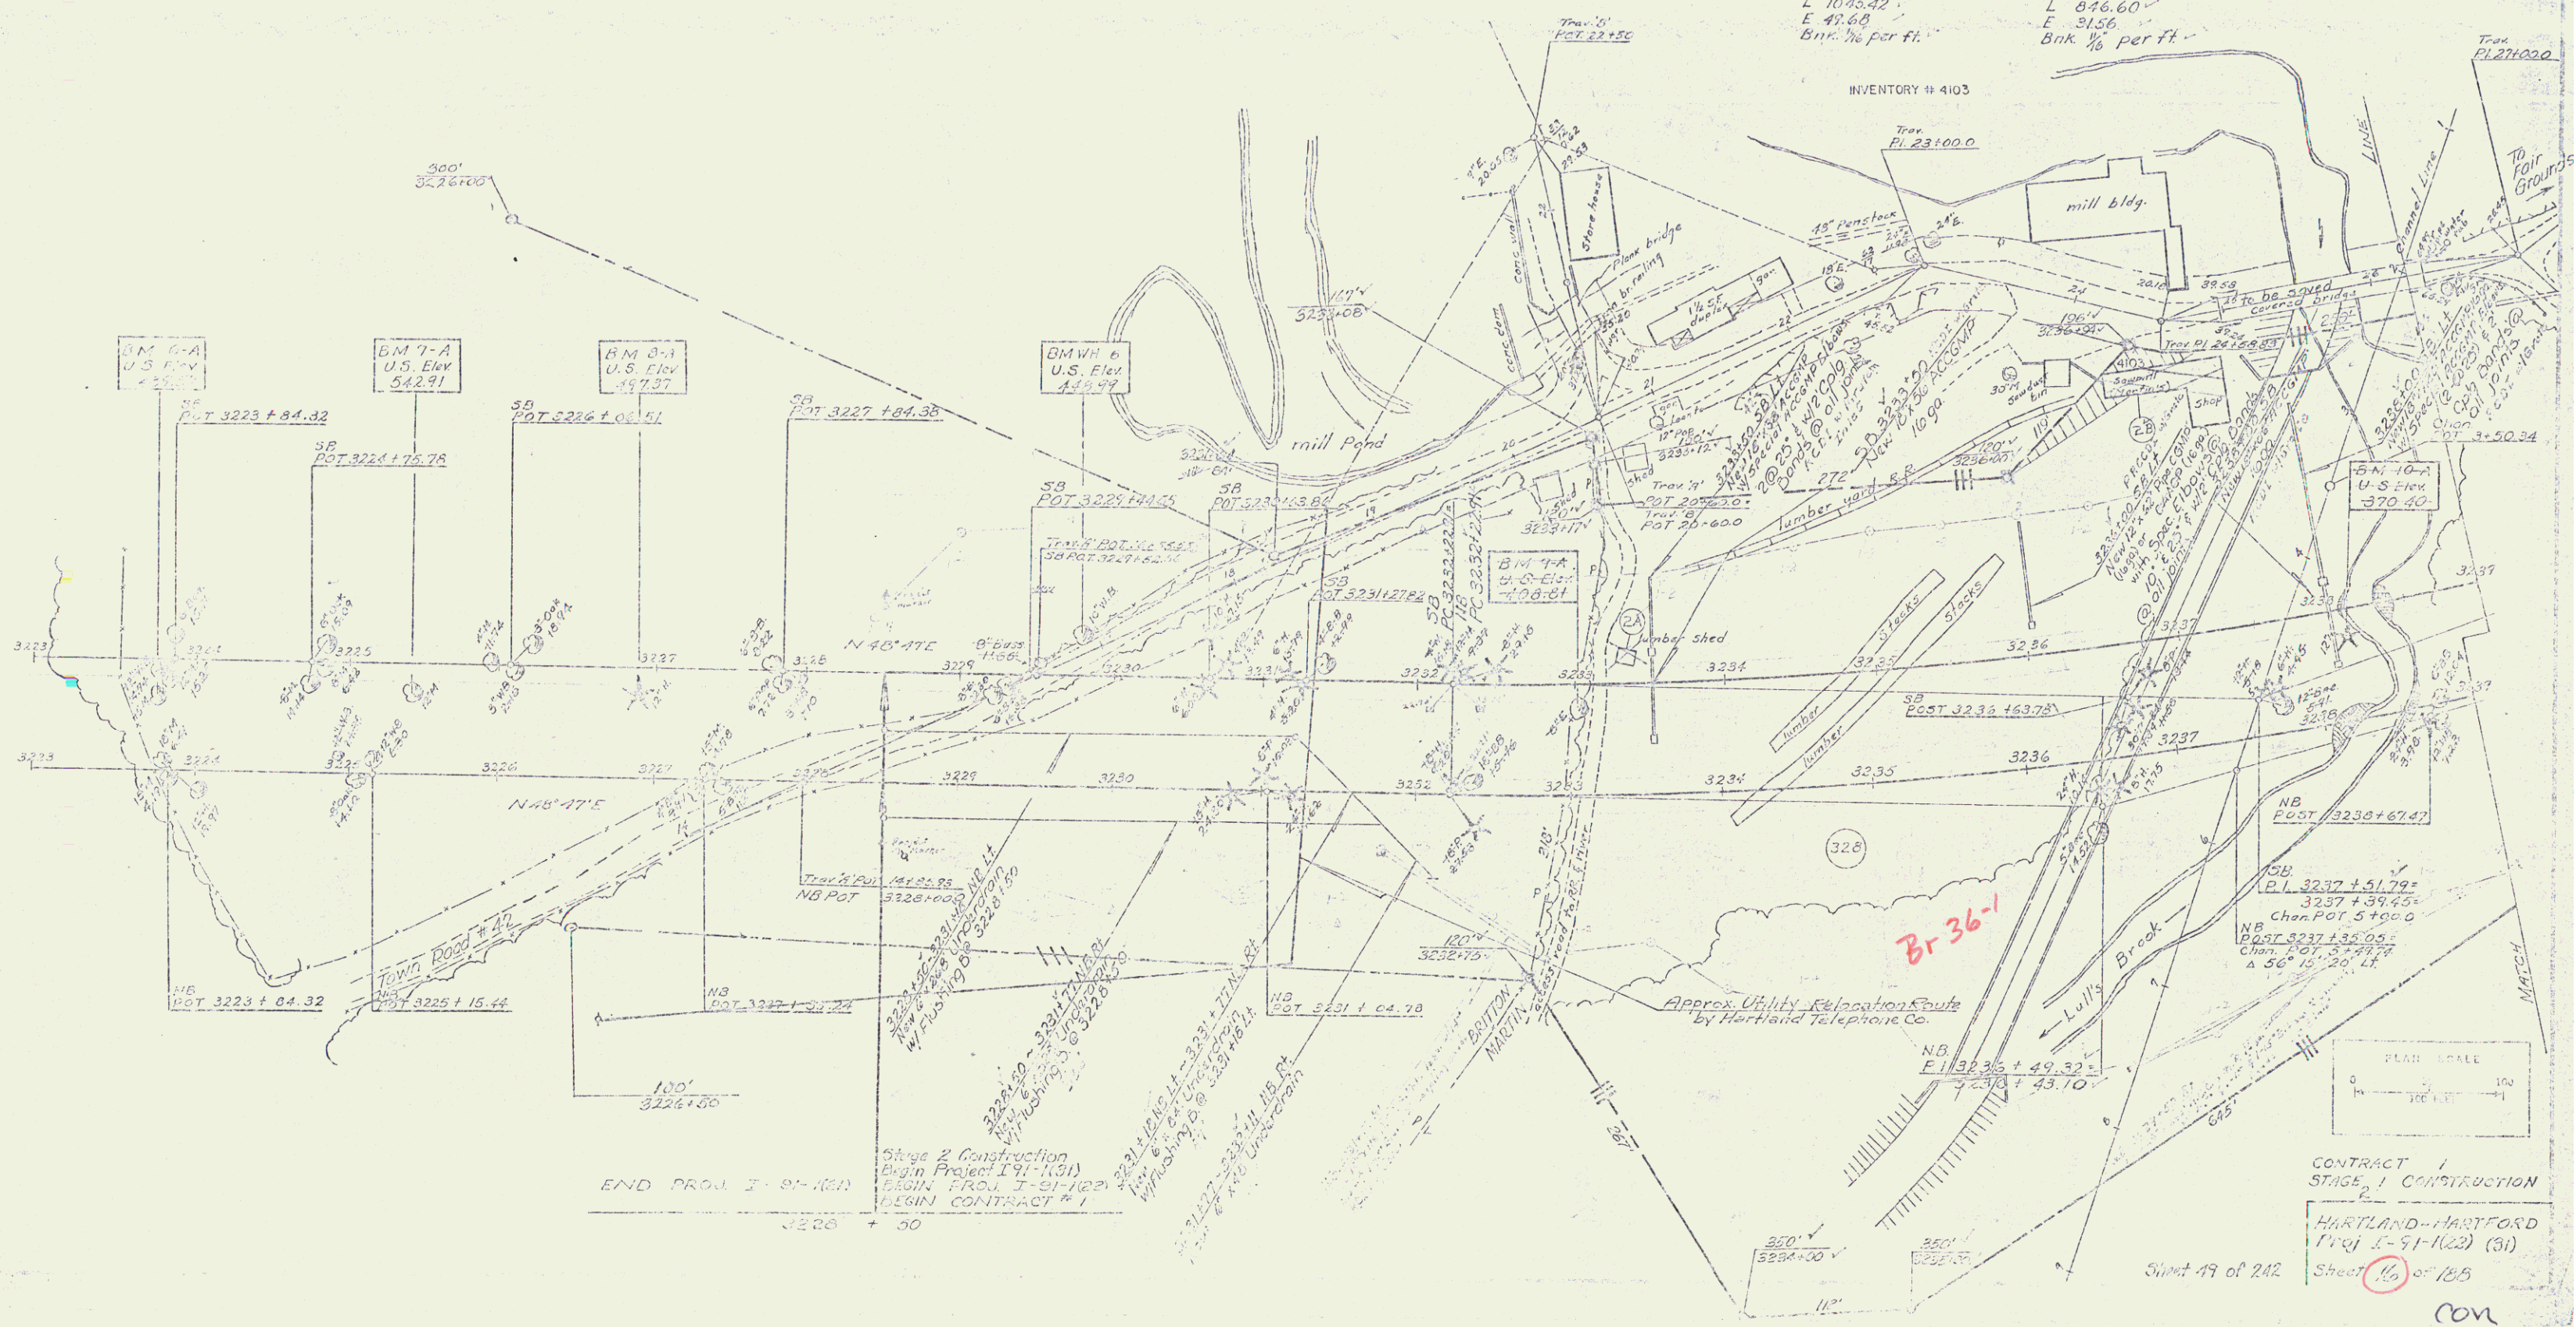

END PROJ. I - 91-102
3230 + 50

Stage 2 Construction
Begin Project I 91-102
Begin Proj. I - 91-102
Begin Contract # 1

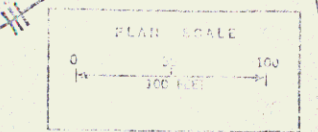

CONTRACT 1
STAGE 1 CONSTRUCTION

HARTLAND-HARTFORD
Proj. I-91-102 (51)

Sheet 16 of 18B

con

9