

Standard Scale  
 W/Side Posts Item 545-A  
 3246+50 - 3248+50 NB

THREE CALLE GUARD RAIL W/  
 STEEL POSTS - ITEM 5  
 3239+00 - 3242+24 NB-RT  
 3239+00 - 3241+88 SB-LT

\* BITUMINOUS CONCRETE CURB  
 ITEM 565  
 3239+00 - 3241+25 SB-LT  
 \*STAGE 2 CONSTRUCTION



SUB-BASE OF SAND, ITEM 202  
 3242+80 - 3254+75 NB  
 3245+75 - 3250+75 SB

MUCK EXCAVATION, ITEM 116  
 3250+75 - 3254+25 SB

JUTE MATTING ITEM 623  
 3242+00 - 3250+50 SB LT  
 3246+50 - 3251+00 SB RT  
 3243+50 - 3246+00 NB/L  
 3244+50 - 3251+00 NB/L  
 3247+75 - 3250+50 NB/L

DRILLING & BLASTING OF SOLID ROCK  
 SUBGRADE, MCD - ITEM 114  
 3242+00 - 3243+50 SB  
 3244+50 - 3248+50 NB  
 3246+50 - 3248+50 SB

PROPERTY LINE FENCE ITEM 563-B  
 3246+80 - 3255+00 SB-LT  
 3247+80 - 3254+00 NB-RT

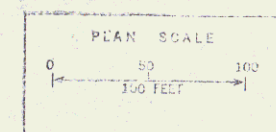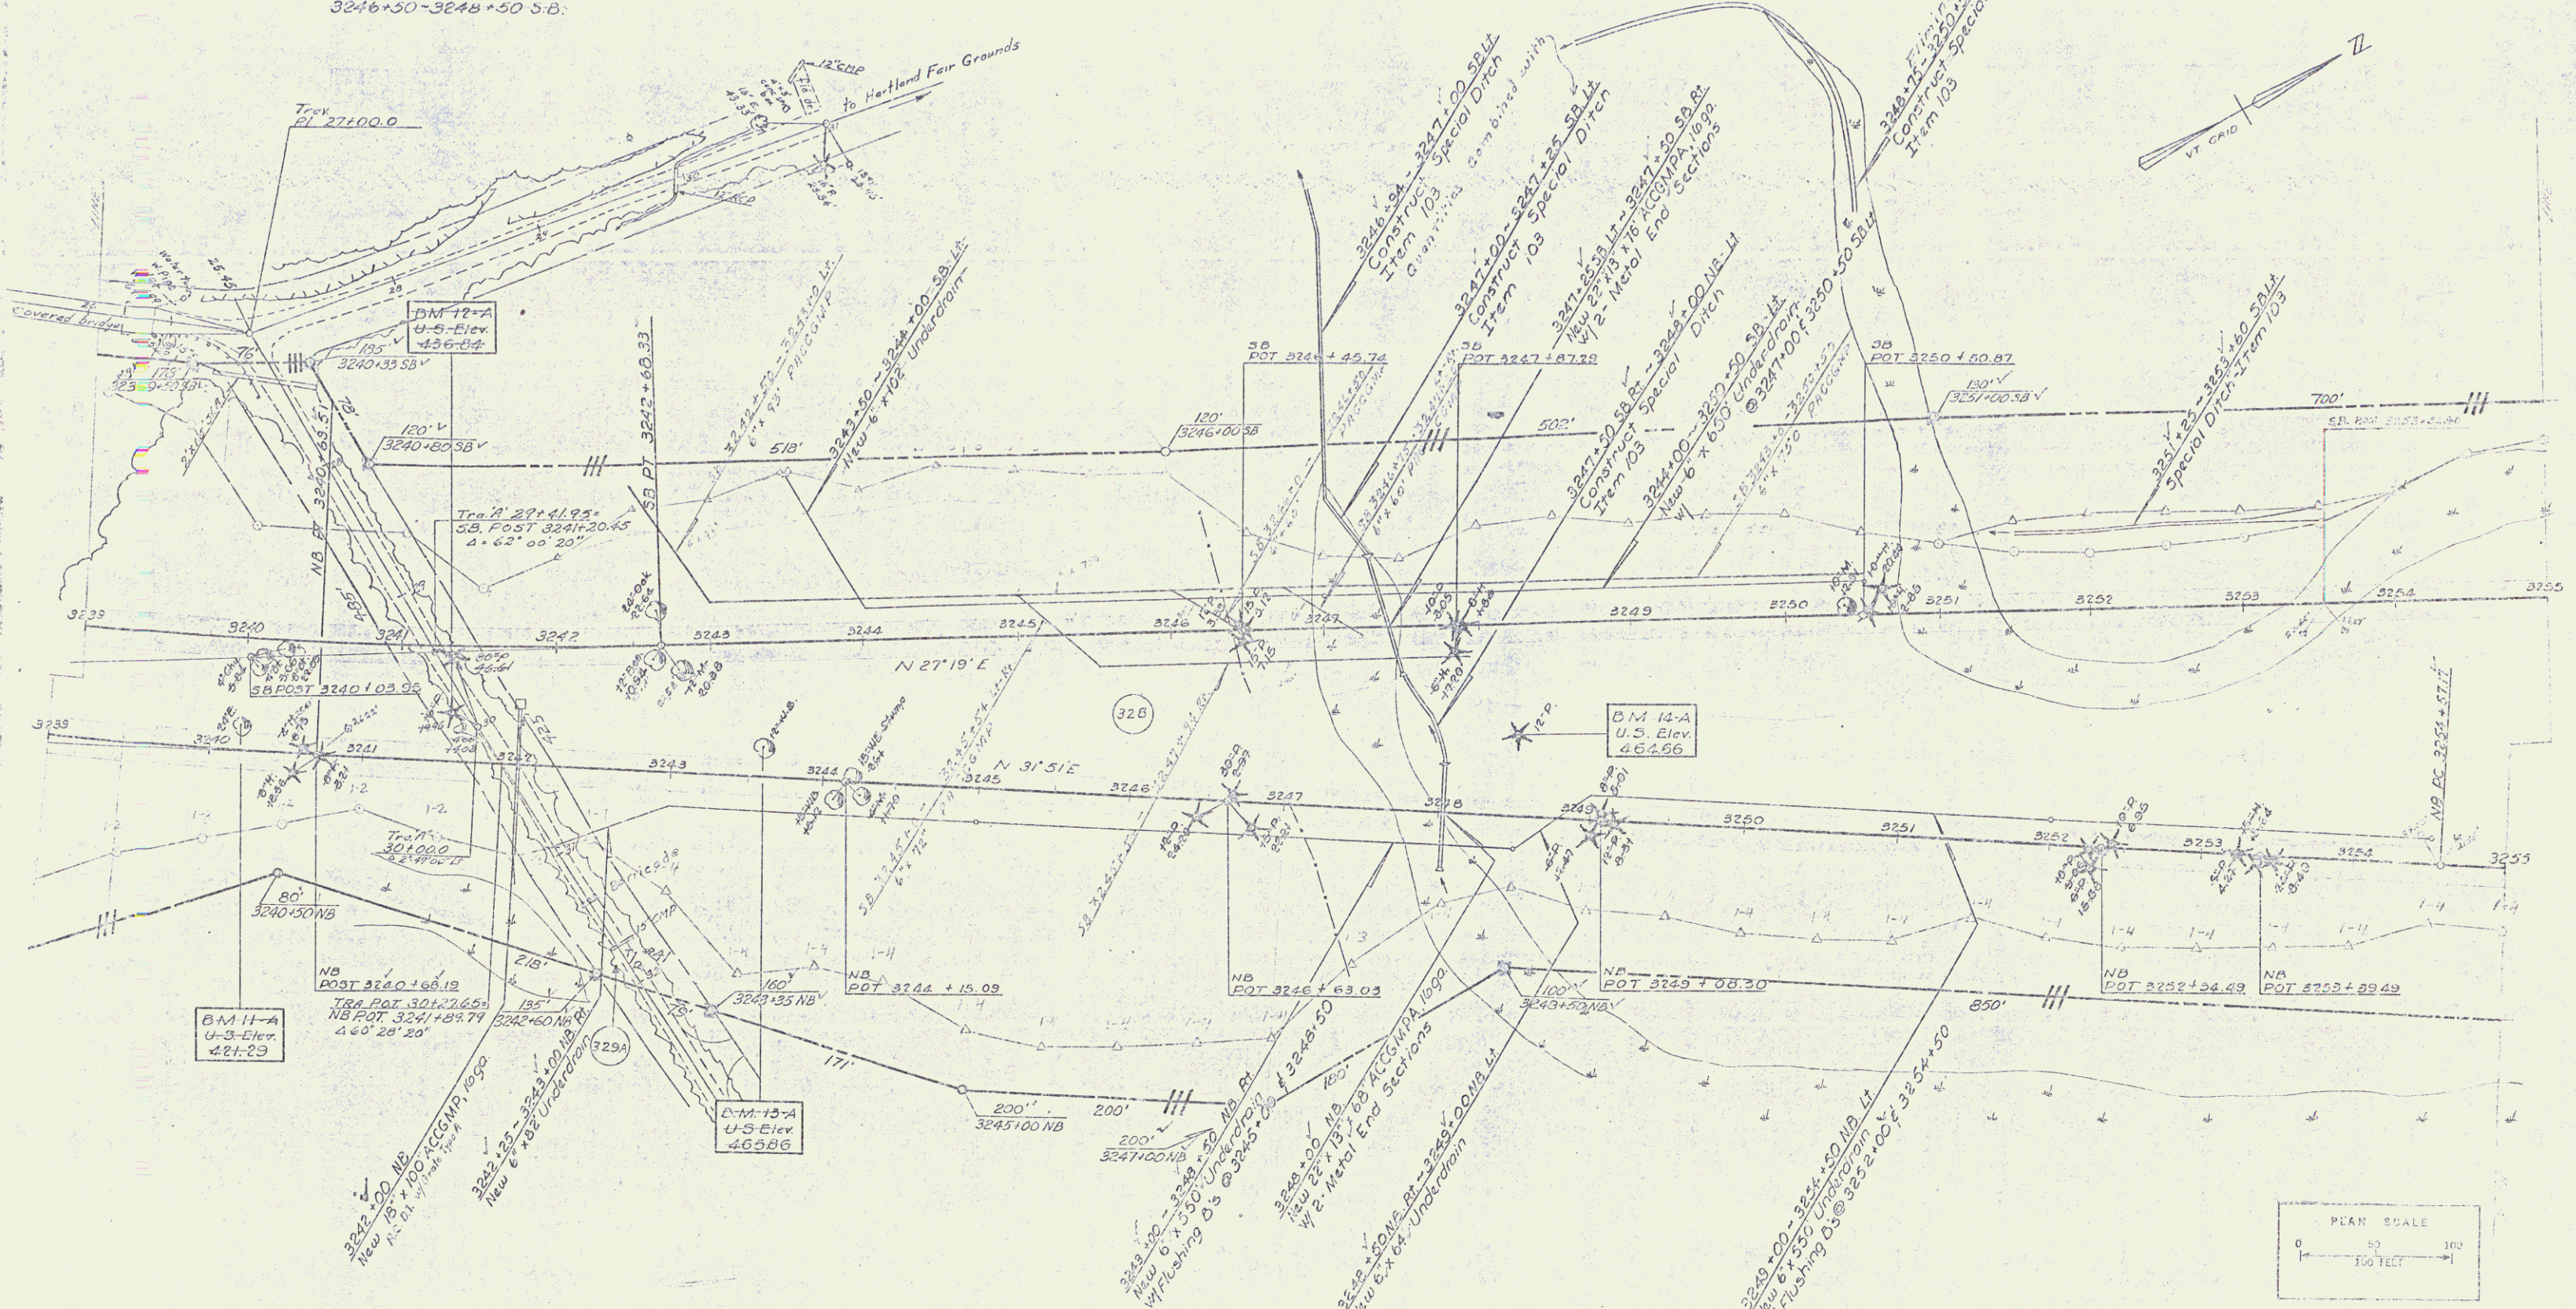

CONTRACT 1  
 STAGE 2 CONSTRUCTION  
 HARTLAND - HARTFORD  
 Proj. 2-91-122 (31)  
 Sheet 17 of 188  
 CONTROL OF ACCESS COMPLETE  
 ON THIS SHEET  
 Sheet 51 of 242

Con  
 10