




1/4" = 1' HORIZONTAL
1" = 10' VERTICAL
AS SHOWN

SUB-AREA OF SAND ITEM 202
3250+75 - 3259+75 NB
3250+75 - 3263+40 SB
3250+75 - 3271+00 NB

MUCK EXCAVATION ITEM 116
3250+75 - 3259+75 SB
3264+75 - 3265+75 NB
3265+75 - 3269+75 SB

PROPERTY LINE FENCE ITEM 563-B
3250+00 - 3258+00 SB RT
3263+00 - 3271+00 SB LT
3257+00 - 3271+00 NB RT

$\Delta 30^\circ 07' 30''$ LT
D 10'
R 072.00'
T 158.60'
L 309.61'
E 21.56'

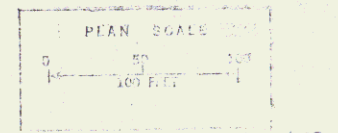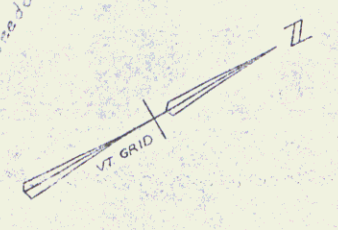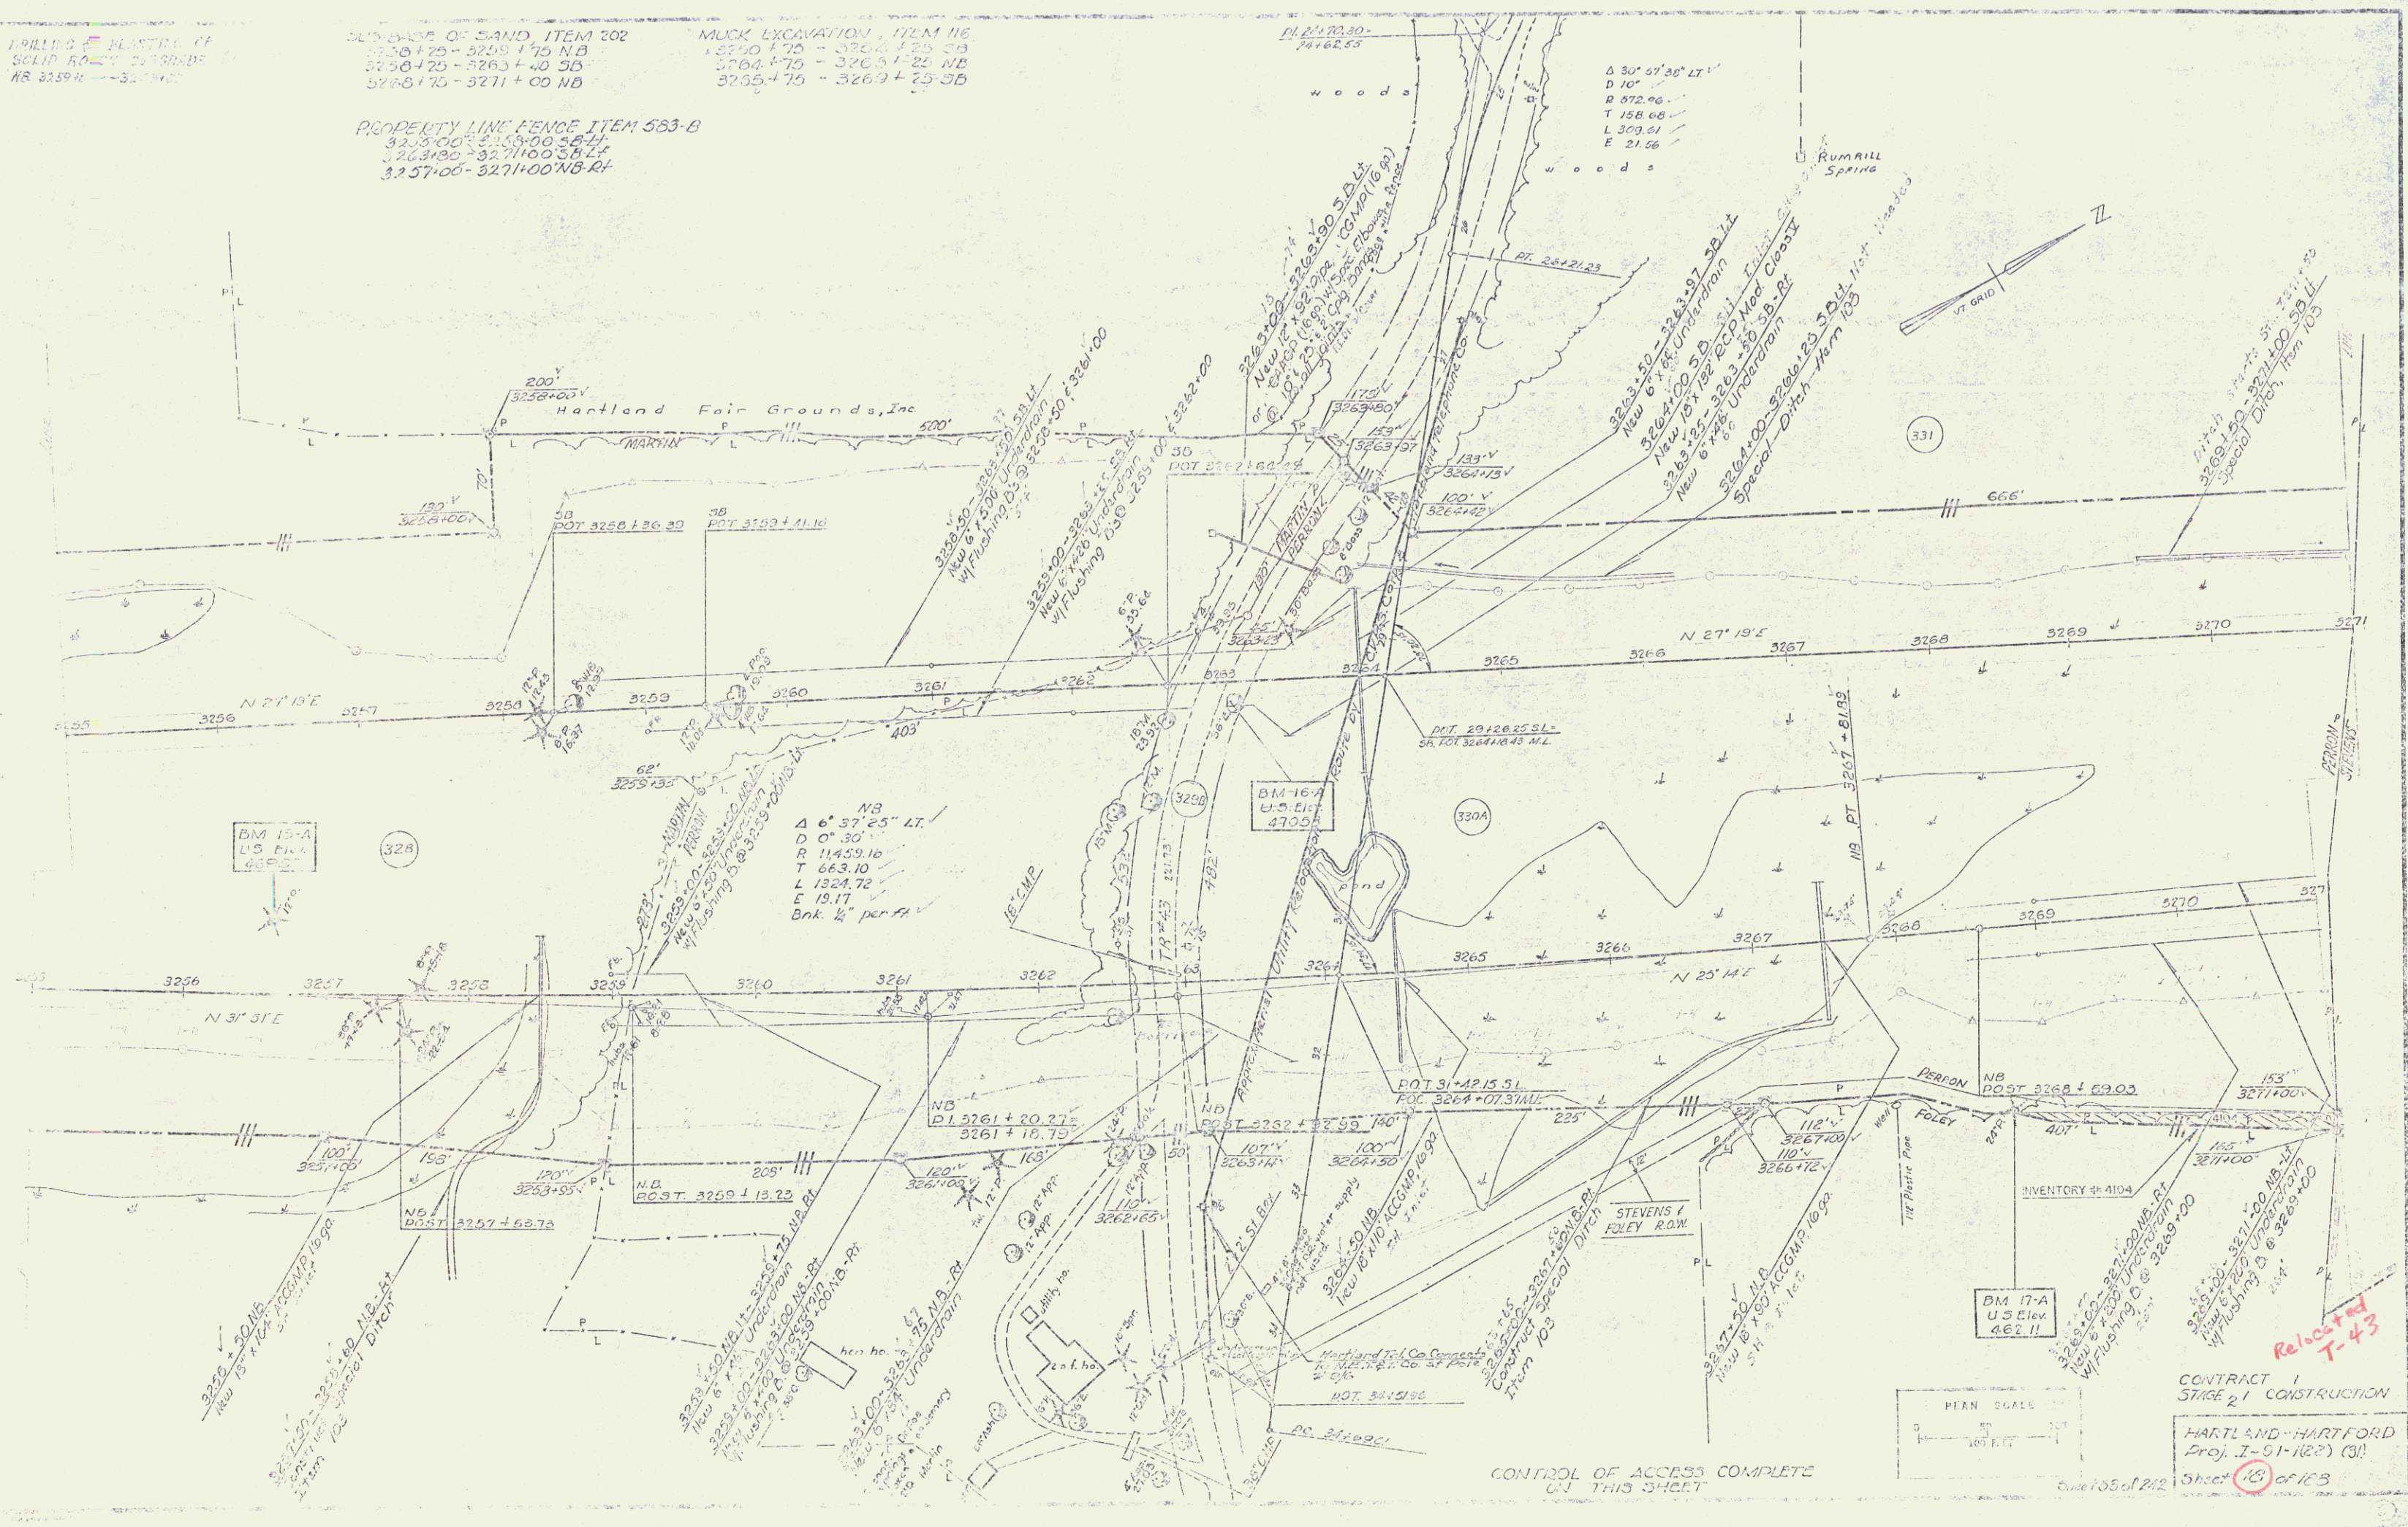

CONTRACT 1
STAGE 2,1 CONSTRUCTION
HARTLAND-HARTFORD
Proj. I-91-1122 (31)
Sheet 15 of 163

RELOCATED
T-43