

*STEEL PLANK GUARDRAIL W/
STEEL POSTS - ITEM 543-A
3272+00-3274+00 NB-LT
3272+00-3274+00 NB-RT
3273+00-3274+00 NB-LT
3273+00-3274+00 NB-RT

*THREE CABLE GUARD RAIL W/
STEEL POSTS - ITEM 543-B
3275+00-3277+00 NB-RT
3275+00-3277+00 SB-RT
3276+00-3277+00 NB-RT
3277+00-3279+00 NB-LT
3277+00-3279+00 NB-RT
DRILLING & BLASTING OF SOLID ROCK
SUBGRADE, MOD. ITEM 114
3274+00-3277+00 NB-RT
3277+00-3279+00 NB-RT

DENOLITION & REMOVAL OF BUILDING
ITEM 586
3274+00 NB-LT

*BITUMINOUS CONCRETE CURB
ITEM 555
3275+00-3278+00 SB-RT
3278+00-3281+00 NB-RT

PROPERTY LINE FENCE ITEM 553-Z
3274+00-3277+00 SB-LT
3274+00-3277+00 NB-RT
3278+00-3281+00 SB-LT
3278+00-3281+00 NB-RT


*STAGE 2 CONSTRUCTION

STONE FILL FOR SLOPE PROTECTION
ITEM 522
3279+75-3279+75 NB-RT
3271+00-3275+75 NB

SUB-BASE OF SAND, ITEM 202
3271+00-3275+75 NB

JUTE MATTING, ITEM 625
3275+25-3275+75


LIST OF SHEETS - BIDE ARCH @ STA. 3284+00 NB.
BR-1 DETAILS OF PIPE ARCH
BR-2 BORING SHEET
BR-3 TO BR-7 CHANNEL SECTIONS

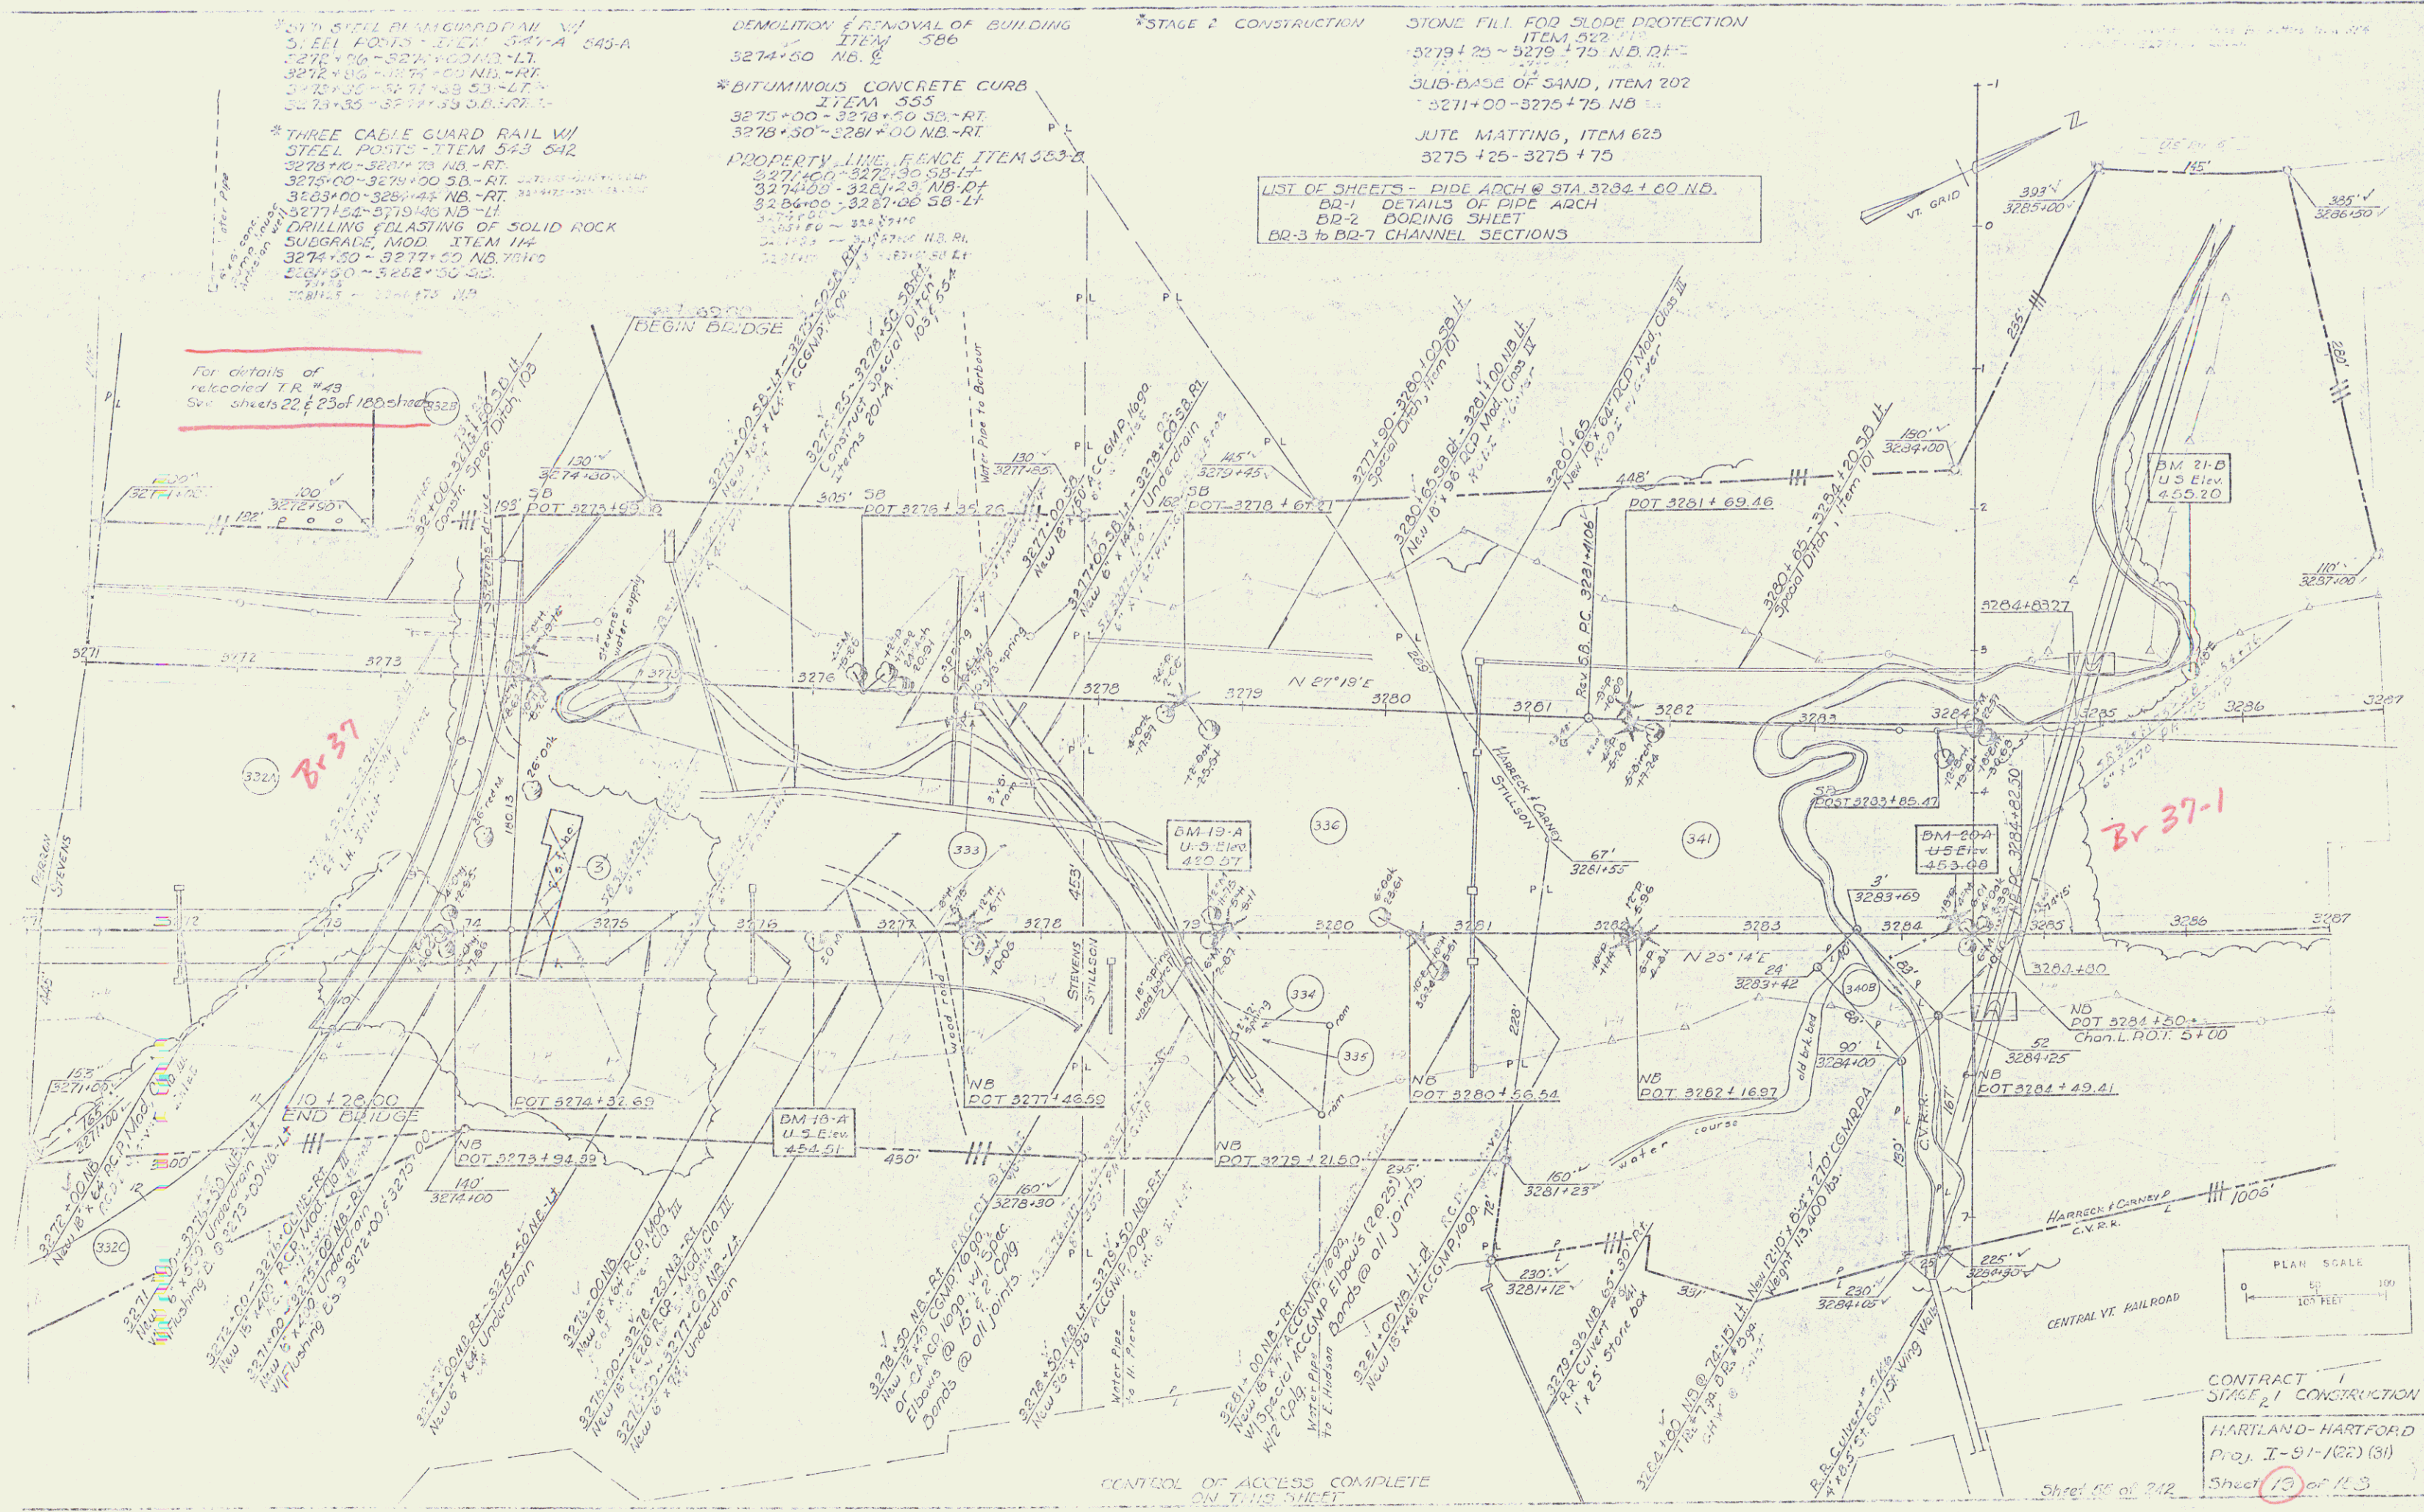

For details of
relocated TR #43
See sheets 22 & 23 of 180 sheet 3223

Br-37

Br-37-1

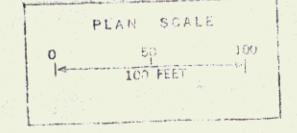

CONTRACT 1
STAGE 2 CONSTRUCTION
HARTLAND-HARTFORD
Proj. I-91-102 (31)
Sheet 13 of 13

CONTROL OF ACCESS COMPLETE
ON THIS SHEET