



STONE FILL FOR E.A.W. PROTECTION
ITEM 522
3284+45 NB LT - 3285+45 MB LT
3291+90 NB RT - 3292+90 MB RT

THREE CABLE GUARD RAIL W/
TREE 20370 - 771 M 343 542
3287+00 - 3288+75 NB - RT
3289+45 - 3291+00 NB - LT
3289+24 - 3290+60 SB - RT

PROPERTY LINE FENCE ITEM 563-B
3287+00 - 3303+00 SB - LT
3287+00 - 3303+00 NB - RT

* BITUMINOUS CONCRETE CURB
ITEM 553
3289+50 - 3291+00 NB - LT

* STAGE 2 CONSTRUCTION

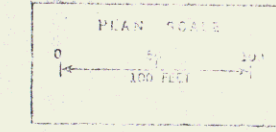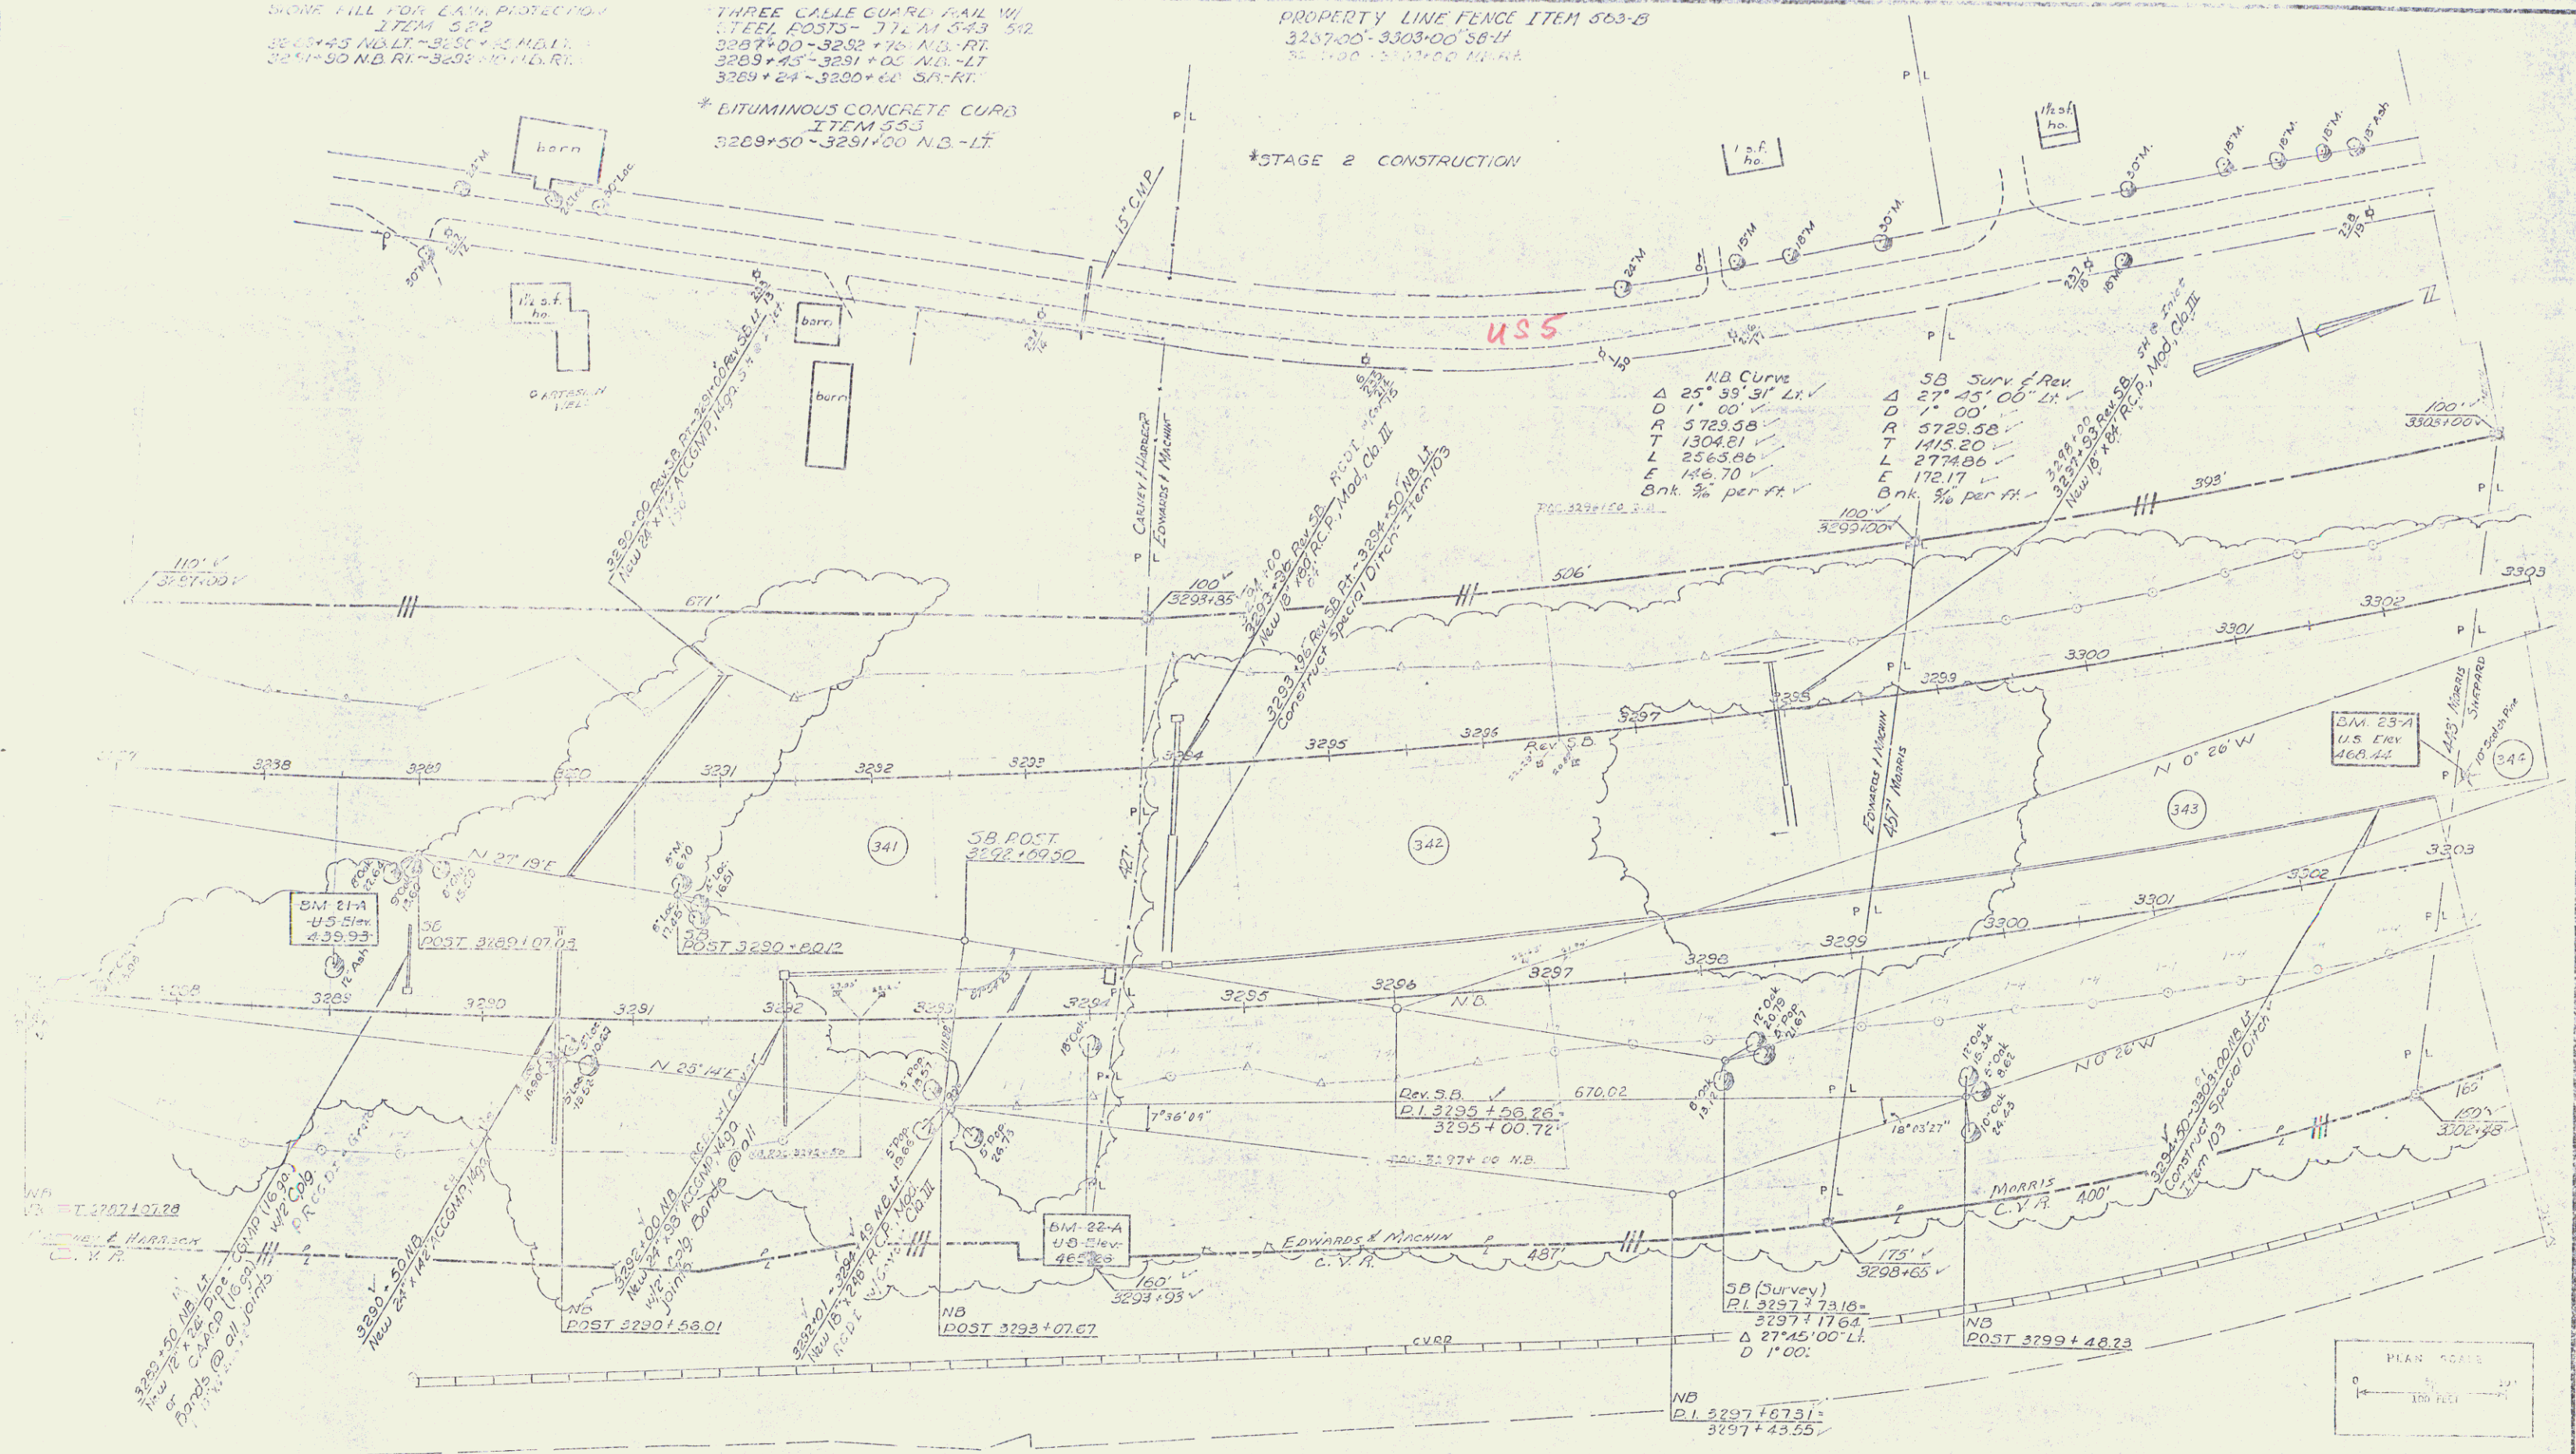

CONTROL OF ACCESS COMPLETE
ON THIS SHEET

CONTRACT 1
STAGE 1 CONSTRUCTION
HARTLAND-HARTFORD
Proj. I-91-(K2) (01)
Sheet 20 of 188
Sheet 57 of 212