

① N.B. Curve
 Δ 23° 59' 31" Lt
 D 1' 00' 00"
 R 5729.58
 T 1304.61
 L 2365.06
 E 146.58
 Bnk. 3/4' per ft

② S.B. Curve
 Δ 27° 43' 00" Lt
 D 1' 00' 00"
 R 5729.58
 T 1415.20
 L 2774.66
 E 172.17
 Bnk. 3/4' per ft

③ N.B. Curve
 Δ 5° 0' 12" Lt
 D 0' 30' 00"
 R 11433.16
 T 502.32
 L 11007.00
 E 11.00
 Bnk. 1/2' per ft

④ S.B. Curve
 Δ 9° 53' 40" Lt
 D 1' 00' 00"
 R 25729.38
 T 495.86
 L 989.45
 E 2146
 Bnk. 3/4' per ft


⑤ N.B. Curve
 Δ 43° 57' 00" Rt
 D 1' 00' 00"
 R 5729.58
 T 2295.03
 L 4562.23
 E 241.52
 Bnk. 3/4' per ft

⑥ S.B. Curve
 Δ 40° 25' 01" Rt
 D 1' 00' 00"
 R 4533.66
 T 2064.00
 L 3678.69
 E 443.27
 Bnk. 3/4' per ft

⑦ U.S. Rt. 5 Curve
 Δ 53° 34' 00" Lt
 D 3' 30' 00"
 R 14571.02
 T 2264.32
 L 11304.43
 E 196.73
 Bnk. 1/2' per ft

⑧ T.D. #78 Curve
 Δ 18° 30' 00" Rt
 D 6' 00' 00"
 R 9549.93
 T 155.52
 L 308.53
 E 12.30
 Bnk. 1/2' per ft

⑨ T.D. #78 Curve
 Δ 58° 34' 00" Lt
 D 12' 00' 00"
 R 4774.7
 T 168.61
 L 324.17
 E 28.90
 Bnk. 3/4' per ft

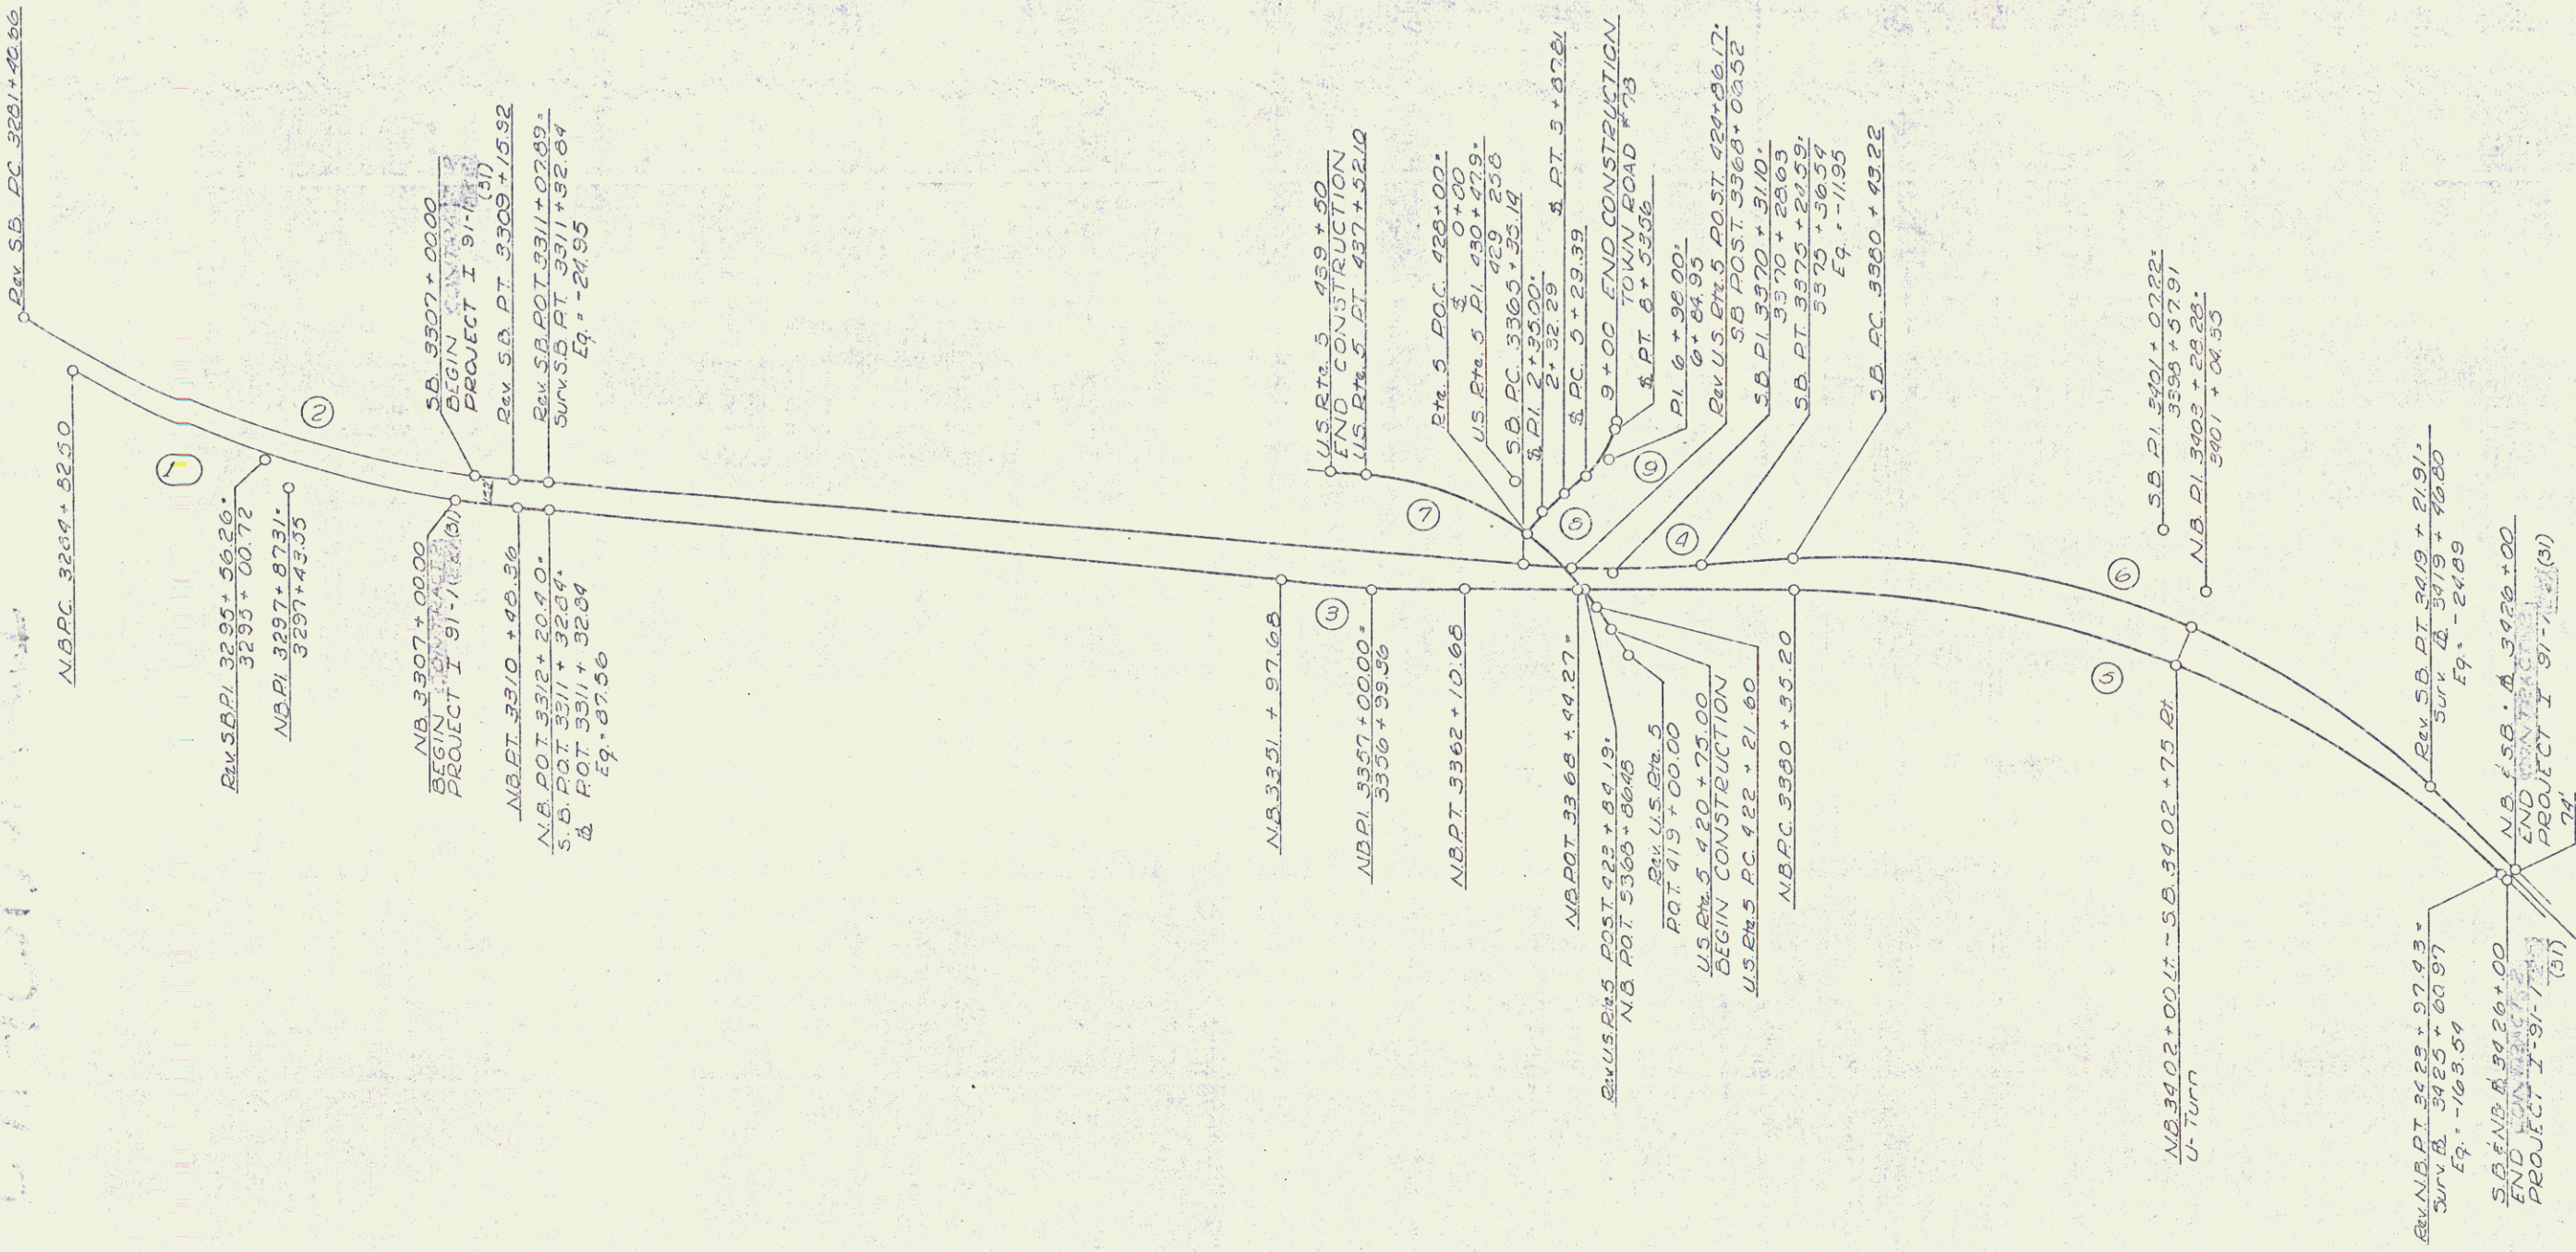

57-160-100-11

14

Stage 2 Construction
 HARTLAND-HARTFORD
 I 91-11 (31)
 Jan. 83 Scale 1"=500'
 Sheet 3 of 222