
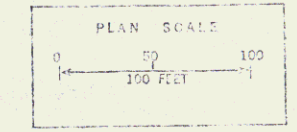


DEMOLITION and REMOVAL
of BUILDINGS, Item 506
N.B. 3333+00 LT.
N.B. 3333+65 RT.
S.B. 3330+00 LT.
S.B. 3332+63 LT.

PROPERTY LINE FENCE
W/STEEL POSTS, ITEM 533-D
S.B. 3319+00'-3335+00' LT.
N.B. 3319+00'-3335+00' RT.

JUTE MATTING, ITEM 623
3320+50-3321+00 N.B. LT.
3329+00-3330+00 N.B. LT.

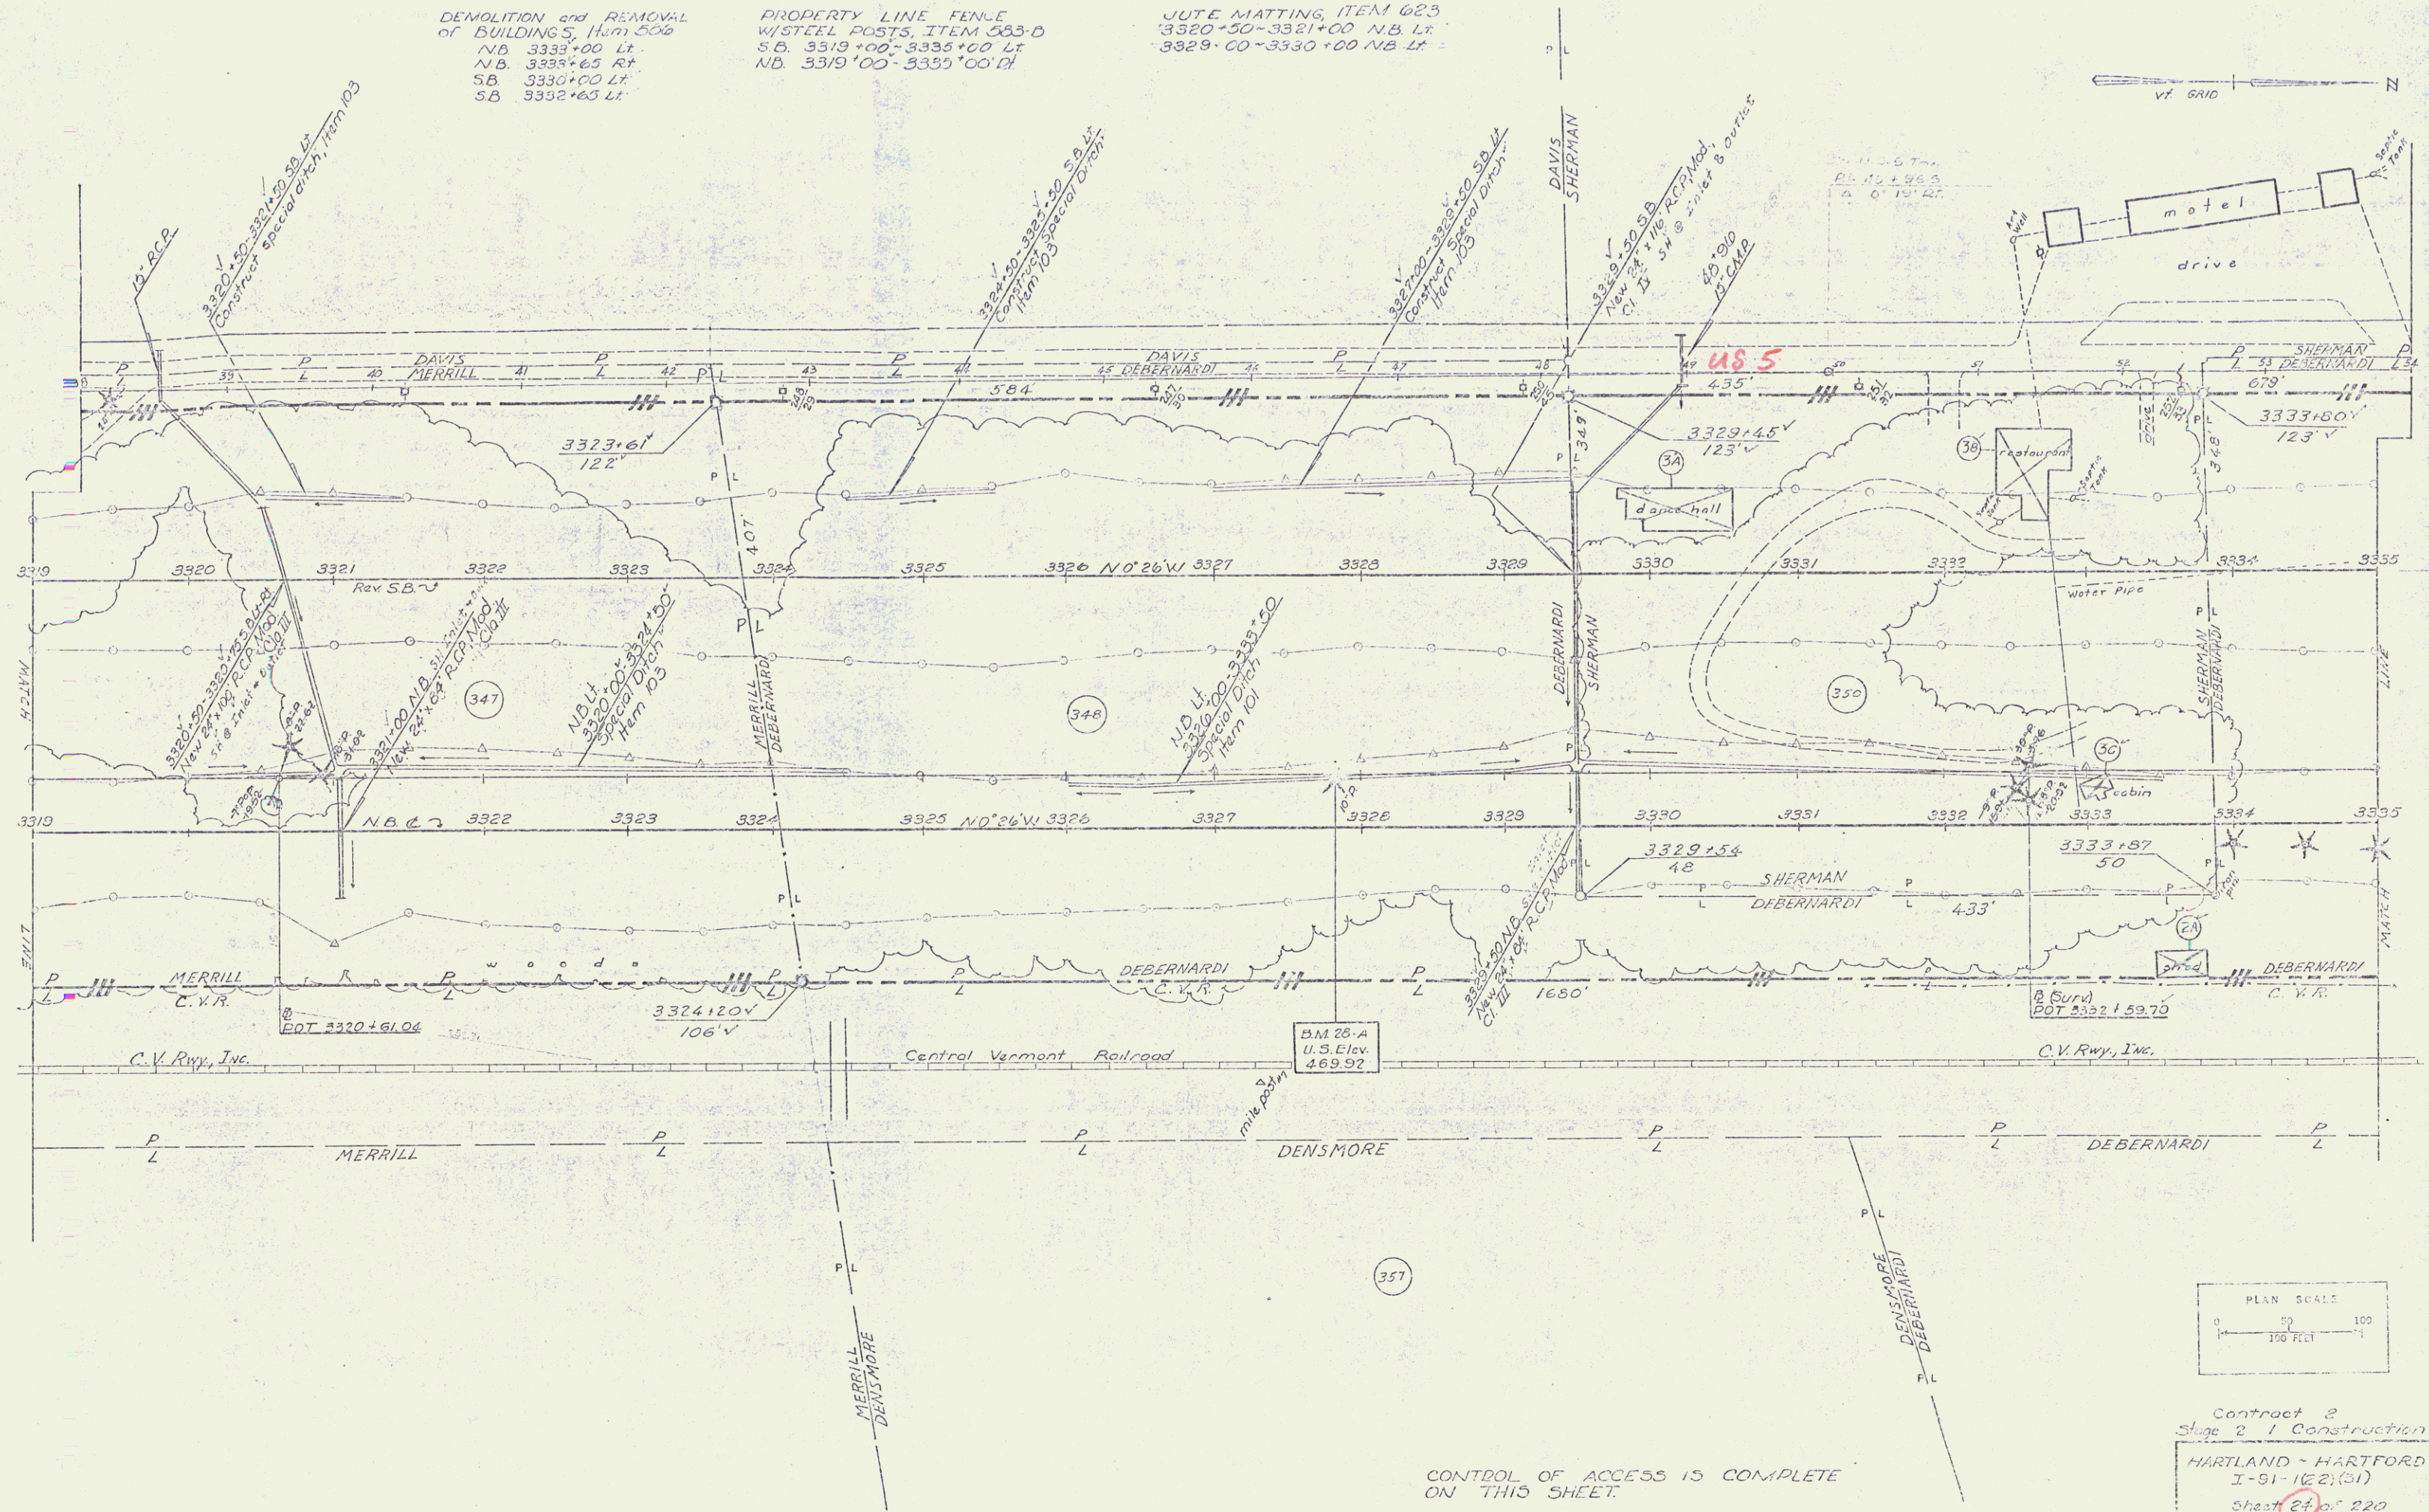

Contract 2
Stage 2 Construction
HARTLAND - HARTFORD
I-91-162(21)
Sheet 24 of 220
Sheet 63 of 222