

PROPERTY LINE FENCE  
W/ STEEL POSTS, ITEM 533-D  
3351+00 - 3366+00 S.B. LT.  
3351+00 - 3366+00 N.B. RT.

STANDARD STEEL BEAM GUARD  
RAIL W/ STEEL POSTS, ITEM 547-A 545-A  
3366+53' - 3367+00 S.B. LT.  
437+50


DEMOLITION and REMOVAL  
of BUILDING, ITEM 500  
N.B. 3361+75  
S.B. 3362+80  
S.B. 3363+90 Lt-sold

BITUMINOUS CUTTER, USING  
ITEM 534  
3363+50 - 3364+00 S.B. RT.  
3364+50 - 3364+10 N.B. LT.

JUTE MATTING, ITEM 623  
3363+50 - 3364+00 N.B. LT.

\*STAGE 2 CONSTRUCTION  
440+00  
75'

CONTROL OF ACCESS IS COMPLETE  
ON THIS SHEET.

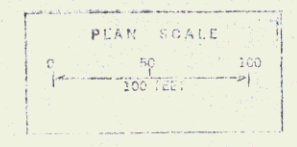

Contract 2  
Stage 2 Construction  
HARTLAND - HARTFORD  
I-91-102(3)  
Sheet 25 of 20  
Sheet 67 of 712