



* STEEL GUIDE POSTS
ITEM 545-D 547-B
S.D. 3353+00-3367+40 R/L
* STAGE 2 CONSTRUCTION

DRILLING and BLASTING of
SOLID ROCK ITEM 114
S.B. 3363+00-3382+80 L/R


* THREE CABLE GUARD RAIL
w/ STEEL POSTS ITEM 543 542
N.B. 3383+00-3384+50 L/R
N.B. 3391+46-3394+50 R/L
S.B. 3395+00-3397+44 L/R

PROPERTY LINE FENCE ITEM 503-B
N.B. 3383+00 R/L - 3399+00 L/R
S.B. 3383+00 R/L - 3393+00 L/R

Billboard Concrete Top
4.8' 3391+71-3392+14 R/L
2.8' 3391+71-3392+14 R/L

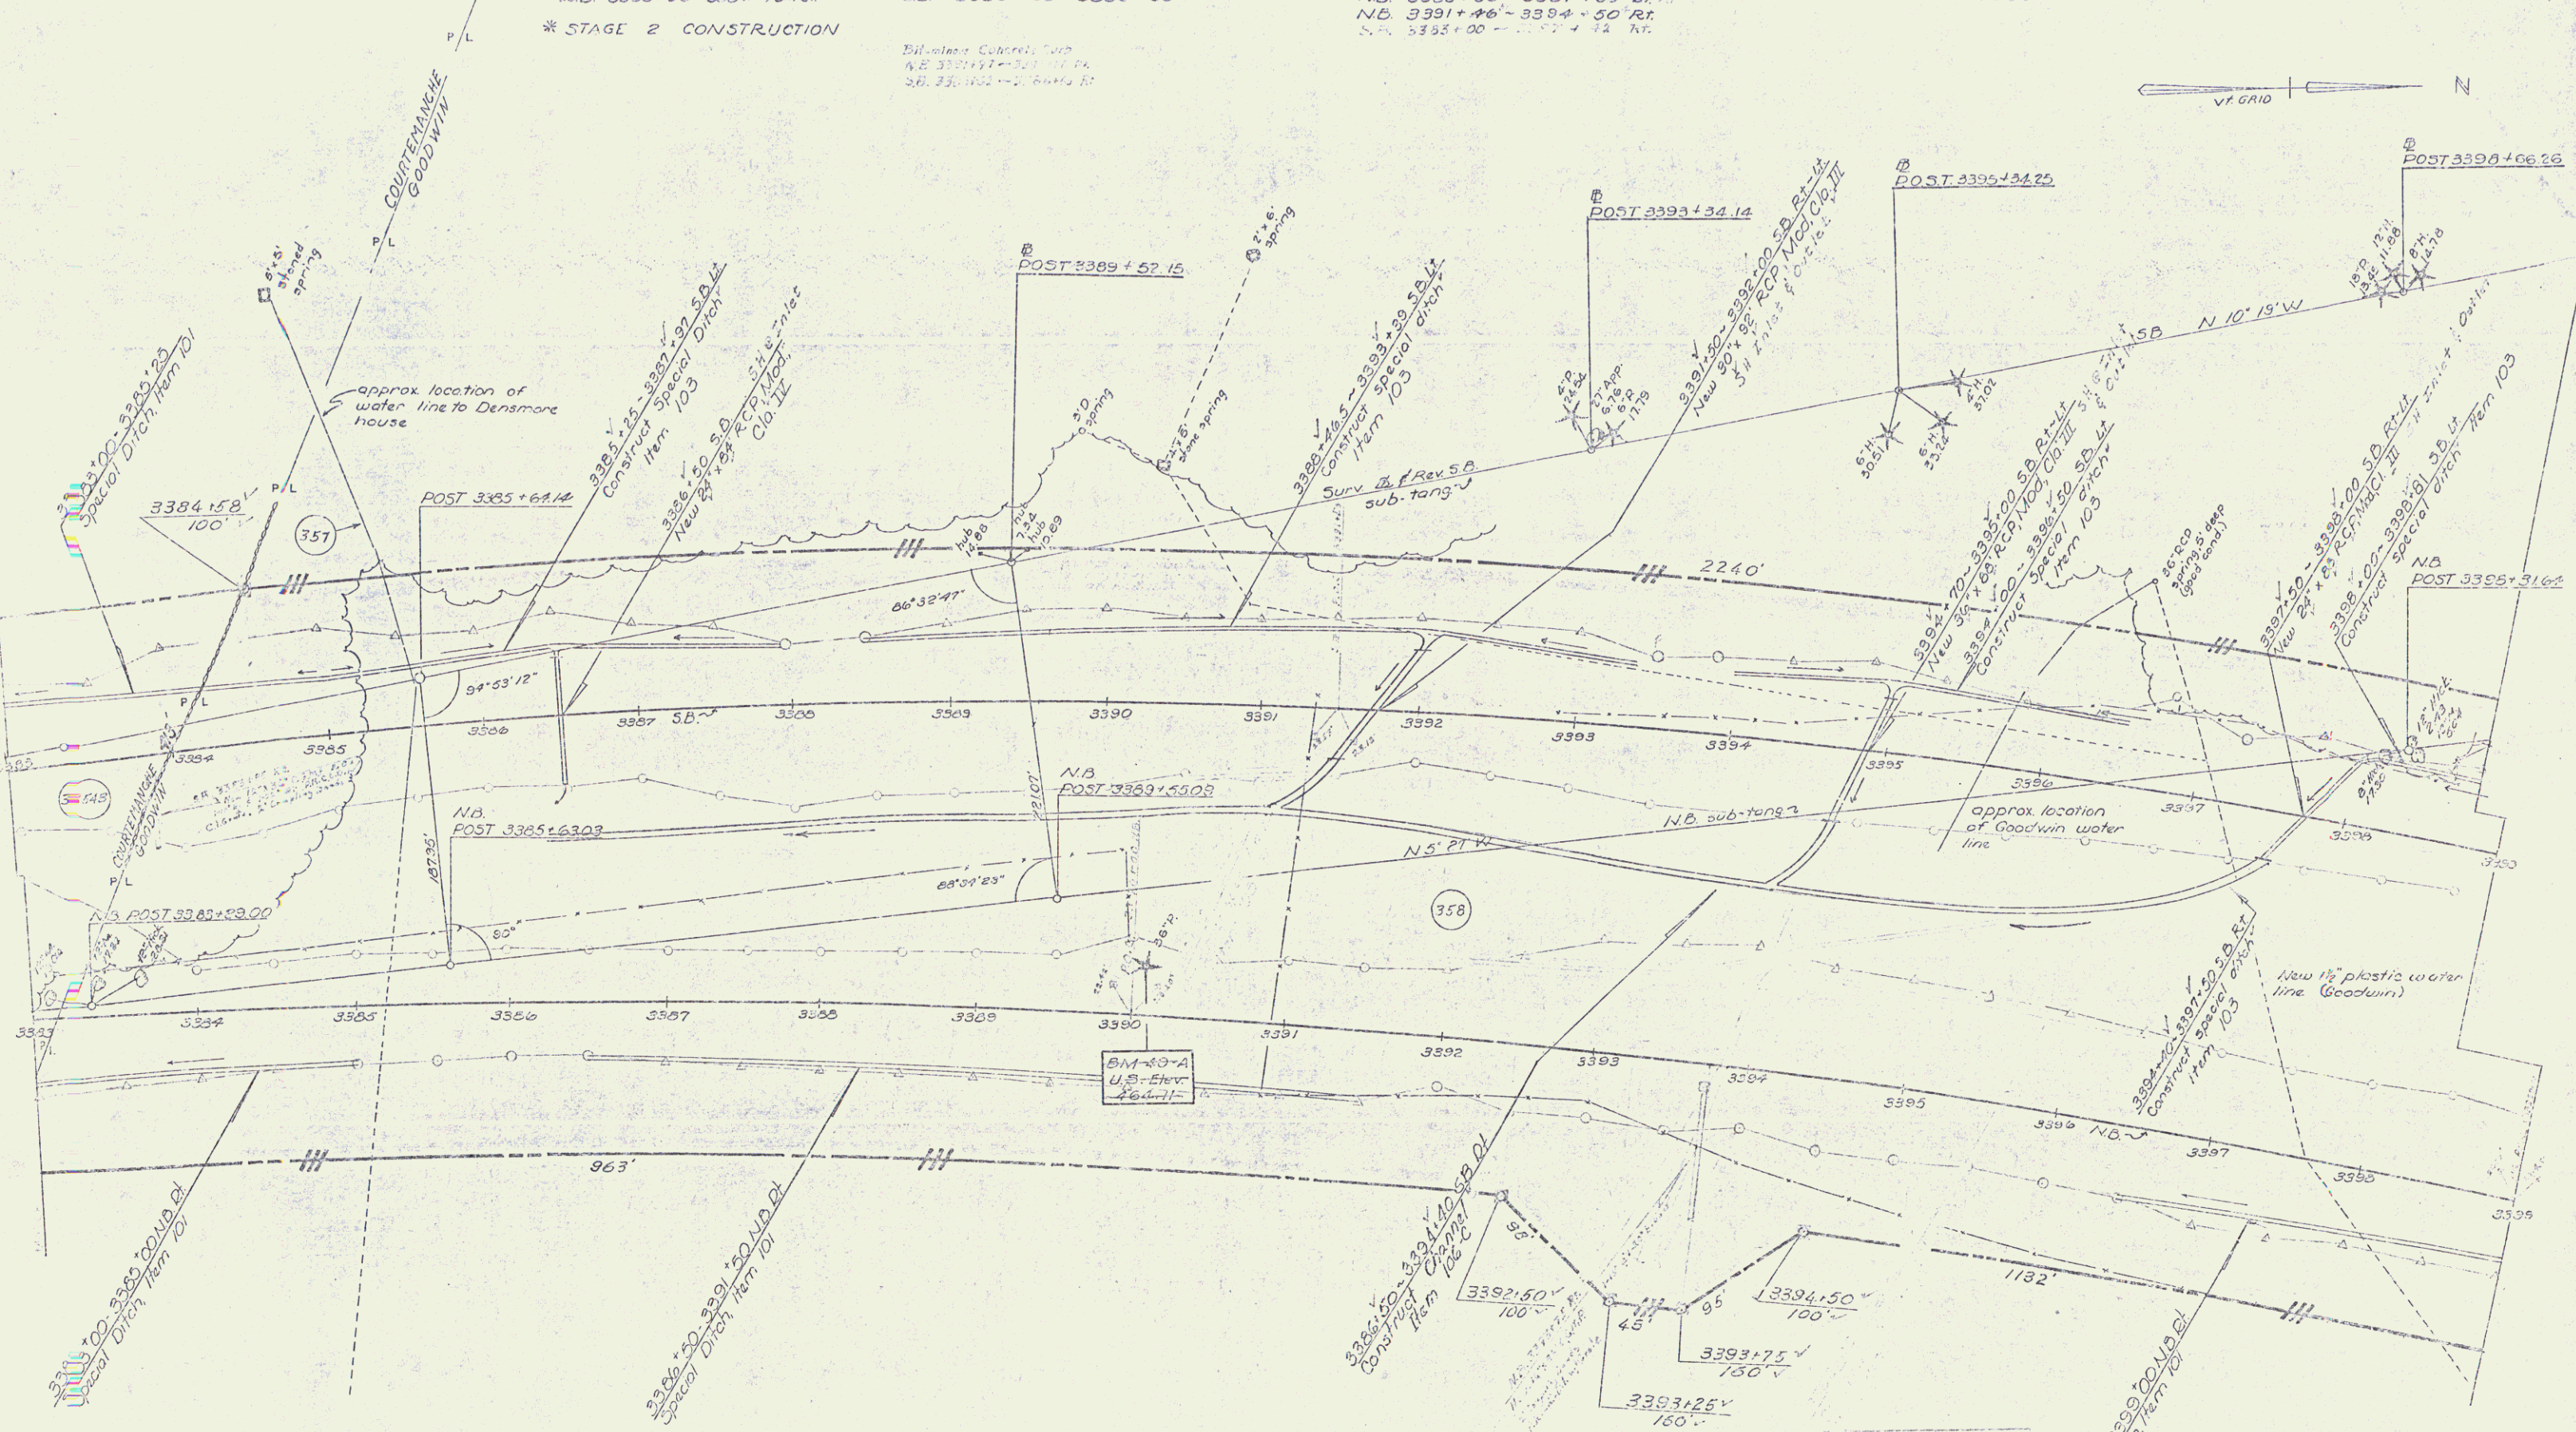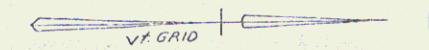

CONTROL OF ACCESS IS COMPLETE
ON THIS SHEET

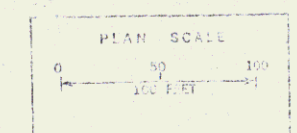

Contract 2
Stage 2 Construction
HARTLAND-HARTFORD
I-91-1(22)(31)
Sheet 52 of 52
Sheet 71 of 72