

RIPRAP FOR BANK PROTECTION
ITEM 520
3407+40 ~ 3408+00 NB. RT.

STONE FILL FOR BANK PROTECTION
ITEM 522
3406+95 ~ 3407+05 S.B. LT.
3406+00 ~ 3407+10 NB. RT.

DRILLING and BLASTING of SOLID
ROCK SUBGRADE ITEM 114
3407+25 ~ 3408+25 S.B.
3412+25 ~ 3413+00 S.B.
PROPERTY LINE FENCE ITEM 503-B
NB 3399+00 LT - 3413+00 RT
SB 3399+00 LT - 3413+00 LT

*STANDARD STEEL BEAM GUARD RAIL
w/ STEEL POSTS, ITEM 517-A
3407+10 ~ 3408+20 S.B. RT.
3406+40 ~ 3407+52 S.B. LT.

BITUMINOUS GUTTER, USING ITEM 554
3406+20 ~ 3406+85 S.B. LT.

JUTE MATTING, ITEM 623
3405+00 ~ 3406+00 NB. LT.

*THREE CABLE GUARD RAIL
w/ STEEL POSTS ITEM 513 512
3406+00 ~ 3413+00 NB. RT.
3406+50 ~ 3407+46 NB. LT.

*BITUMINOUS CONCRETE CURB
ITEM 555
3406+00 ~ 3409+70 NB. RT.


*CONSTRUCT U-TURN 3410+00 V
3402+75 S.B. LT.
3402+00 NB. LT.

SUB-BASE of SAND
ITEM 202
3408+25 ~ 3413+00 S.B.

*STAGE 2 CONSTRUCTION

S.B. Curve Data
Δ 76° 25' 01" Rt.
D 1' 15"
R 4583.66
T 2064.00
L 3978.69
E 443.27
bank 2" per ft.

N.B. Curve Data
Δ 73° 37' 20" Rt.
D 1'
R 3729.50
T 2293.03
L 4362.23
E 411.52
bank 2" per ft.

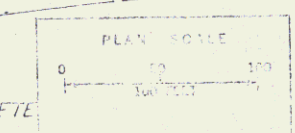

CONTROL OF ACCESS IS COMPLETE
ON THIS SHEET

Contract 2
Stage 21 Construction
HARTLAND-HARTFORD
I-91-1(22)(31)
Sheet 51 of 220
Sheet 11 of 212