

THIS CABLE GUARD RAIL WITH STEEL POSTS, ITEM 543 542  
 NORTHBOUND 3426100 TO 3431400 SOUTHBOUND 3428425 TO 3421153 1/2"


PROPERTY LINE FENCE WITH STEEL POSTS, ITEM 583-D  
 NORTHBOUND 3448400 TO 3451400 SOUTHBOUND 3405400 TO 3434400

SUB-EASE OF GRAVEL, ITEM 201-A MOD.  
 SOUTHBOUND 3470440 LT TO 3431400 LT

JUTE MILLING, ITEM 523  
 MED. 3420475 TO 3431400  
 100'

POOR ORIGINAL COPY

CONTROL OF ACCESS IS COMPLETE ON THIS SHEET  
 \* DENOTES STAGE 2 CONSTRUCTION  
 STAGE 1 CONSTRUCTION  
 12 112

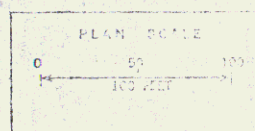

CONTRACT 3  
 Sheet 10 of 222