

STONE FILL FOR ROAD, ITEM 522
NB 3474+00 - 3474+00 RT

DEMOLITION AND REMOVAL OF BUILDING, ITEM 550
NB 3474+50 RT

BITUMINOUS CONCRETE CURB, ITEM 555
SB 3476+00 - 3476+00 LT

JUTE MATTING, ITEM 623
SB 3476+00 - 3476+00 MED

DRILLING AND BLASTING OF SOLID
ROCK SUBGRADE, ITEM 84
3477+50 - 3478+00

TREATED TIMBER CURB, ITEM 555
NB 3478+00 - 3478+00 RT


THREE CABLE GUARD RAIL WITH STEEL POSTS, ITEM 543 542
NORTHBOUND
3478+00 - 3478+00

SOUTHBOUND
3478+00 - 3478+00

PROPERTY LINE FENCE WITH STEEL POSTS, ITEM 585-0
NORTHBOUND
3464+00 - 3476+400

SOUTHBOUND
3464+00 - 3476+400

List of Sheets for
P.C. Box @ Sta 3467+75
1 of 6 Plan and Section
2 of 6 General Notes, Details, &
Summary of Quantities
3 of 6 Reinforcing Schedule
4 of 6 Chan. Line Sections
Reference Sheet
Standard Sheet S.D. 21-56

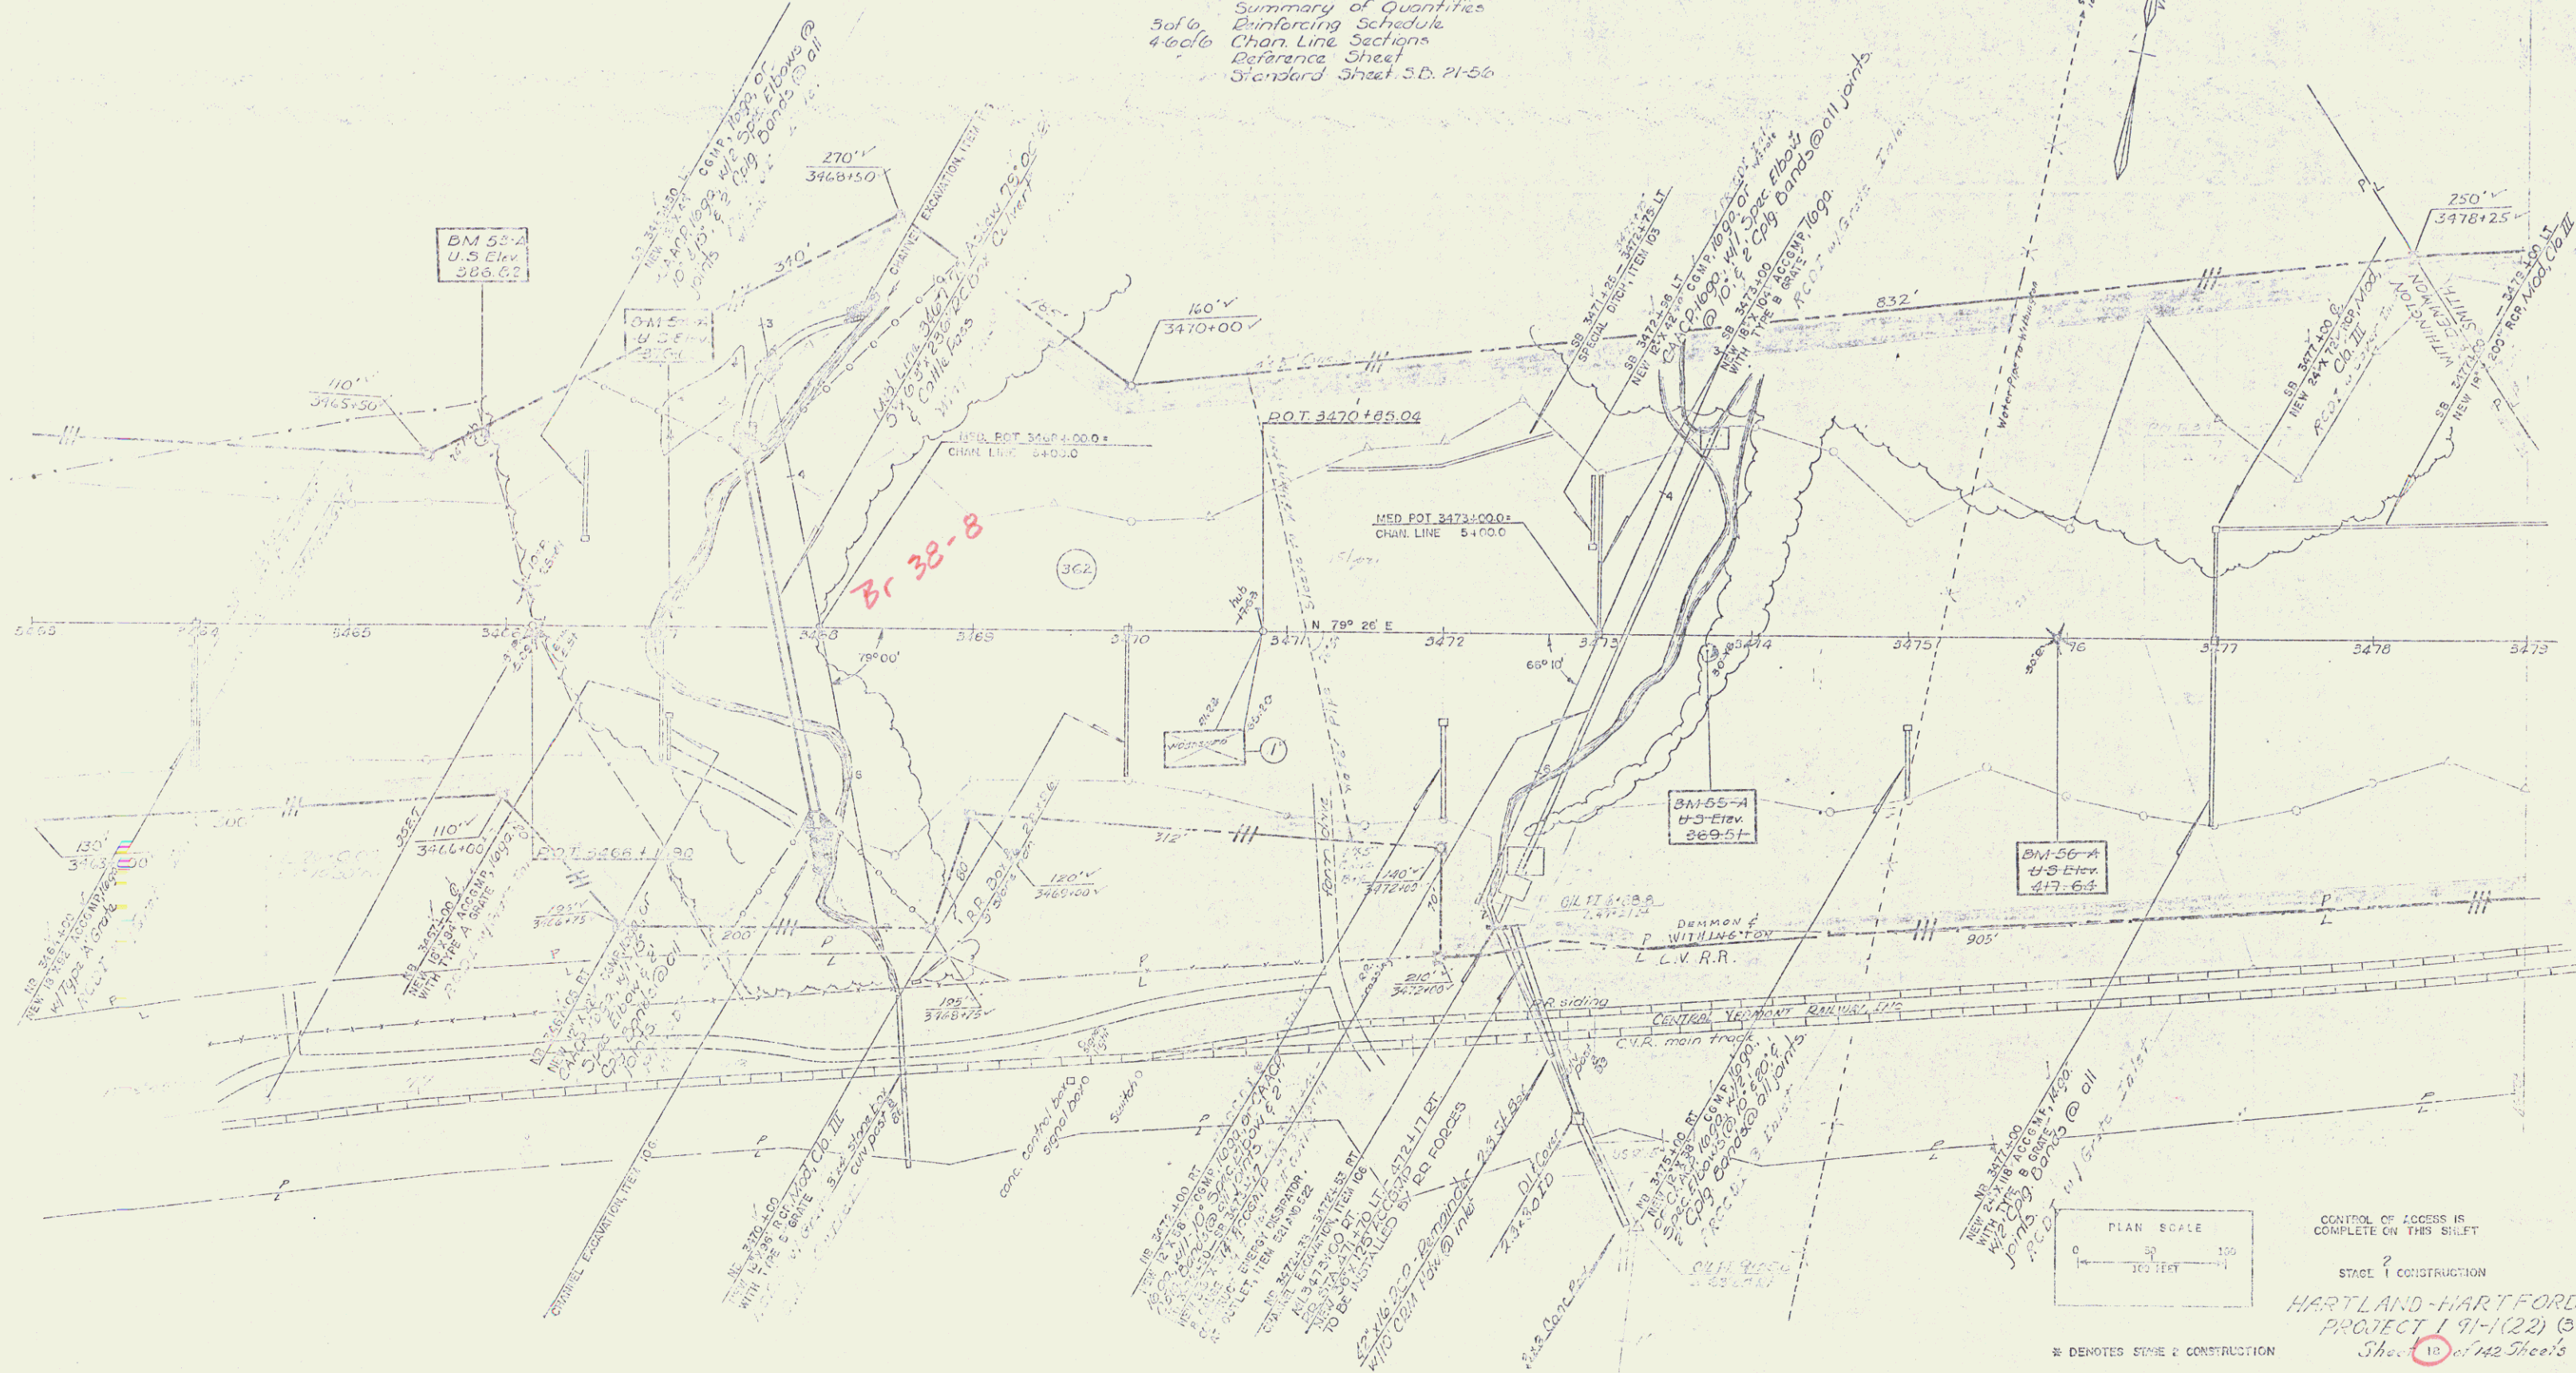

CONTROL OF ACCESS IS
COMPLETE ON THIS SHEET

STAGE 1 CONSTRUCTION

HARTLAND-HARTFORD
PROJECT 191-1(22) (B1)

Sheet 10 of 142 Sheets

CONTRACT # 191-1(22)

Sheet 10 of 200