
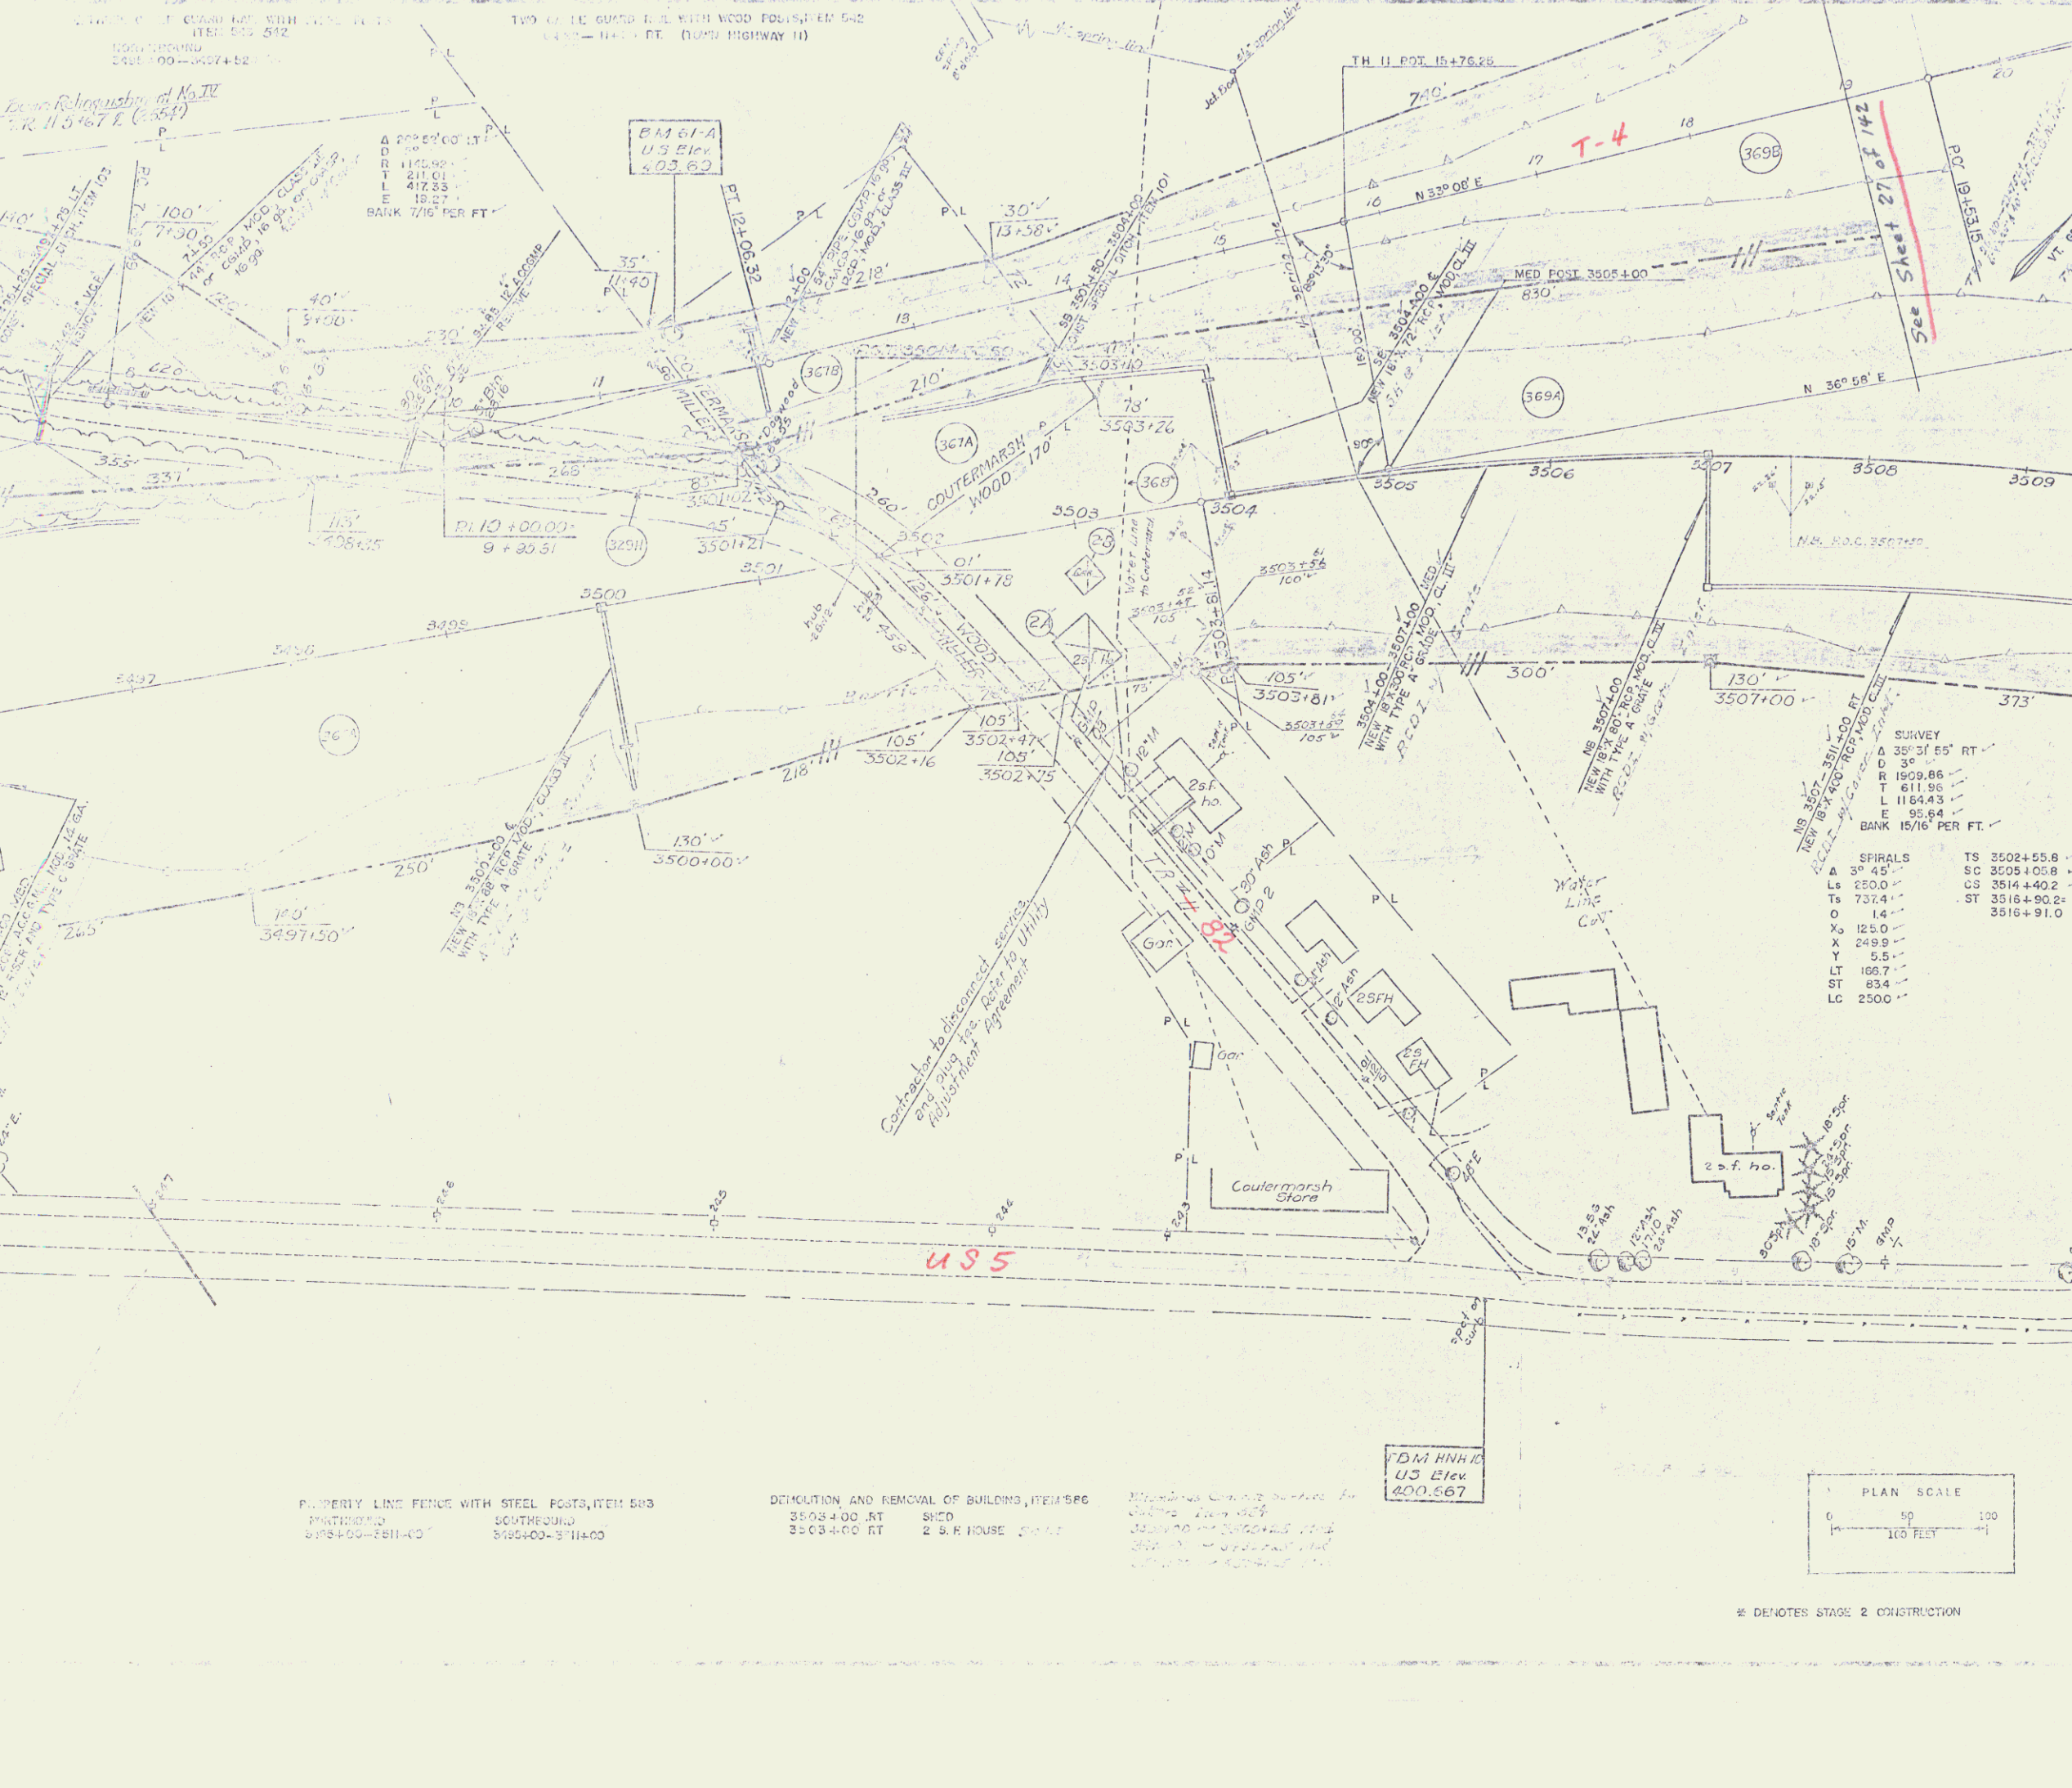


WHITE MATTE...
 3505 000-3511 000
 3506 000-3512 000
 3507 000-3513 000
 3508 000-3514 000
 3509 000-3515 000

STATION 64+00
 BEGIN CONSTRUCTION

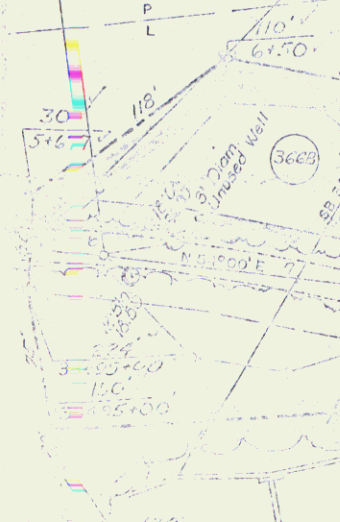

SHRVEY

A	35° 31' 55" RT
D	30°
R	1929.86
T	611.96
L	11644.3
E	95.84
ST	834
LC	2500

BANK 15/16 PER FT

TS	3502+25.8
SC	3505+05.8
CS	3514+40.2
ST	3516+90.2
3516+91.0 EQ1-0.8	

SPIRALS

A	35° 31' 55" RT
D	30°
R	1929.86
T	611.96
L	11644.3
E	95.84
ST	834
LC	2500

SPIRAL OFFSETS

3503+00	0.0 RT
3503+50	0.3
3504+00	1.0
3504+50	1.3
3505+00	1.1
3516+50	1.1
3515+00	1.2
3516+50	1.0
3516+00	0.2
3516+50	0.0 RT

PROPERTY LINE FENCE WITH STEEL POSTS, ITEM 503
 3503+00-3511+00
 3503+00-3511+00

DEMOLITION AND REMOVAL OF BUILDING, ITEM 504
 3503+00 RT SHED
 3503+00 RT 2 B.R. HOUSE

DEMOLITION AND REMOVAL OF BUILDING, ITEM 504
 3503+00 RT SHED
 3503+00 RT 2 B.R. HOUSE

UDM HNH/2
 US Elev
 400.567



CONTROL OF ACCESS IS COMPLETE ON THIS SHEET

STAGE 1 CONSTRUCTION
 HARTLAND-HARTFORD
 PROJECT 1 91-1(22) (31)
 Sheet 22 of 22 Sheets
 CONTRACT # 22
 SHEET NO. 22