

RIGHT-OF-WAY DIVISION
TOWN FILE
PERPETUAL
Town of _____
(To Be Returned To R.O.W. Division) M M 65.90 SB


HARTLAND Vol Fire Dept
I 91 Emergency Access Agreement
March 9, 1994 BK 99 Pg 409-412

POOR ORIGINAL COPY

PROPERTY LINE FENCE WITH STEEL POSTS, ITEM 883
NORTHBOUND 3495+00-3511+00
SOUTHBOUND 3495+00-3511+00

DEMOLITION AND REMOVAL OF BUILDINGS, ITEMS 8
3503+00 RT 2 R.R. HOUSE SOLD
3503+00 RT 2 R.R. HOUSE SOLD

DM NHH4
US CIVIL
400.667

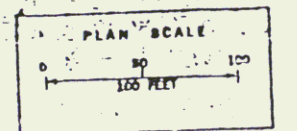

CONTROL OF ACCESS IS COMPLETE ON THIS SHEET
2
EDGE 1 CONSTRUCTION
HARTLAND-HART
PROJECT I 91-11
Sheet 37 of 42
CONTRACT 87-2
Sheet 37 of 42

8 DENOTES STAGE 2 CONSTRUCTION