

PLAN  
 DATE: 10/1/00  
 DRAWN BY: J. H. HART  
 CHECKED BY: J. H. HART  
 SCALE: AS SHOWN

CONSTRUCT FRONTAGE ROAD  
 NB 3540+00 - 3542+50 DIV

NOTE: CONTROL OF ACCESS IS COMPLETE ON THIS SHEET

Effective Control Surface Per Section 179  
 3540+00 - 3541+00  
 3541+00 - 3542+00  
 3542+00 - 3543+00  
 3543+00 - 3544+00

\* THREE CABLE GUARD RAIL W/  
 STEEL POSTS, 17MM DIA 542

NB 3540+00 - 3543+00 RT

SB 3540+00 - 3543+00 LT

PROPERTY LINE FENCE W/ STEEL  
 POSTS ITEM 503-B

NB 3540+00 - 3543+00 RT

SB 3540+00 - 3543+00 LT

JUTE MATTING ITEM 620

Med 3540+00 - 3541+00


Med 3541+00 - 3542+00

Med 3542+00 - 3543+00


Med 3543+00 - 3544+00

Spiral Curve Data  
 $\Delta$  40°06'17" LF  
 Dc 3'  
 Gs 3'45'00"  
 Ls 250.00  
 Ts 1132.76  
 D 138'  
 Xs 124.93  
 Ys 249.89  
 Zs 5.25  
 LT 166.70  
 ST 3537  
 LC 249.95  
 Lc 1603.49  
 bank 1/4 in 12'

Circular Curve Data  
 $\Delta$  35°36'17" LF  
 D 31'  
 Q 1909.88  
 T 1007.08  
 L 1853.49  
 E 249.25

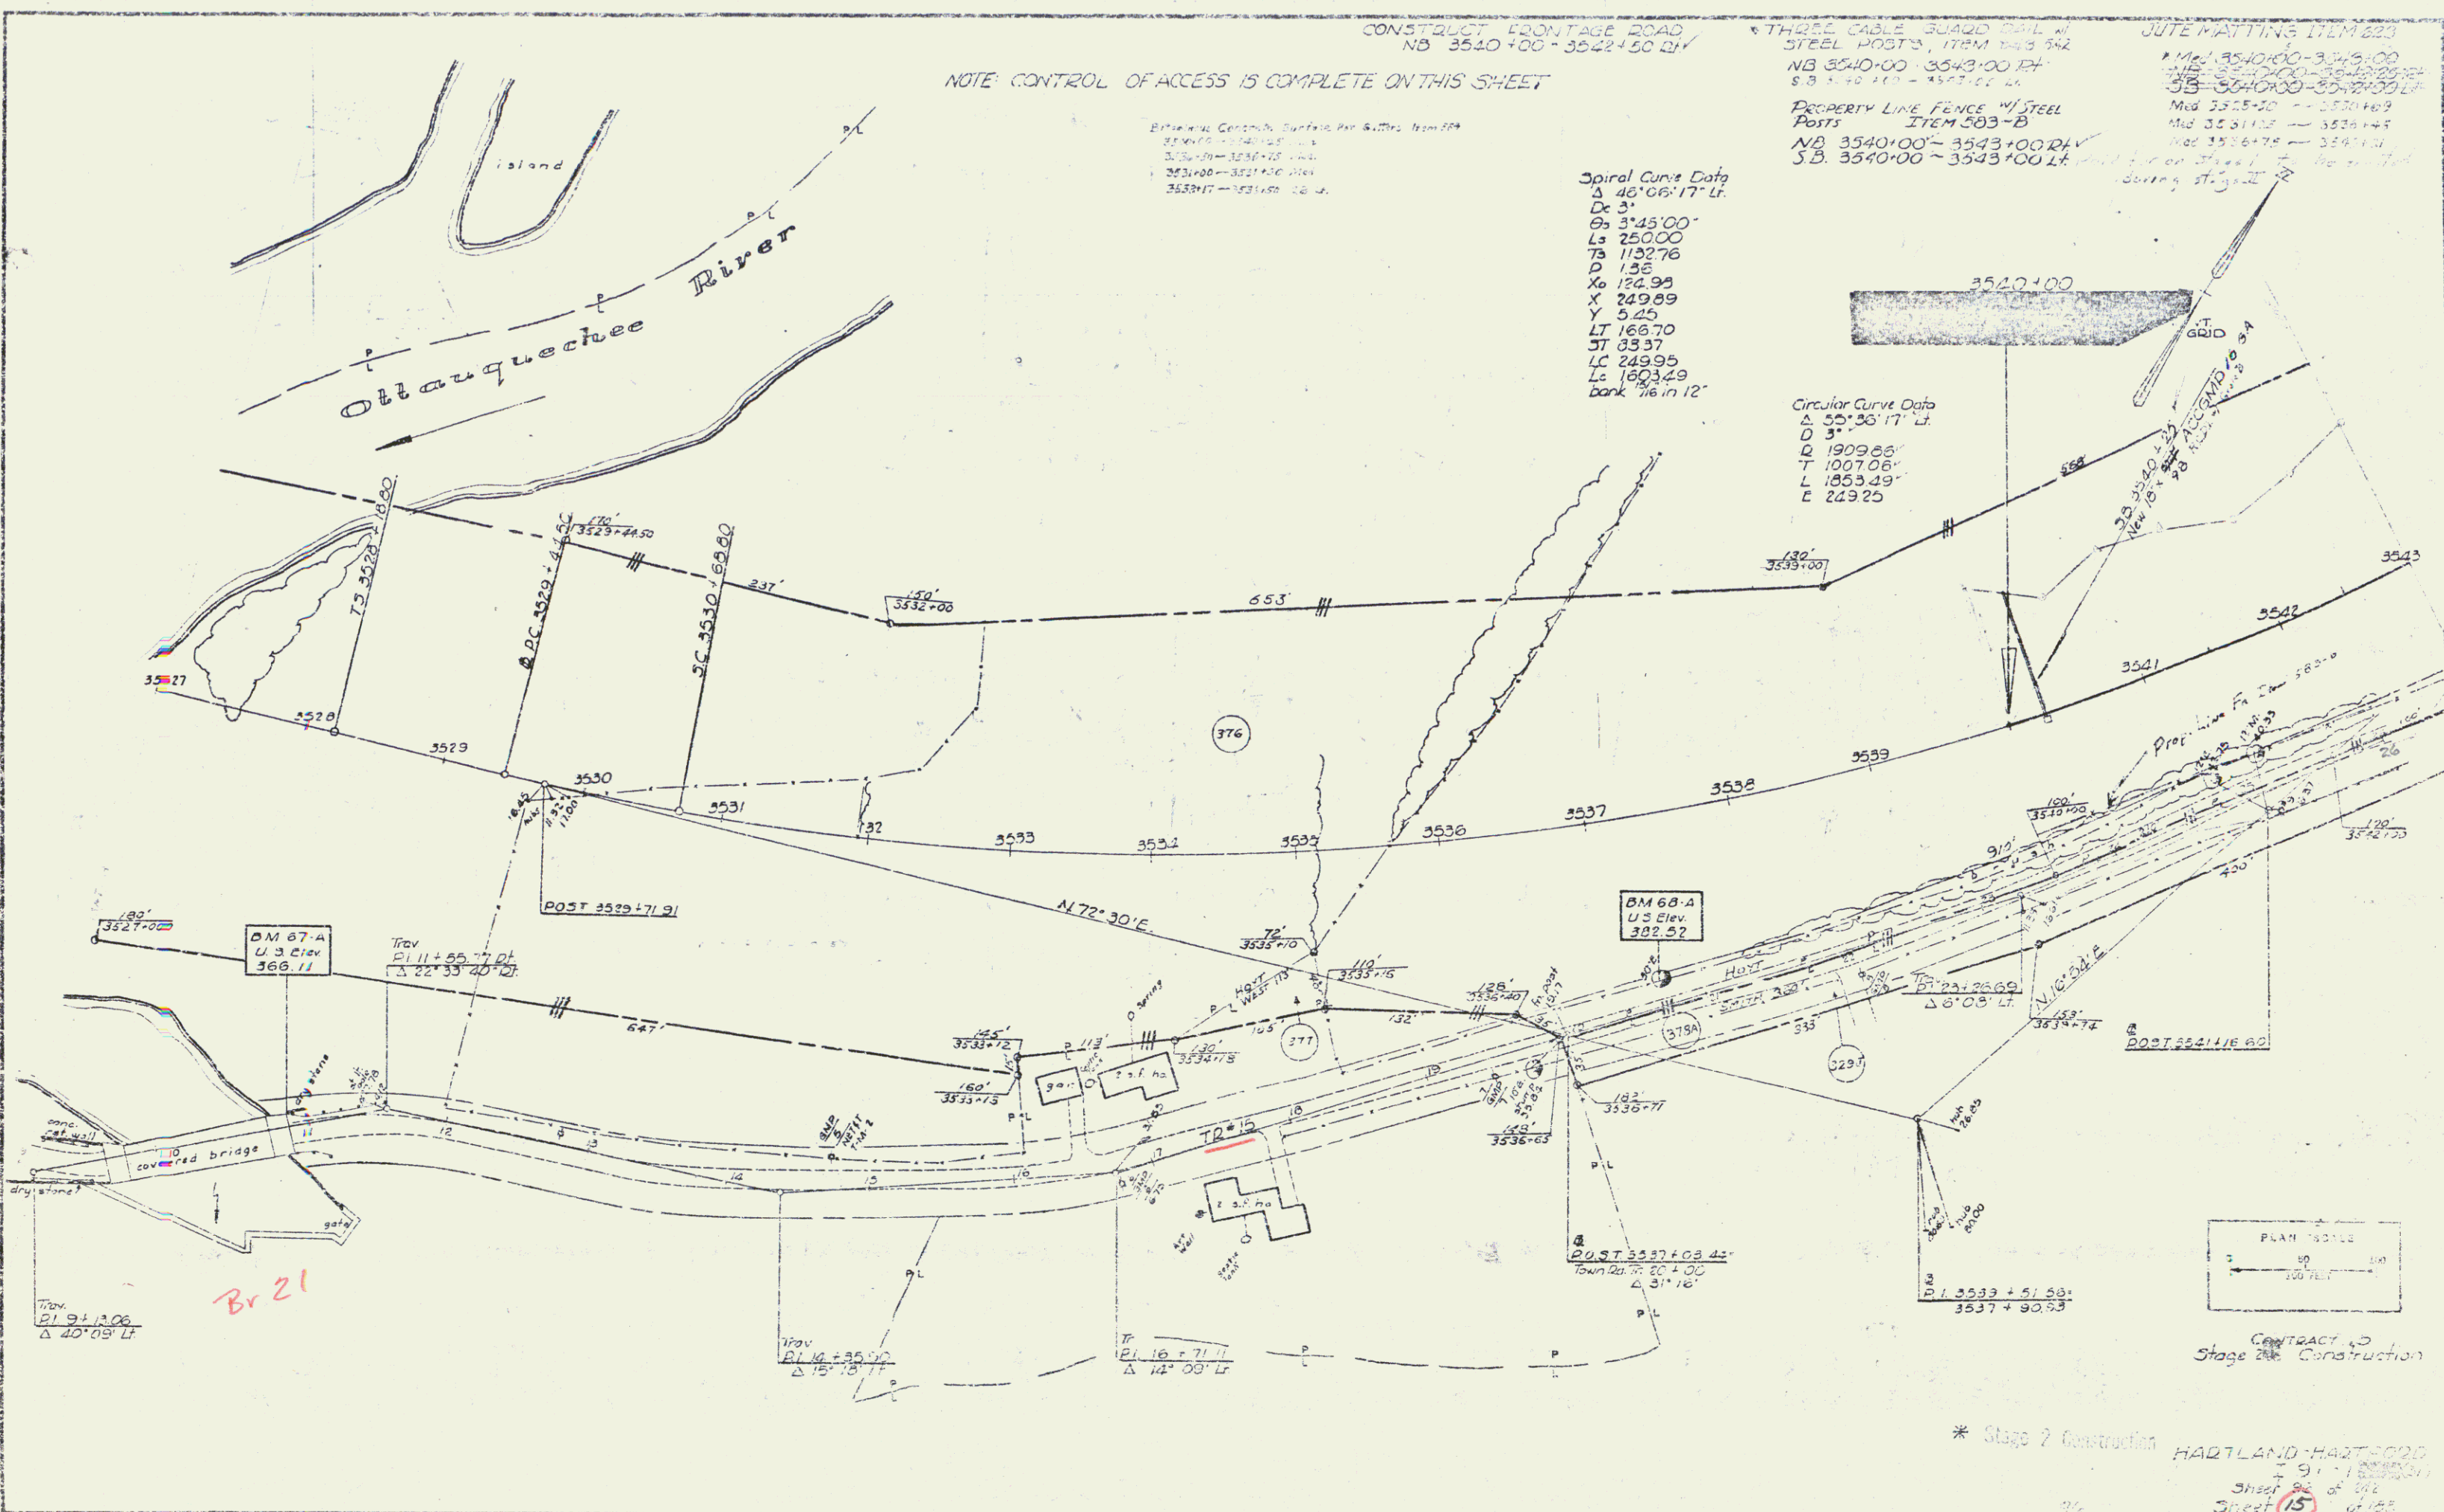

Br 21

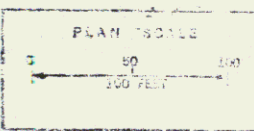

CONTRACT NO  
 Stage 2 Construction

\* Stage 2 Construction  
 HARTLAND-HART SOO  
 Sheet 15 of 15