


THREE CABLE GUARD RAIL
W/ STEEL POSTS
SB 3703+07-3703+63 Lt
SB 3703+14-3705+14 Rt
NB 3702+00-3702+06 Lt
NB 3703+14-3707+14 Rt
SB 3706+08-3706+40 Lt

NB 3705+43-3707+59 Lt
NB 3710+00- Ramp B 5+00 Rt
Ramp B 1150-546 Lt
SB 3711+21-3713+81 Rt
SB 3711+25 Lt- Ramp G 6+56 Rt
Ramp G 6150-7+46 Lt 3+37
SB 3717+50-3719+00 Lt
Ramp C 25+50- NB 3718+02 Rt
Ramp C 22+62-25+25 Rt
Ramp C 22+98-25+75 Lt

PROPERTY LINE FENCE
W/ STEEL POSTS, ITEM 583-B,
Ramp C 35+50-41+98 Rt

JUTE MATTING
- NB 3712+50-3716+50 Rt

* BITUMINOUS CONCRETE GUTTER, ITEM 254
Ramp G 5+75-21+5
Ramp F 2+50-21+5
Ramp F 13+00-21+5
Med 3715+95-3716+45
Ramp B 0+00-21+5

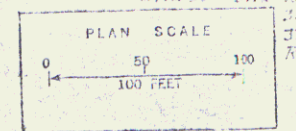

DRILLING & BLASTING of SOLID
ROCK SUBGRADE, ITEM 114
NB 3702+00-3702+16.72 10
SB 3702+00-3702+02 V
NB 3703+80-3705+25 30
Ramp C 17+00-22+62 60
Ramp F 0+00-12+75 V

* STANDARD STEEL BEAM GUARD
RAIL W/ STEEL POSTS ITEM 1046A
SB 3703+00- NB 3702+06 Lt
SB 3703+14- NB 3703+30 Lt
SB 3704+41- 3704+95 Lt
NB 3707+59 Lt- SB 3707+92 Rt
NB 3711+23 Lt- SB 3711+51 Rt
NB 3712+10- 3712+58 Rt
Ramp B 1+00- 1+42 Lt
Ramp C 17+00- 17+52 Rt
Ramp F 1+00- 1+54 Lt

* GRANITE SLOPE
EDGING ITEM 55-A
SB 3704+47-3704+97 Lt
NB 3710+88-3711+11 Rt
NB 3712+13-3712+63 Rt
Ramp B 0+00- 5+00 Rt w/ 2 Detainers
Ramp B 0+97- 1+47 Lt
Ramp C 17+00- 17+56 Rt
Ramp C 33+00- 41+98 Rt
Ramp F 0+00- 2+50 Rt
Ramp F 0+97- 1+47 Lt
Ramp F 12+00- 14+92 Rt
Ramp G 4+65- 9+29 Rt

* BITUMINOUS CONCRETE CURB
ITEM 255
NB 3705+79-3707+14 Rt
Ramp C 23+00-25+75 Lt

BIDDER FOR BANK PROTECTION
MOD. FOR CULVERT ENDS, ITEM 526
NB 3705+45-
SB 3708+85 Lt
Ramp B 4+00- 5+00 Rt V
Ramp C 7+4-50 Lt
SB 3716+5

STONE FILL FOR SLOPE
PROTECTION, ITEM 522
Ramp C 40+60 Rt

CONTROL OF ACCESS COMPLETE ON THIS SHEET
* Indicates Stage 2 Construction

HARTLAND - HARTFORD
I 89-I 91 (25) Stage 2 Construction
Sheet 120 of 242