

Property Line Fence w/ Steel Posts Item 283.3
 Ramp A 21+99-33+55 RT
 Ramp C 33+55-35+50 RT

* Granite Slope Edging, Item 556-A
 Ramp A 25+71-34+31, LT
 Ramp B 5+00-12+35 RT w/ Retainer


* Three Cable Guard Rail w/ Steel Posts
 A 21+99-25+50 RT, Item 542
 B 5+00-8+00 RT
 C 28+27-30+59 RT
 A 25+50-29+95 LT

Jute Matting Item 283
 C 30+25-30+25 LT
 C 27+75-30+75 RT
 B 6+50 RT


* Bituminous Concrete Curb Item 555
 Ramp A 21+99-21+50 RT
 Ramp A 26+30-29+05 LT
 Ramp C 28+31-30+75 LT

* Bituminous Concrete Gutters Item 554
 Curb Drains
 B 8+00 RT
 B 10+80 RT
 C 28+35-29+55 LT

Eriprap for Bank Protection
 Mod for Culvert Ends Item 526
 Ramp D 5+00-8+00 RT
 Ramp A 24+00 RT

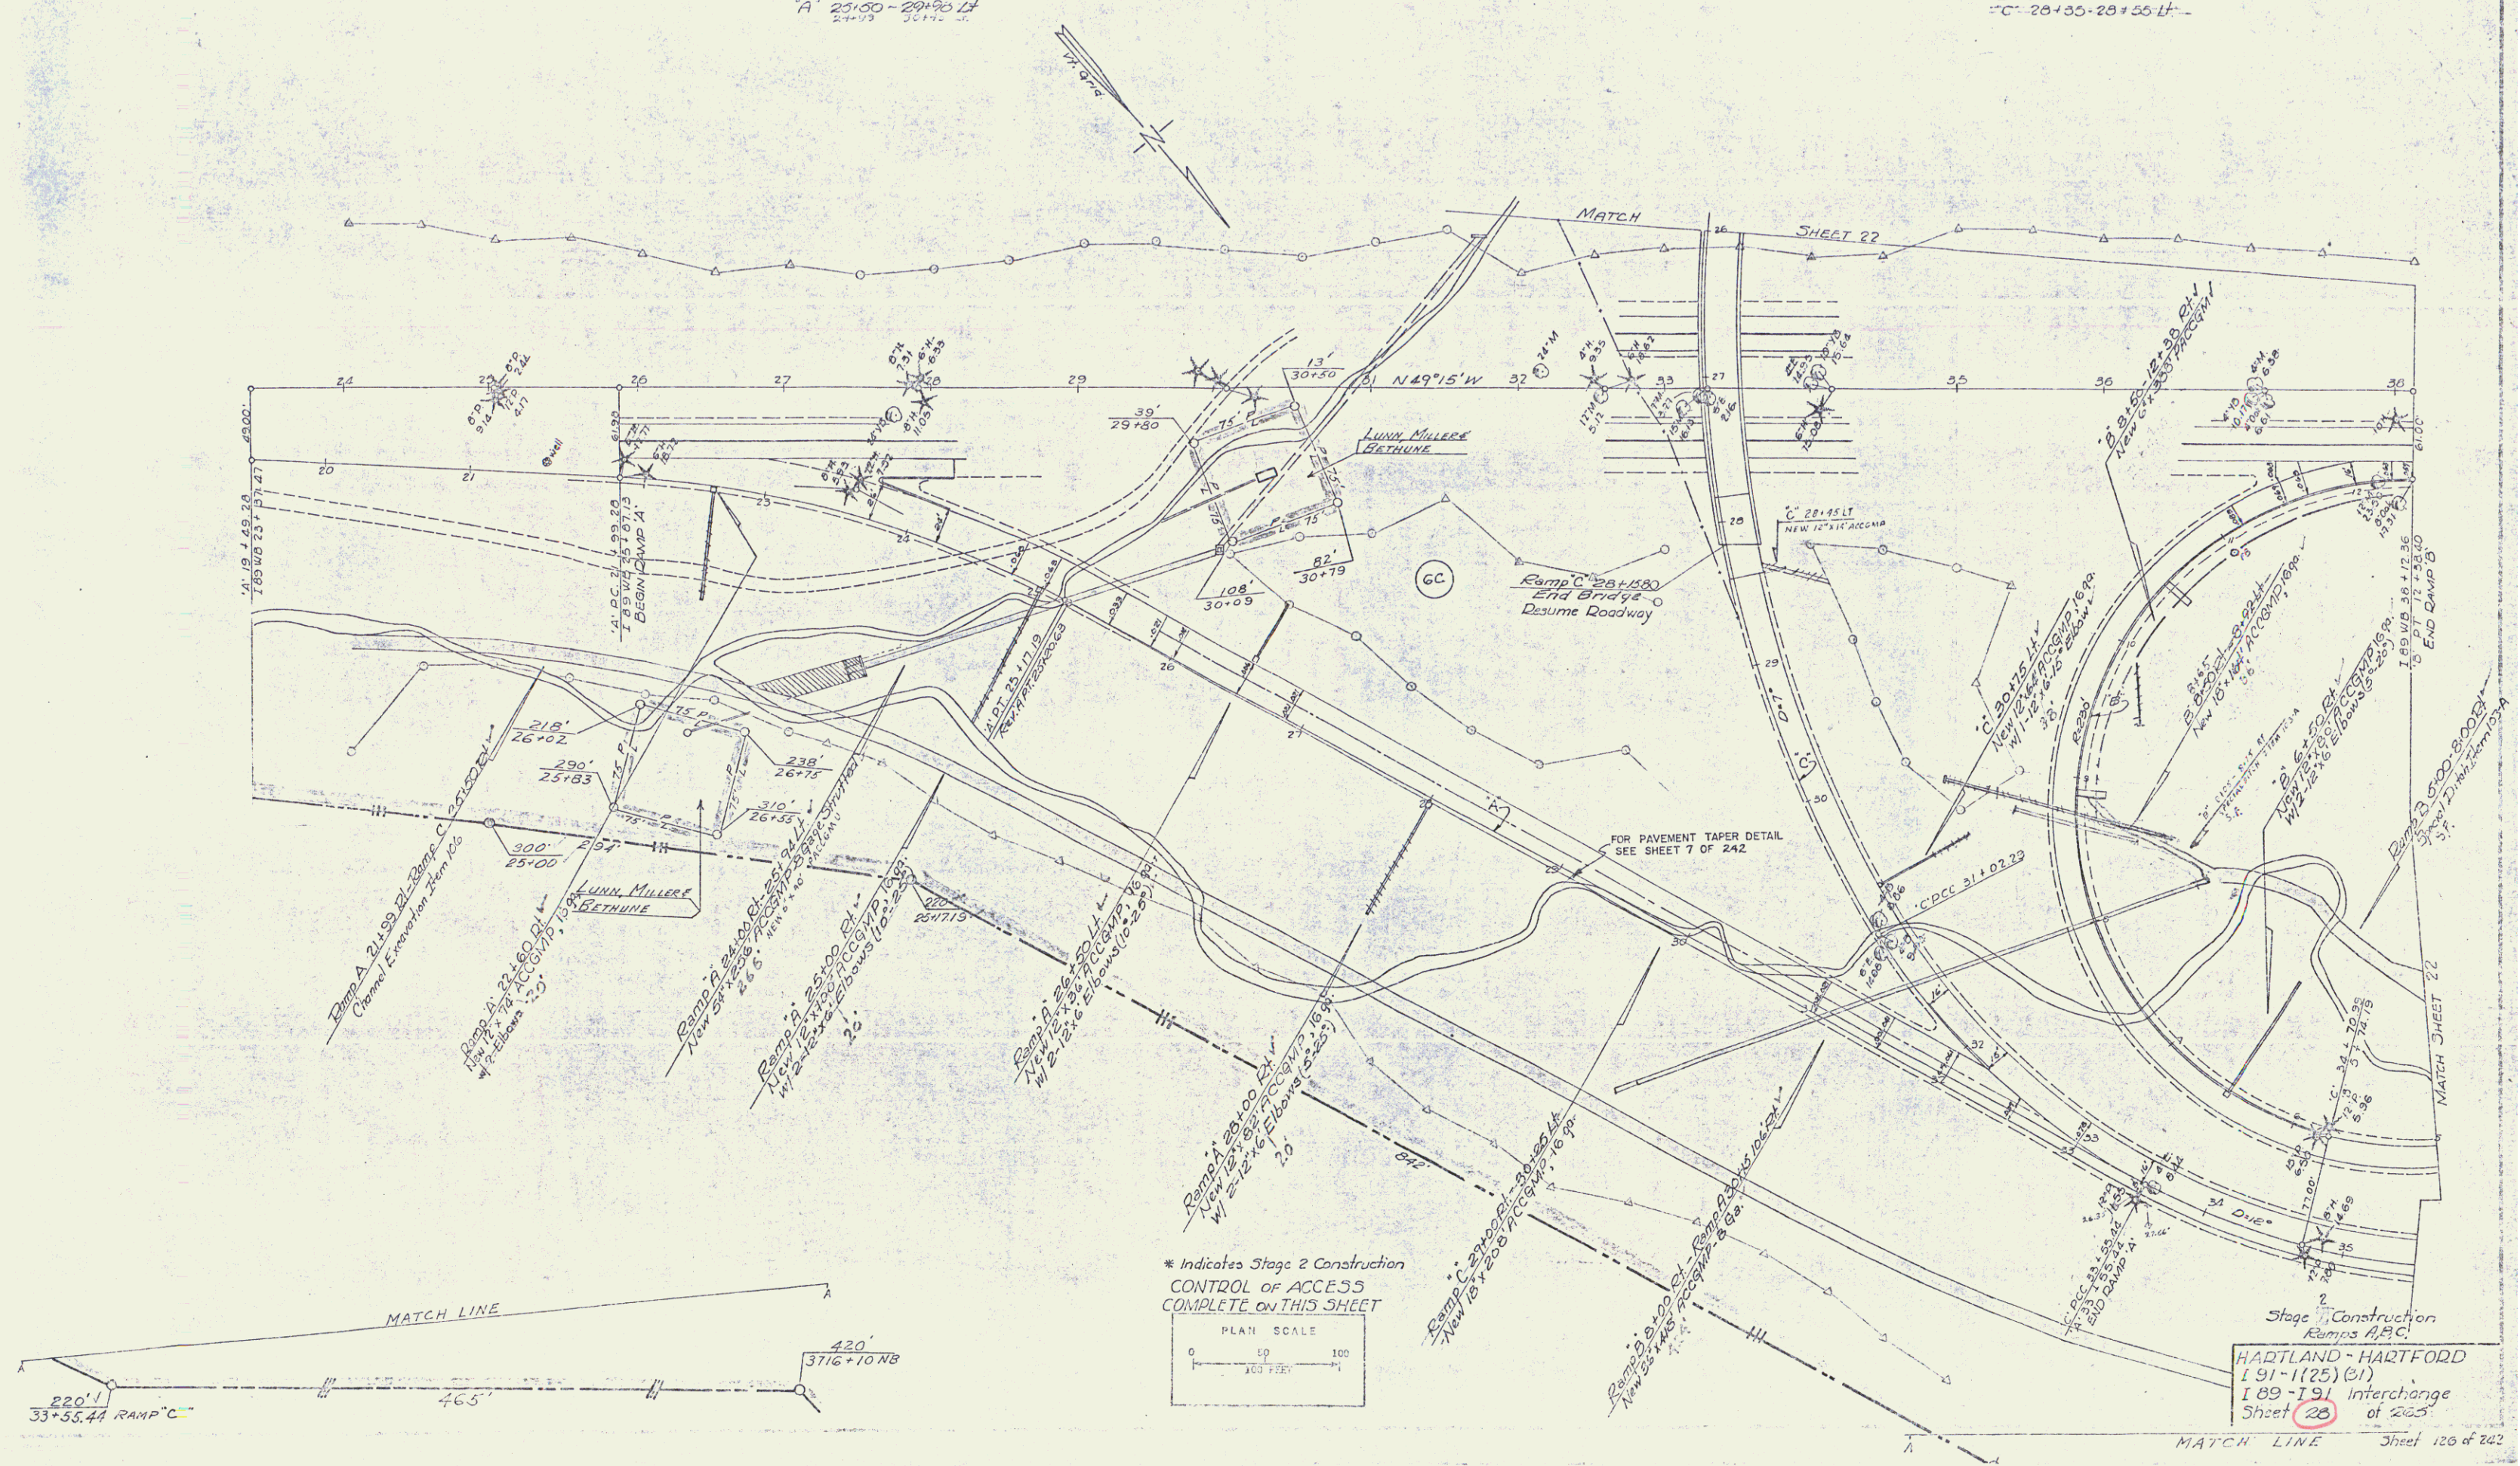

* Indicates Stage 2 Construction
 CONTROL OF ACCESS
 COMPLETE ON THIS SHEET

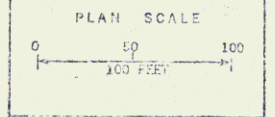

Stage 2 Construction
 Ramps A, B, C
 HADTLAND - HARTFORD
 I 91-1(25) (31)
 I 89-191 Interchange
 Sheet 28 of 242