
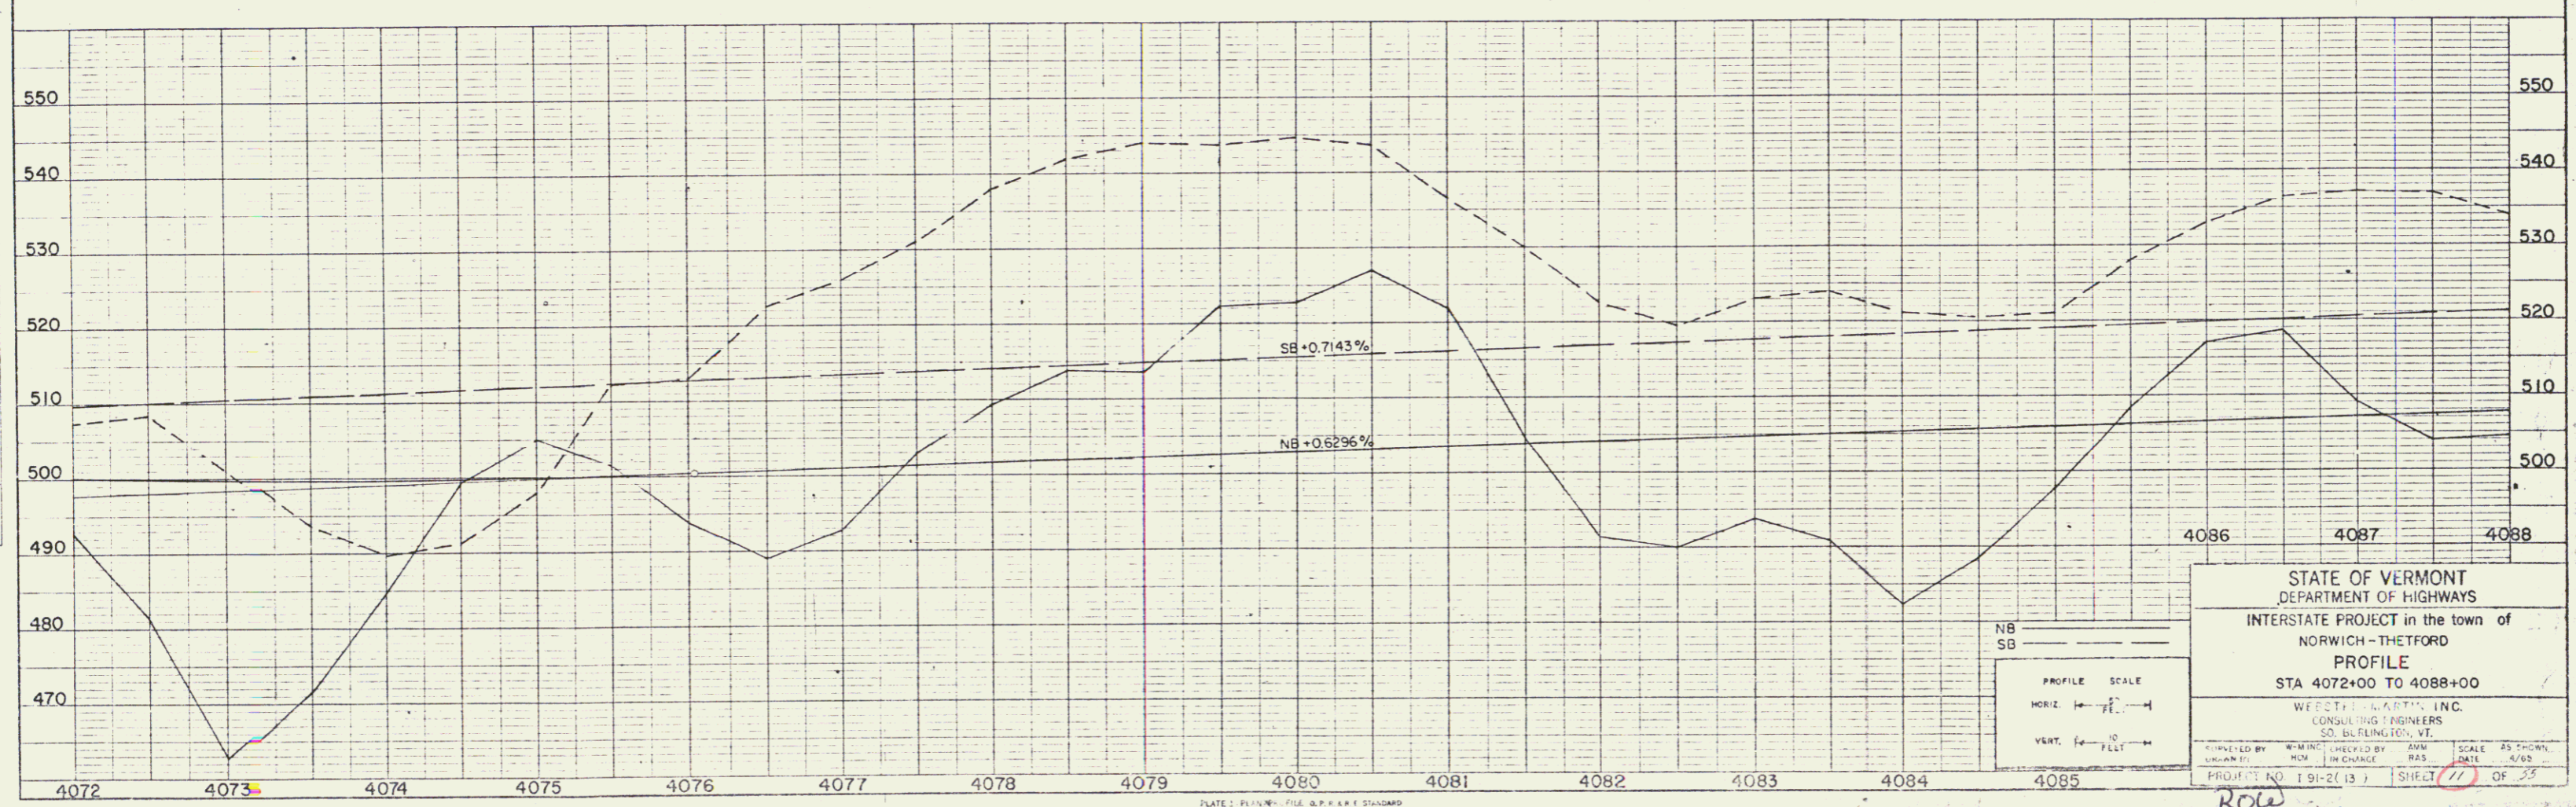


PLAN
NOTE BOOK
NO.

PROFILE
NOTE BOOK
NO.

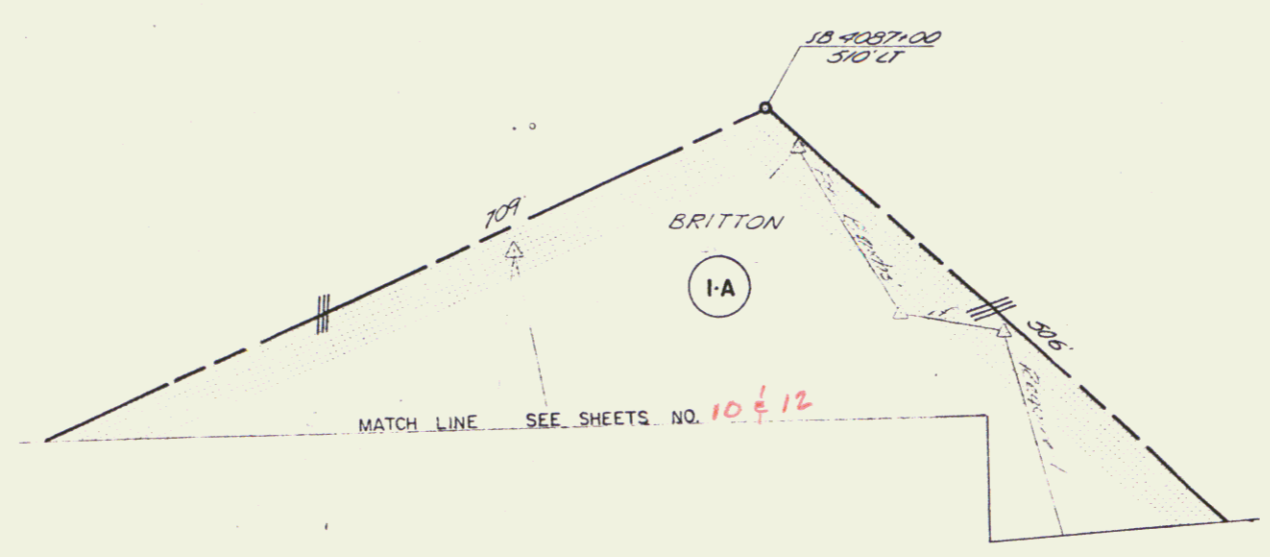

NB
SB
PROFILE SCALE
HORIZ. 1" = 40'
VERT. 1" = 10'

STATE OF VERMONT
DEPARTMENT OF HIGHWAYS
INTERSTATE PROJECT in the town of
NORWICH - THETFORD
PROFILE
STA 4072+00 TO 4088+00
WEED & MARTIN, INC.
CONSULTING ENGINEERS
50 BURLINGTON, VT.
DESIGNED BY: [] CHECKED BY: [] DATE: 4/68
PROJECT NO. 191-2(13) SHEET 77 OF 88

PLATE: PL/14-1 FILE: S.P. 1-1 STANDARD
REVISION: 1-1-68, NEW YORK, N.Y.

Row

6