

PROPERTY LINE FENCE WITH STEEL POSTS ITEM 583-D MOD.

STA	STA	POS
4408+00	4408+00	PT
4408+00	4408+00	ST
4408+00	4408+00	LT
4408+00	4408+00	RT

CONSTRUCT DRIVE

STATION	POS
T-58 RELOCATION	PT
515+75	LT

CONTRACT NO. 3

STATE OF VERMONT
DEPARTMENT OF HIGHWAYS


INTERSTATE PROJECT in the towns of
NORWICH-THETFORD

PLAN
STA 4408+00 TO 4424+00

WEBSTER-MARTIN, INC.
CONSULTING ENGINEERS
140 ZUNI NOTCH, VT.
BURLINGTON, VT. 05401

DATE: 10/15/83

14

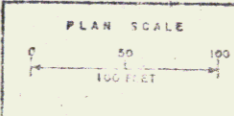

CONTROL OF ACCESS COMPLETE ON THIS SHEET