

PROPERTY LINE FENCE WITH STEEL POSTS
ITEM SB3-II MOD

STA	STA	POS
NORTHBOUND		
4424+00	4438+00	RT
SOUTHBOUND		
4438+00	4424+00	LT

SB 4425+00
END CONTRACT NO 3 CONTRACT NO 4
BEGIN

END CONTRACT NO 3 CONTRACT NO 4
BEGIN NB 4429+00


CONTRACT NO 3

DEPARTMENT OF TRANSPORTATION
INTERSTATE PROJECT
NORWICH - THETFORD
PLAN
STA NB 4424+00 TO 4438+00
SB 4424+00 TO 4440+00

WEBSTER-MARTIN, INC.
CONSULTING ENGINEERS
50 BURLINGTON, VT.

DESIGNED BY	CHECKED BY	DATE
BY	BY	1992

SCALE AS SHOWN
SHEET 27 OF 27

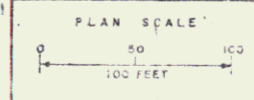

CONTROL OF ACCESS COMPLETE ON THIS SHEET

45