


see sheet 21

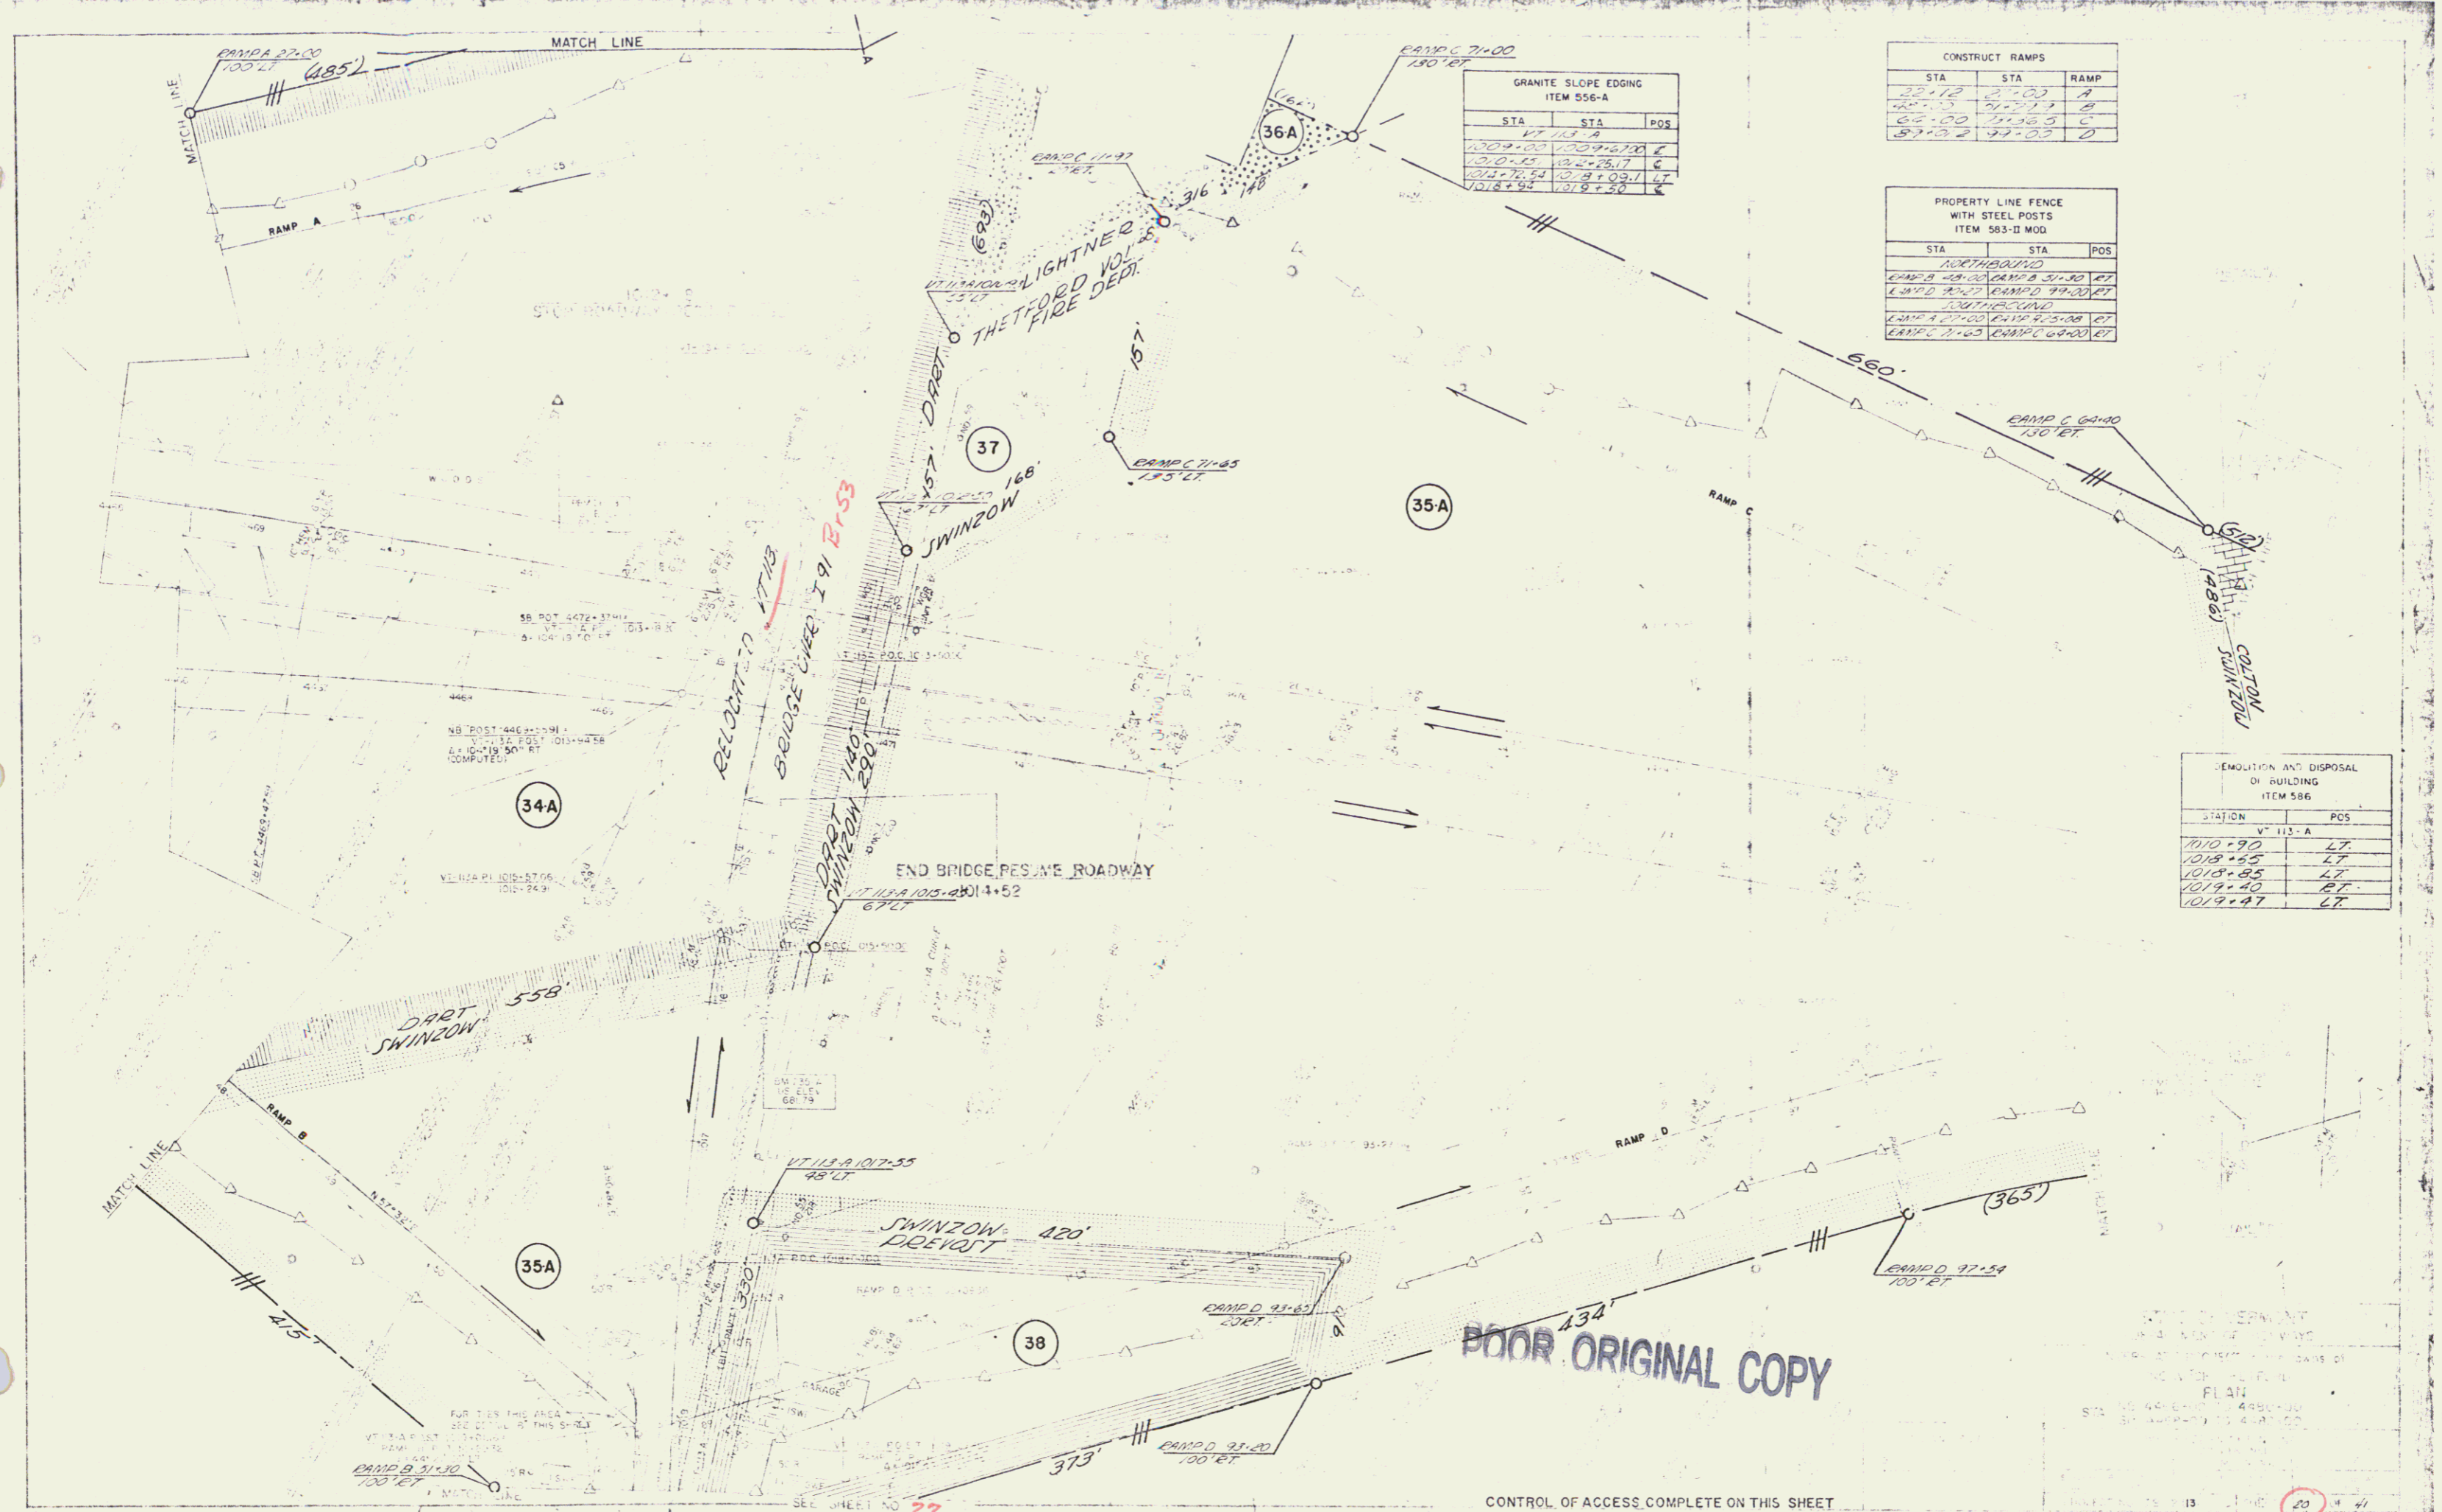

GRANITE SLOPE EDGING ITEM 556-A		
STA	STA	POS
1009+00	1009+25.00	E
1010+00	1010+25.17	C
1011+00	1011+25.21	LT
1012+00	1012+25.20	E

CONSTRUCT RAMP		
STA	STA	RAMP
1009+00	1009+25.00	A
1010+00	1010+25.17	B
1011+00	1011+25.21	C
1012+00	1012+25.20	D

PROPERTY LINE FENCE WITH STEEL POSTS ITEM 583-II MOD		
STA	STA	POS
1009+00	1009+25.00	LT
1010+00	1010+25.17	LT
1011+00	1011+25.21	LT
1012+00	1012+25.20	LT

DEMOLITION AND DISPOSAL OF BUILDING ITEM 586		
STATION	V	PCS
1010+90	115-A	LT
1018+85		LT
1018+85		LT
1019+40		LT
1019+47		LT

POOR ORIGINAL COPY

CONTROL OF ACCESS COMPLETE ON THIS SHEET

20

478