

RIP RAP (HEAVY TYPE) ITEM 503-A	
STATION	POS
309+00	LT
309+00	RT



CONSTRUCT DRIVE	
STATION	POS
320+00	LT
320+00	RT

STONE FILL (LIGHT TYPE) ITEM 503-B	
STATION	POS
320+25	RT (ITEM 512)

STONE FILL FOR SLOPE PROTECTION (LIGHT TYPE) ITEM 512	
STATION	POS
309+00	LT
309+00	RT

TWO CABLE GUARD RAIL ITEM 541	
STATION	POS
319+00	LT
319+00	RT

PROPERTY LINE FENCE  
310+75 - 314+57 LT.  
311+20 - 313+02 RT.

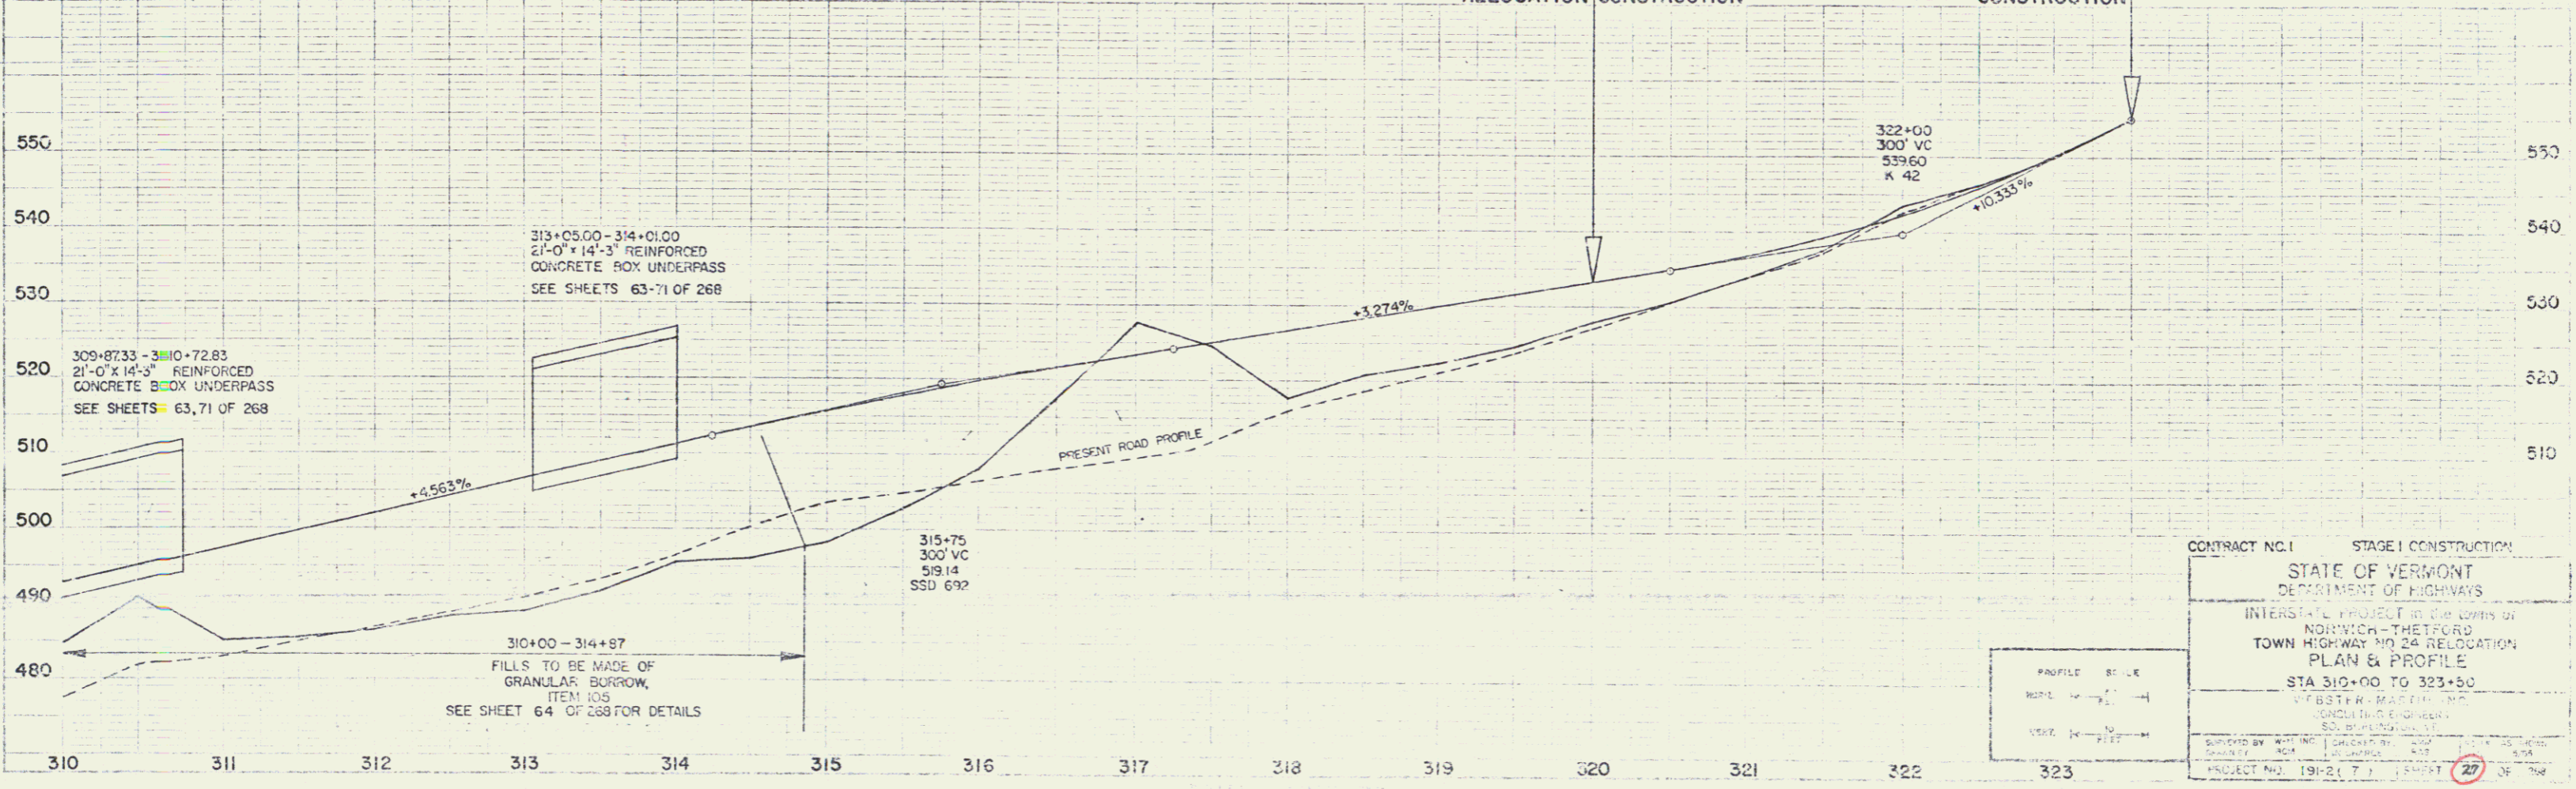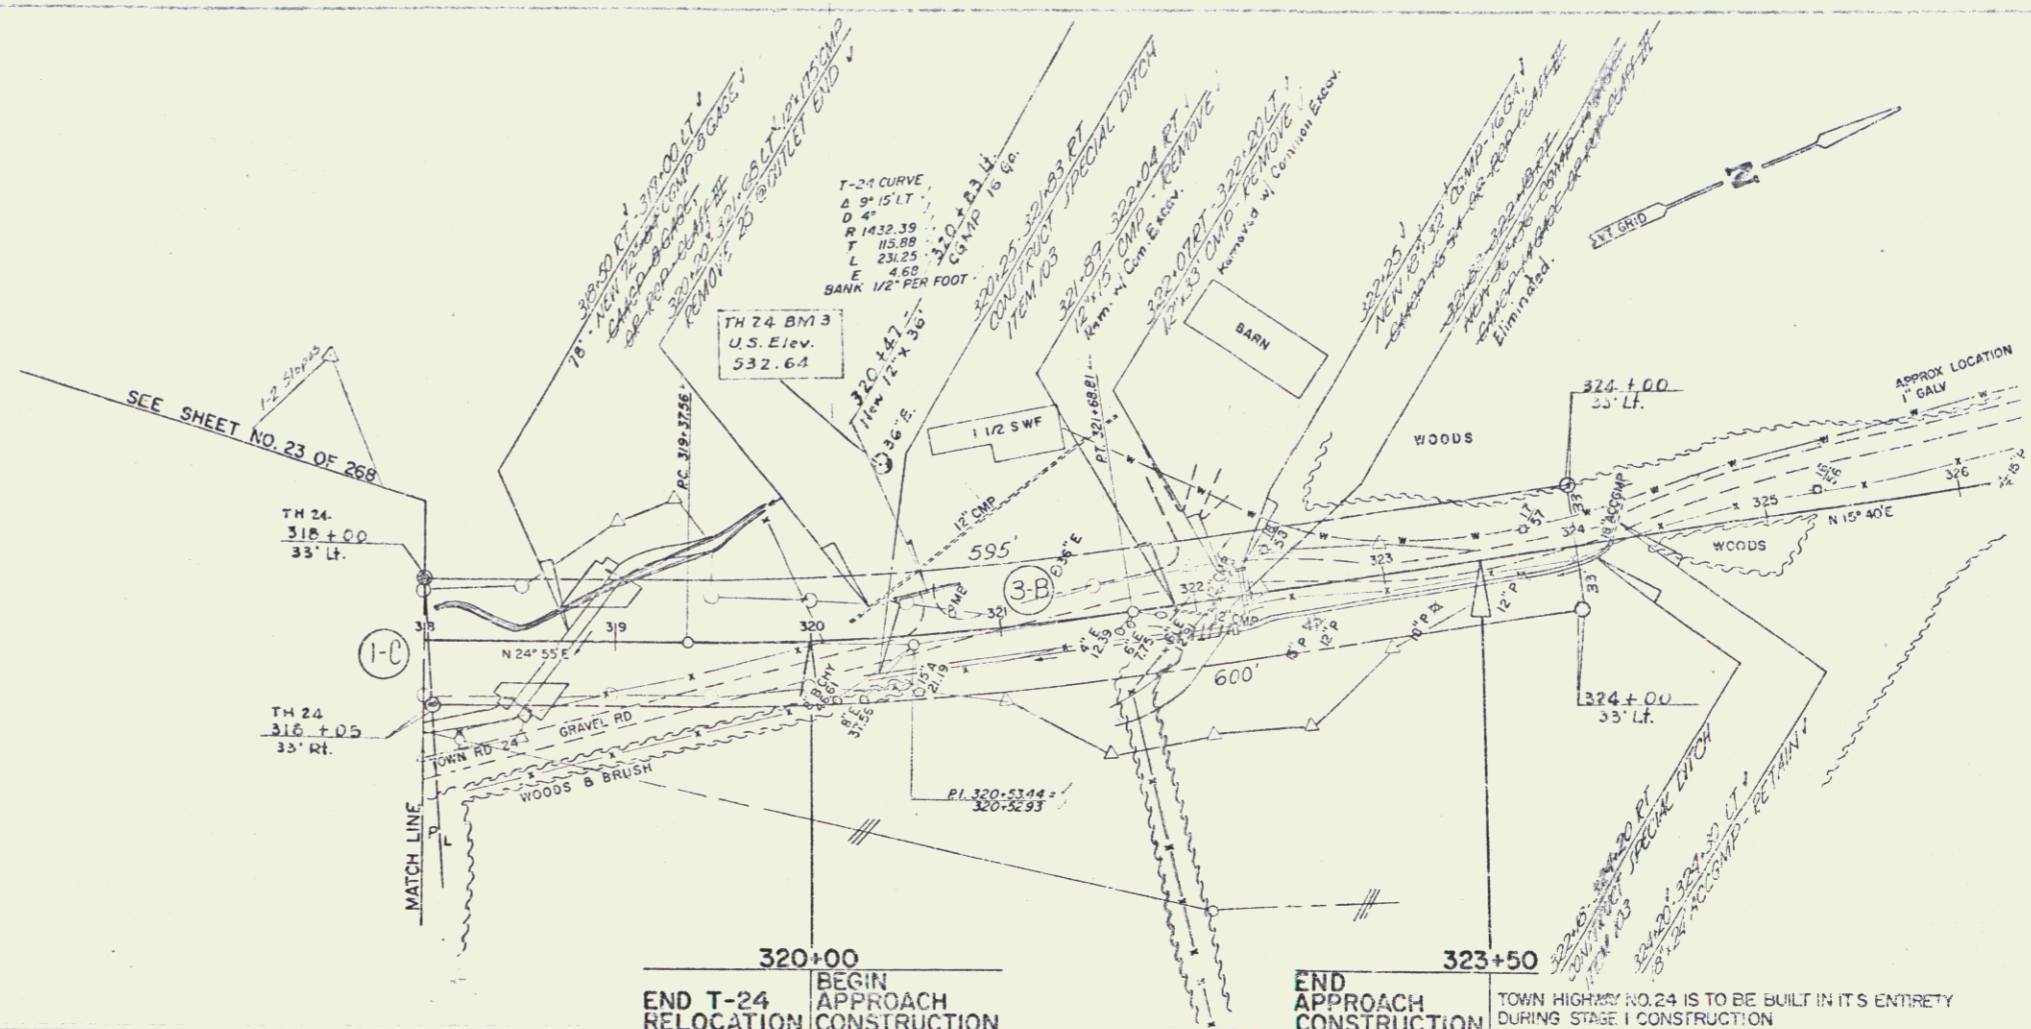

CONTRACT NO. 1 STAGE I CONSTRUCTION

STATE OF VERMONT  
DEPARTMENT OF HIGHWAYS

INTERSTATE PROJECT IN THE TOWNS OF  
NORWICH - THEFORD  
TOWN HIGHWAY NO. 24 RELOCATION  
PLAN & PROFILE  
STA 310+00 TO 323+50

DESIGNED BY: [Signature]  
CHECKED BY: [Signature]  
DATE: [Date]

PROJECT NO. 191-2(7) SHEET 27 OF 708

60