

CONSTRUCT ACCESS DRIVE
4190+00-4208+00 SBLT
NOT CONSTRUCTED, PROPERTY OWNER
RELEASED STATE FROM 03/19/91 TO
BUILD ROAD


DEMOLITION AND DISPOSAL OF BUILDING ITEM 586		
STATION	P.O.S.	
4194+00		
4195+00		
4196+00		
4197+00		
4198+00		
4199+00		
4200+00		

JUTE MATTING ITEM 623		
STATION	STATION	P.O.S.
4194+00	4195+00	
4195+00	4196+00	
4196+00	4197+00	
4197+00	4198+00	
4198+00	4199+00	
4199+00	4200+00	

12" SUB-BASE OF SAND ITEM 202		
STATION	STATION	P.O.S.
4194+00	4195+00	
4195+00	4196+00	
4196+00	4197+00	
4197+00	4198+00	
4198+00	4199+00	
4199+00	4200+00	

THREE CABLE QUARTZ RAIL WITH LIGHT STEEL POSTS ITEM 538		
STATION	STATION	P.O.S.
4193+54	4195+98	
4195+00	4200+00	

500' REMOVAL ITEM 435		
STATION	STATION	P.O.S.
4194+00	4195+00	
4195+00	4200+00	

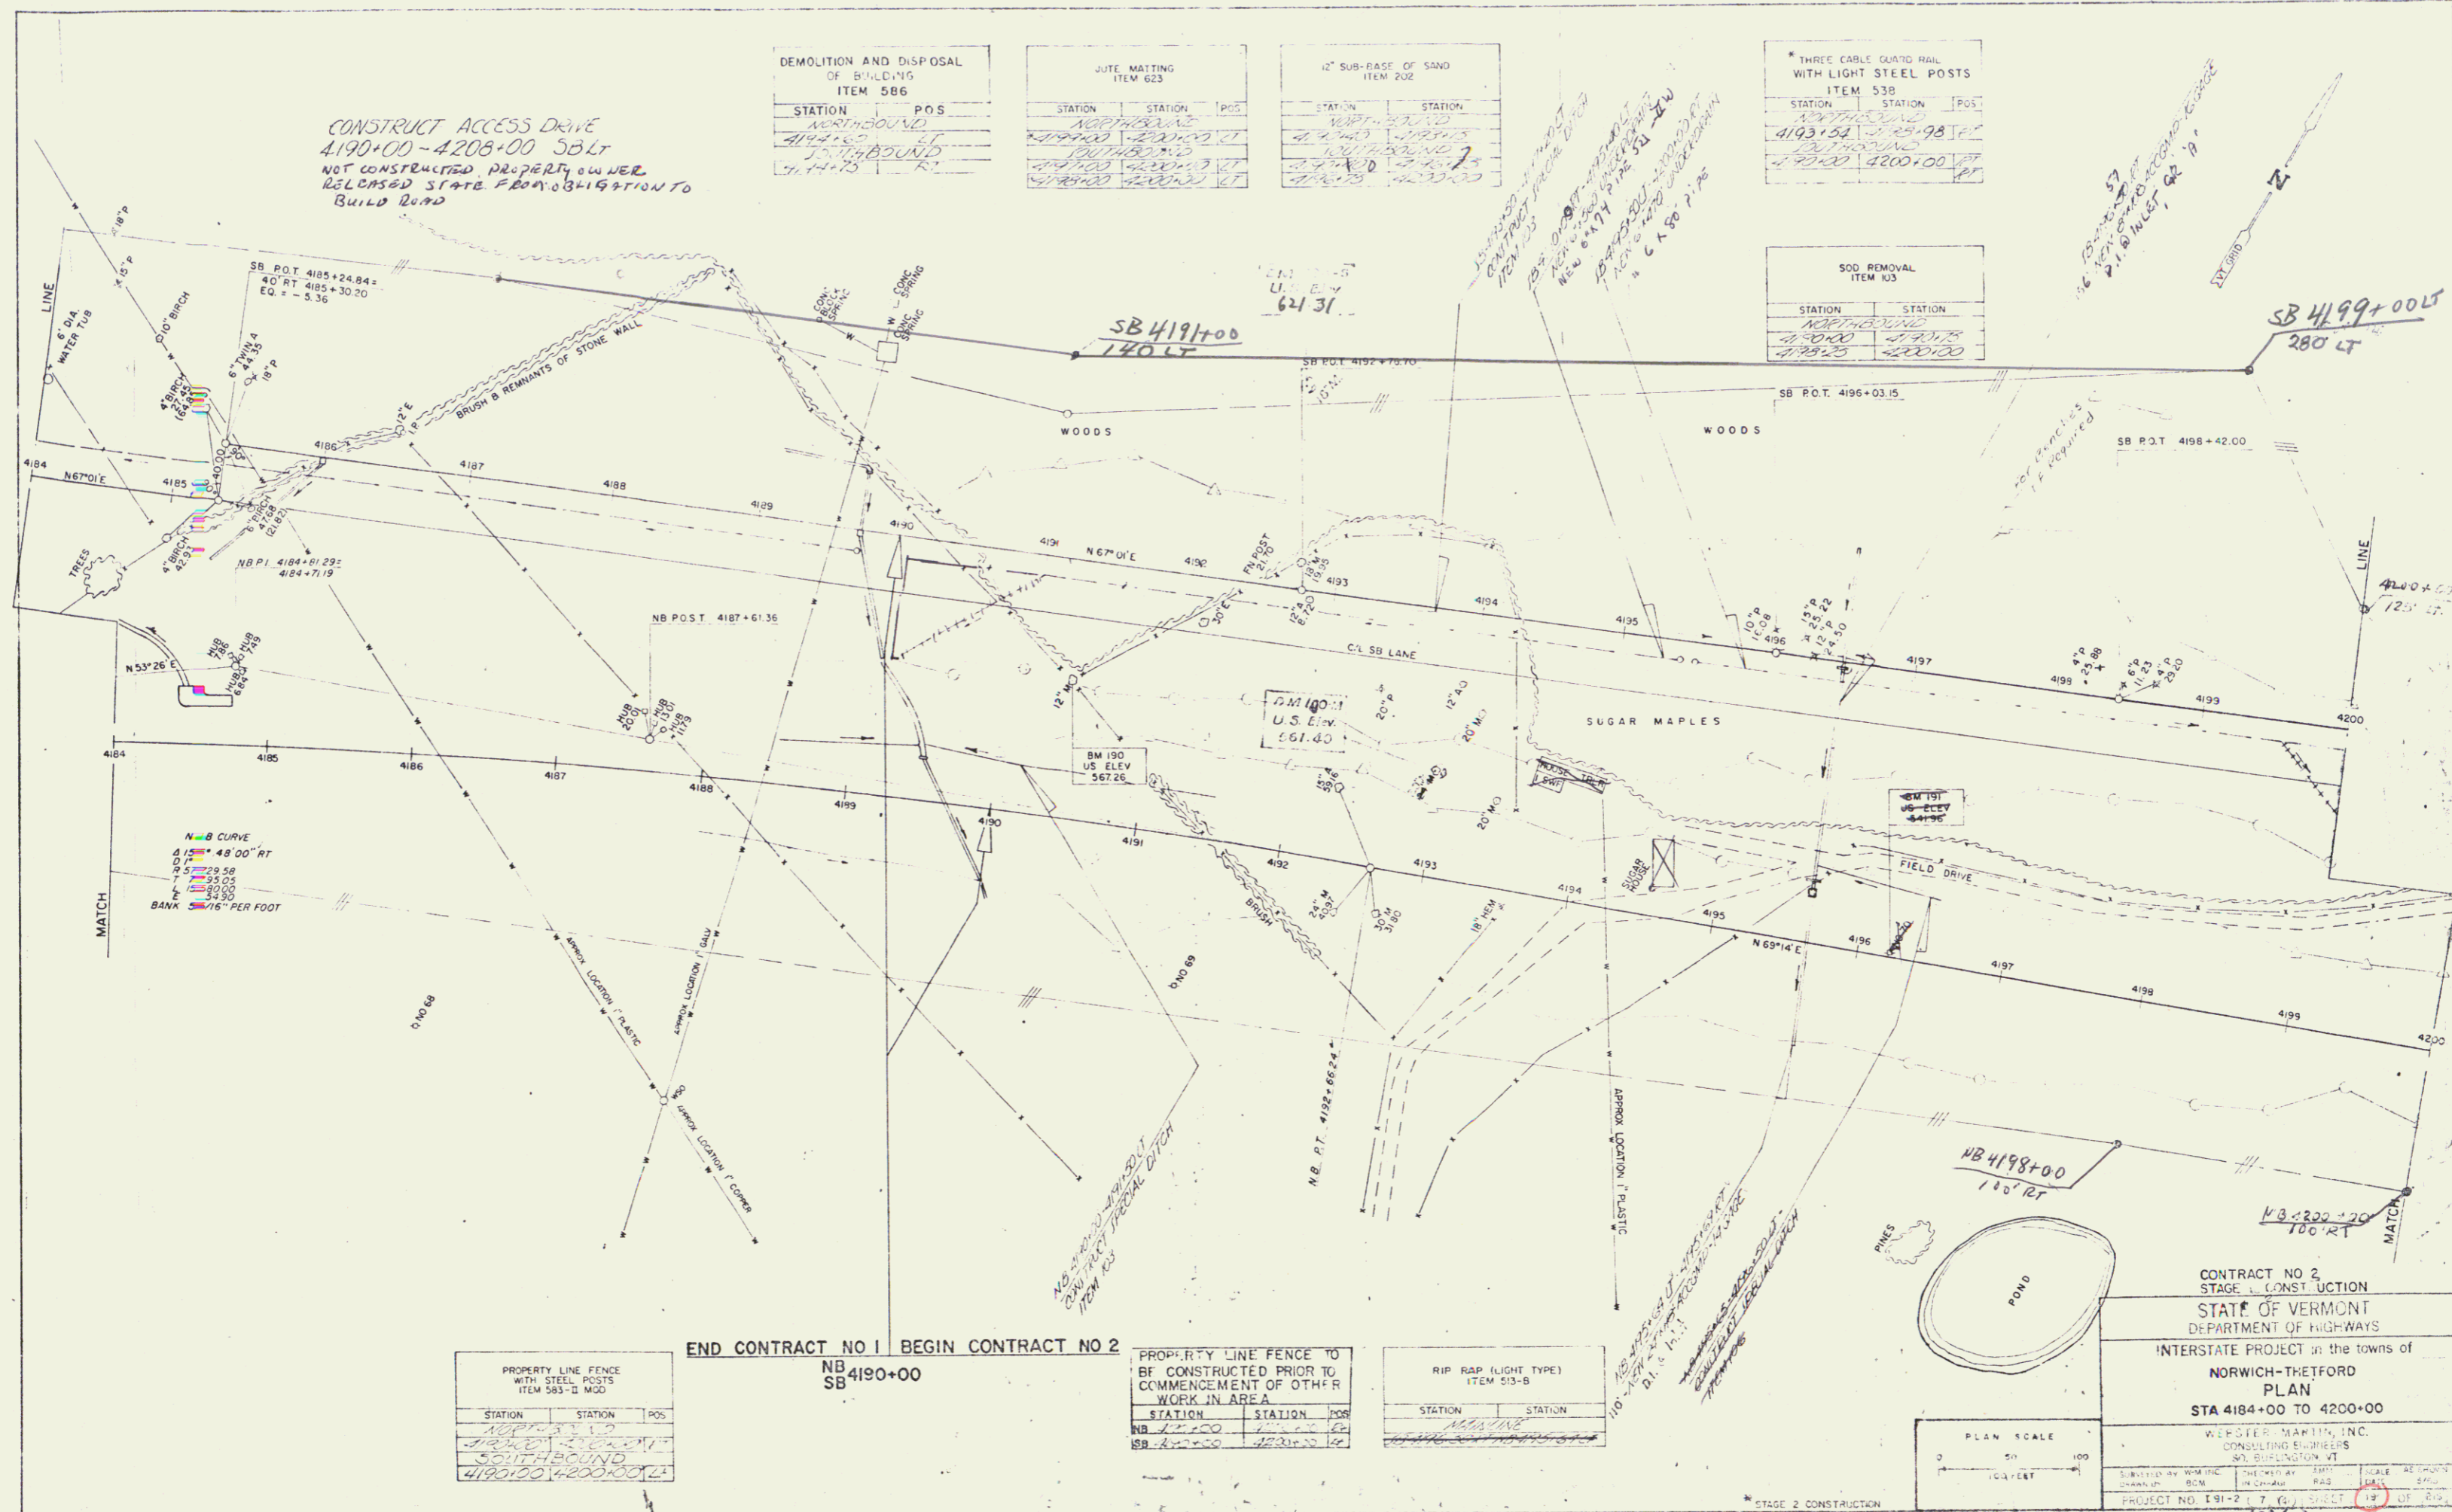


N-B CURVE
 48'00" RT
 100' RT
 BANK 16" PER FOOT

PROPERTY LINE FENCE WITH STEEL POSTS ITEM 583-D MOD		
STATION	STATION	P.O.S.
4190+00	4191+00	
4191+00	4192+00	
4192+00	4193+00	
4193+00	4194+00	
4194+00	4195+00	
4195+00	4196+00	
4196+00	4197+00	
4197+00	4198+00	
4198+00	4199+00	
4199+00	4200+00	

END CONTRACT NO 1 BEGIN CONTRACT NO 2
NB 4190+00
SB

PROPERTY LINE FENCE TO BE CONSTRUCTED PRIOR TO COMMENCEMENT OF OTHER WORK IN AREA		
STATION	STATION	P.O.S.
NB 4190+00	4191+00	
SB 4190+00	4191+00	

RIP RAP (LIGHT TYPE) ITEM 513-B		
STATION	STATION	P.O.S.
4190+00	4191+00	
4191+00	4192+00	
4192+00	4193+00	
4193+00	4194+00	
4194+00	4195+00	
4195+00	4196+00	
4196+00	4197+00	
4197+00	4198+00	
4198+00	4199+00	
4199+00	4200+00	

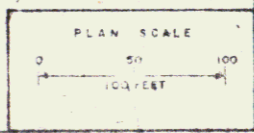

CONTRACT NO 2
 STAGE 1 CONSTRUCTION
 STATE OF VERMONT
 DEPARTMENT OF HIGHWAYS
 INTERSTATE PROJECT in the towns of
 NORWICH-THETFORD
 PLAN
 STA 4184+00 TO 4200+00

DESIGNED BY	DATE	SCALE	REVISION
WEDGER MARTIN, INC.	08/11/91	1" = 40' RT	
CHECKED BY	DATE	SCALE	REVISION
WEDGER MARTIN, INC.	08/11/91	1" = 40' RT	
PROJECT NO.	SHEET NO.	TOTAL SHEETS	
191-2	7	13	

(7) (41)