

* JUTE MATTING
ITEM 623

STATION	STATION	POS
4200+00	4200+00	RT
4200+00	4200+00	LT
4200+50	4200+50	RT
4200+50	4200+50	LT
4201+00	4201+00	RT
4201+00	4201+00	LT
4201+50	4201+50	RT
4201+50	4201+50	LT
4202+00	4202+00	RT
4202+00	4202+00	LT
4202+50	4202+50	RT
4202+50	4202+50	LT
4203+00	4203+00	RT
4203+00	4203+00	LT
4203+50	4203+50	RT
4203+50	4203+50	LT
4204+00	4204+00	RT
4204+00	4204+00	LT
4204+50	4204+50	RT
4204+50	4204+50	LT
4205+00	4205+00	RT
4205+00	4205+00	LT
4205+50	4205+50	RT
4205+50	4205+50	LT
4206+00	4206+00	RT
4206+00	4206+00	LT
4206+50	4206+50	RT
4206+50	4206+50	LT
4207+00	4207+00	RT
4207+00	4207+00	LT
4207+50	4207+50	RT
4207+50	4207+50	LT
4208+00	4208+00	RT
4208+00	4208+00	LT
4208+50	4208+50	RT
4208+50	4208+50	LT
4209+00	4209+00	RT
4209+00	4209+00	LT
4209+50	4209+50	RT
4209+50	4209+50	LT
4210+00	4210+00	RT
4210+00	4210+00	LT
4210+50	4210+50	RT
4210+50	4210+50	LT
4211+00	4211+00	RT
4211+00	4211+00	LT
4211+50	4211+50	RT
4211+50	4211+50	LT
4212+00	4212+00	RT
4212+00	4212+00	LT
4212+50	4212+50	RT
4212+50	4212+50	LT
4213+00	4213+00	RT
4213+00	4213+00	LT
4213+50	4213+50	RT
4213+50	4213+50	LT
4214+00	4214+00	RT
4214+00	4214+00	LT
4214+50	4214+50	RT
4214+50	4214+50	LT
4215+00	4215+00	RT
4215+00	4215+00	LT
4215+50	4215+50	RT
4215+50	4215+50	LT
4216+00	4216+00	RT
4216+00	4216+00	LT

STONE FILL FOR SLOPE PROTECTION (LIGHT TYPE)
ITEM 56

STATION	STATION	POS
4200+00	4200+00	RT
4200+00	4200+00	LT
4200+50	4200+50	RT
4200+50	4200+50	LT
4201+00	4201+00	RT
4201+00	4201+00	LT
4201+50	4201+50	RT
4201+50	4201+50	LT
4202+00	4202+00	RT
4202+00	4202+00	LT
4202+50	4202+50	RT
4202+50	4202+50	LT
4203+00	4203+00	RT
4203+00	4203+00	LT
4203+50	4203+50	RT
4203+50	4203+50	LT
4204+00	4204+00	RT
4204+00	4204+00	LT
4204+50	4204+50	RT
4204+50	4204+50	LT
4205+00	4205+00	RT
4205+00	4205+00	LT
4205+50	4205+50	RT
4205+50	4205+50	LT
4206+00	4206+00	RT
4206+00	4206+00	LT
4206+50	4206+50	RT
4206+50	4206+50	LT
4207+00	4207+00	RT
4207+00	4207+00	LT
4207+50	4207+50	RT
4207+50	4207+50	LT
4208+00	4208+00	RT
4208+00	4208+00	LT
4208+50	4208+50	RT
4208+50	4208+50	LT
4209+00	4209+00	RT
4209+00	4209+00	LT
4209+50	4209+50	RT
4209+50	4209+50	LT
4210+00	4210+00	RT
4210+00	4210+00	LT
4210+50	4210+50	RT
4210+50	4210+50	LT
4211+00	4211+00	RT
4211+00	4211+00	LT
4211+50	4211+50	RT
4211+50	4211+50	LT
4212+00	4212+00	RT
4212+00	4212+00	LT
4212+50	4212+50	RT
4212+50	4212+50	LT
4213+00	4213+00	RT
4213+00	4213+00	LT
4213+50	4213+50	RT
4213+50	4213+50	LT
4214+00	4214+00	RT
4214+00	4214+00	LT
4214+50	4214+50	RT
4214+50	4214+50	LT
4215+00	4215+00	RT
4215+00	4215+00	LT
4215+50	4215+50	RT
4215+50	4215+50	LT
4216+00	4216+00	RT
4216+00	4216+00	LT

* THREE CABLE GUARD RAIL WITH LIGHT STEEL POSTS
ITEM 53B

STATION	STATION	POS
4200+00	4200+00	RT
4200+00	4200+00	LT
4200+50	4200+50	RT
4200+50	4200+50	LT
4201+00	4201+00	RT
4201+00	4201+00	LT
4201+50	4201+50	RT
4201+50	4201+50	LT
4202+00	4202+00	RT
4202+00	4202+00	LT
4202+50	4202+50	RT
4202+50	4202+50	LT
4203+00	4203+00	RT
4203+00	4203+00	LT
4203+50	4203+50	RT
4203+50	4203+50	LT
4204+00	4204+00	RT
4204+00	4204+00	LT
4204+50	4204+50	RT
4204+50	4204+50	LT
4205+00	4205+00	RT
4205+00	4205+00	LT
4205+50	4205+50	RT
4205+50	4205+50	LT
4206+00	4206+00	RT
4206+00	4206+00	LT
4206+50	4206+50	RT
4206+50	4206+50	LT
4207+00	4207+00	RT
4207+00	4207+00	LT
4207+50	4207+50	RT
4207+50	4207+50	LT
4208+00	4208+00	RT
4208+00	4208+00	LT
4208+50	4208+50	RT
4208+50	4208+50	LT
4209+00	4209+00	RT
4209+00	4209+00	LT
4209+50	4209+50	RT
4209+50	4209+50	LT
4210+00	4210+00	RT
4210+00	4210+00	LT
4210+50	4210+50	RT
4210+50	4210+50	LT
4211+00	4211+00	RT
4211+00	4211+00	LT
4211+50	4211+50	RT
4211+50	4211+50	LT
4212+00	4212+00	RT
4212+00	4212+00	LT
4212+50	4212+50	RT
4212+50	4212+50	LT
4213+00	4213+00	RT
4213+00	4213+00	LT
4213+50	4213+50	RT
4213+50	4213+50	LT
4214+00	4214+00	RT
4214+00	4214+00	LT
4214+50	4214+50	RT
4214+50	4214+50	LT
4215+00	4215+00	RT
4215+00	4215+00	LT
4215+50	4215+50	RT
4215+50	4215+50	LT
4216+00	4216+00	RT
4216+00	4216+00	LT

900 REMOVAL
ITEM 103

STATION	STATION
4201+25	4203+75

12" SUB-BASE OF SAND
ITEM 202

STATION	STATION
4200+00	4200+10

PROPERTY LINE FENCE WITH STEEL POSTS
ITEM 583-II MOD

STATION	STATION	POS
4200+00	4206+00	RT
4200+00	4206+00	LT
4200+50	4206+50	RT
4200+50	4206+50	LT
4201+00	4207+00	RT
4201+00	4207+00	LT
4201+50	4207+50	RT
4201+50	4207+50	LT
4202+00	4208+00	RT
4202+00	4208+00	LT
4202+50	4208+50	RT
4202+50	4208+50	LT
4203+00	4209+00	RT
4203+00	4209+00	LT
4203+50	4209+50	RT
4203+50	4209+50	LT
4204+00	4210+00	RT
4204+00	4210+00	LT
4204+50	4210+50	RT
4204+50	4210+50	LT
4205+00	4211+00	RT
4205+00	4211+00	LT
4205+50	4211+50	RT
4205+50	4211+50	LT
4206+00	4212+00	RT
4206+00	4212+00	LT
4206+50	4212+50	RT
4206+50	4212+50	LT
4207+00	4213+00	RT
4207+00	4213+00	LT
4207+50	4213+50	RT
4207+50	4213+50	LT
4208+00	4214+00	RT
4208+00	4214+00	LT
4208+50	4214+50	RT
4208+50	4214+50	LT
4209+00	4215+00	RT
4209+00	4215+00	LT
4209+50	4215+50	RT
4209+50	4215+50	LT
4210+00	4216+00	RT
4210+00	4216+00	LT
4210+50	4216+50	RT
4210+50	4216+50	LT

CONTRACT NO 2
STAGE 1 CONSTRUCTION


STATE OF VERMONT
DEPARTMENT OF HIGHWAYS

INTERSTATE PROJECT IN THE TOWNS OF
NORWICH-THETFORD
PLAN
STA 4200+00 TO 4216+00

WEBSTER-MARTIN, INC.
CONSULTING ENGINEERS
50, BURLINGTON, VT.

SURVEYED BY: W.M. INC. CHECKED BY: R.M. INC. SCALE: AS SHOWN
DRAWN BY: B.C.M. IN CHARGE: R.S.S. DATE: 5-58

PROJECT NO. I 91-2 (7) SHEET 21 OF 219

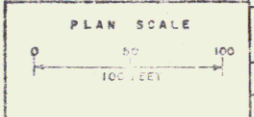

* STAGE 2 CONSTRUCTION