
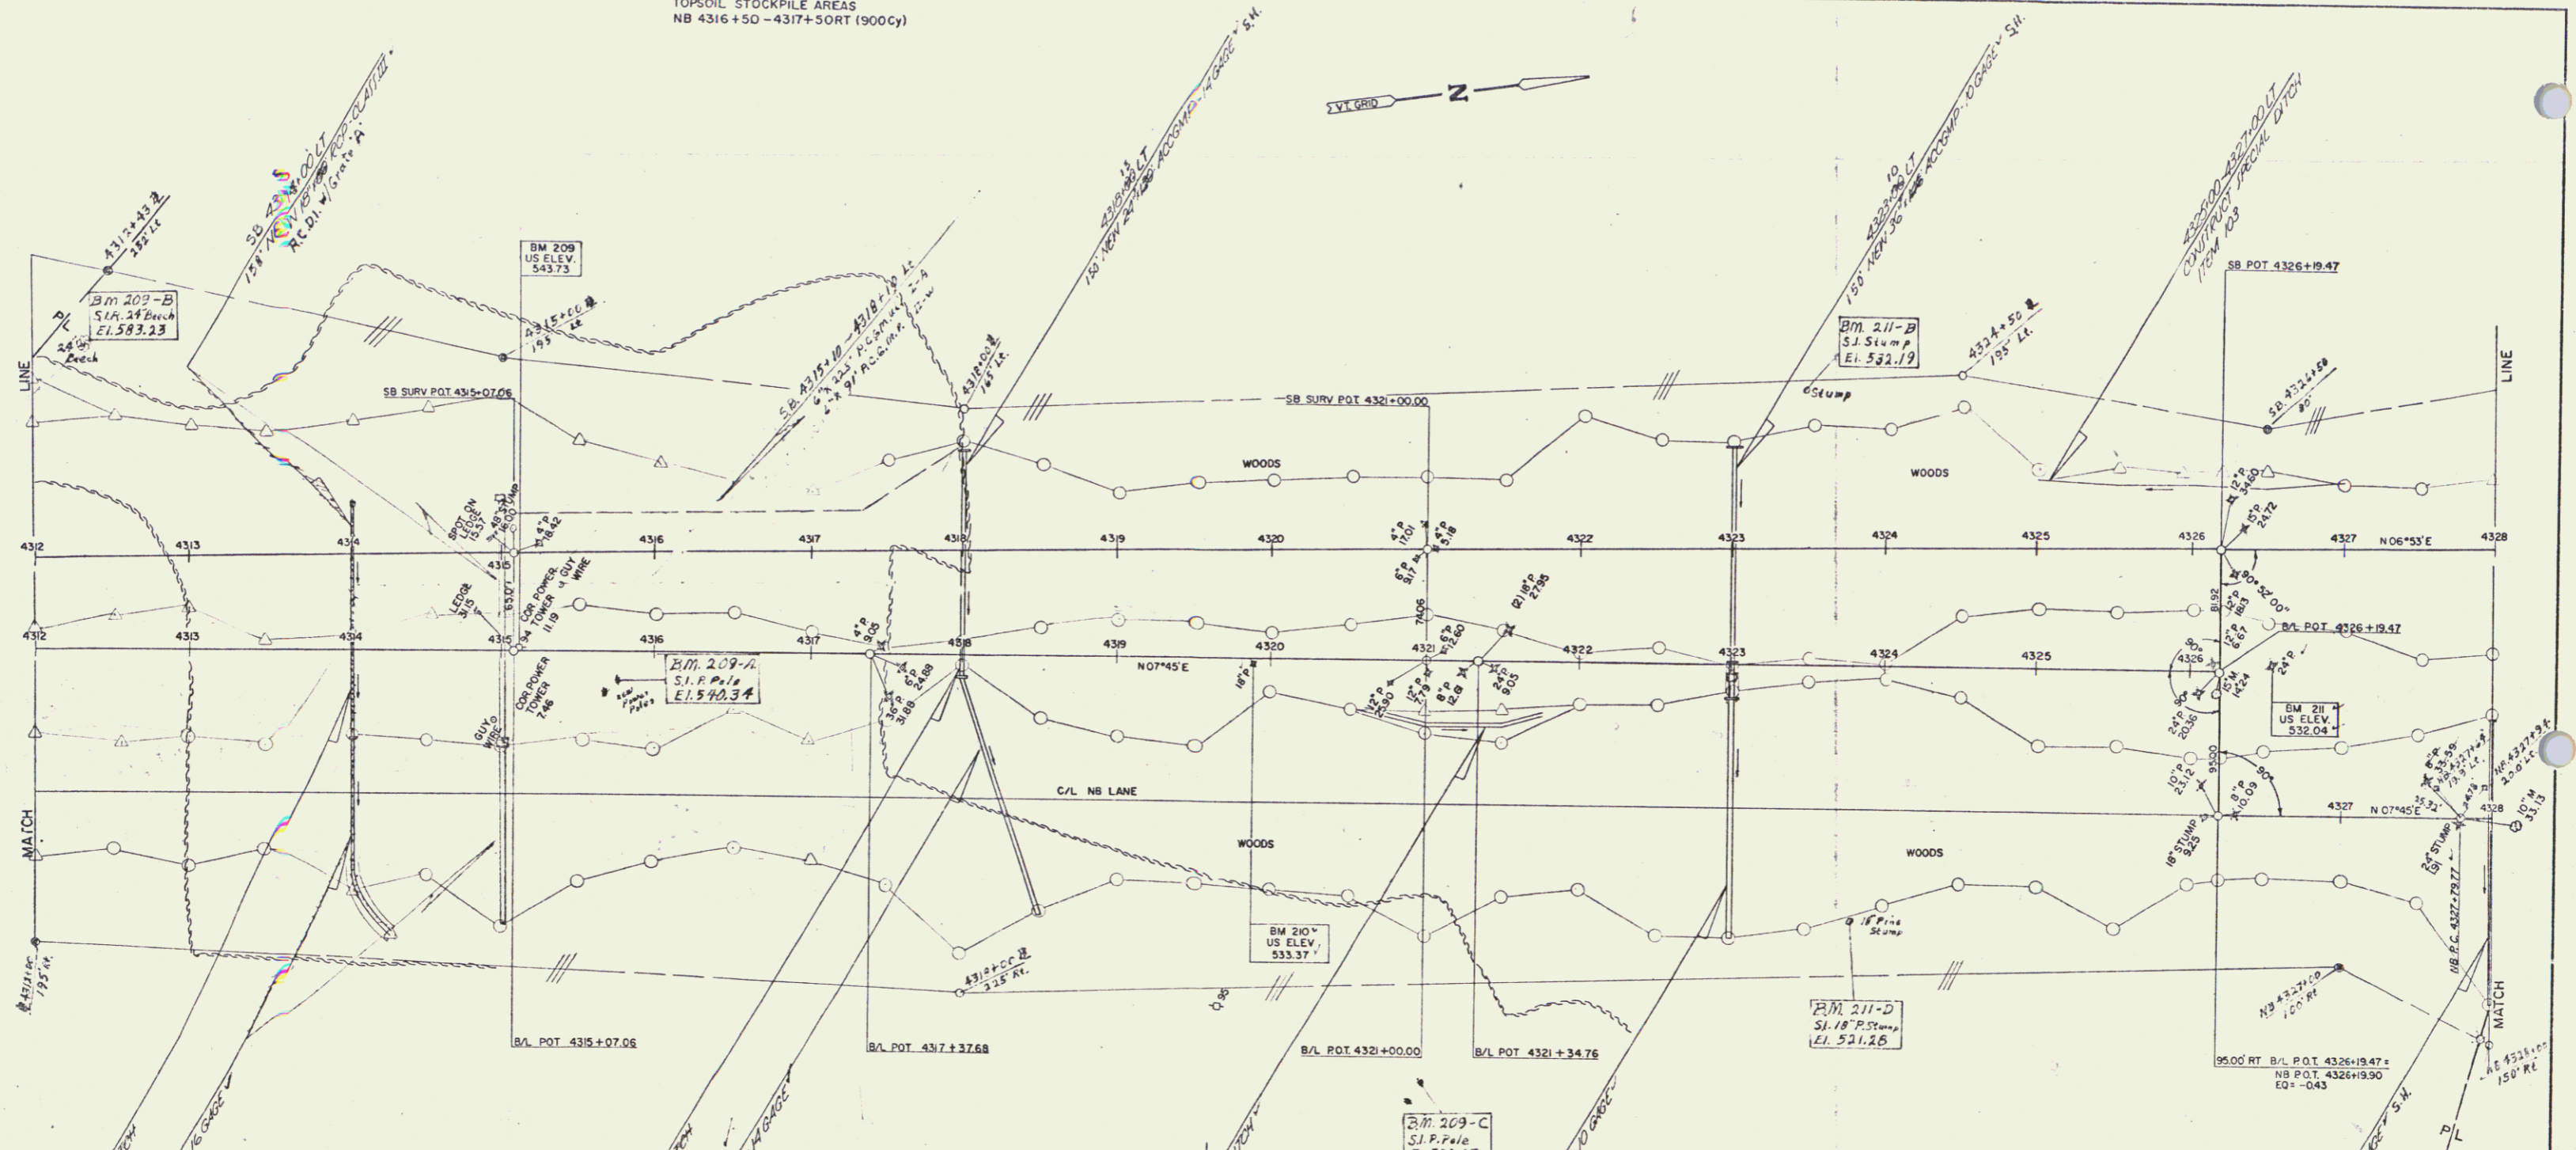


TOPSOIL STOCKPILE AREAS
NB 4316+50 - 4317+50 RT (900 Cy)

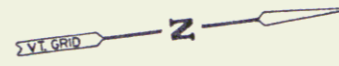

STONE FILL FOR SLOPE PROTECTION (LIGHT TYPE) ITEM 502

STATION	STATION	POS
4317+00	4318+00	LT
4318+00	4319+00	RT
4319+00	4320+00	LT
4320+00	4321+00	RT
4321+00	4322+00	LT
4322+00	4323+00	RT
4323+00	4324+00	LT
4324+00	4325+00	RT
4325+00	4326+00	LT
4326+00	4327+00	RT
4327+00	4328+00	LT

PROPERTY LINE FENCE TO BE CONSTRUCTED PRIOR TO COMMENCEMENT OF OTHER WORK IN THIS AREA
BL 4312+00 - 4321+50 RT.
BL 4312+00 - 4319+50 LT.

MUCK EXCAVATION ITEM 117

STATION	STATION
NORTHBOUND	4322+00 - 4324+00
SOUTHBOUND	4322+00 - 4324+00

RIPRAP (LIGHT TYPE) ITEM 513-B

STATION	POSITION
4317+00	RT
4318+00	RT
4319+00	RT
4320+00	RT
4321+00	RT

SOD REMOVAL ITEM 103

STATION	STATION
NORTHBOUND	4313+00 - 4314+00
SOUTHBOUND	4313+00 - 4314+00

***THREE CABLE GUARD RAIL WITH LIGHT STEEL POSTS ITEM 53B**

STATION	STATION	POS
4317+00	4319+50	RT
4321+00	4323+50	RT
4327+00	4328+00	RT


PROPERTY LINE FENCE WITH STEEL POSTS ITEM 583-II MOD

STATION	STATION	POS
4312+00	4320+00	RT
4320+00	4328+00	RT

DRILLING AND SLASTING OF SOLID ROCK SUBGRADE ITEM 115

STATION	STATION
4320+00	4321+50
4322+00	4323+50

CONTRACT NO 3
STAGE 1 CONSTRUCTION
STATE OF VERMONT
DEPARTMENT OF HIGHWAYS
INTERSTATE PROJECT IN THE TOWNS OF
NORWICH-THETFORD
PLAN
STA 4312+00 TO 4328+00
WEBSTER MARTIN INC.
CONSULTING ENGINEERS
100 BURLINGTON ST.
BURLINGTON, VT
DESIGNED BY W.M. AND E.M. ENGINEERING FIRM SCALE AS SHOWN
CHECKED BY G.M. ENGINEERING FIRM SCALE AS SHOWN
PRODUCT NO. 19-2 (7) (2) SHEET 24 OF 254

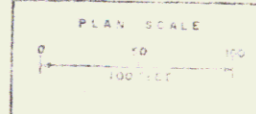

*STAGE 2 CONSTRUCTION