


STONE FILL FOR SLOPE PROTECTION (LIGHT TYPE) ITEM 512		
STATION	STATION	POS
4328+00	4328+00	LT
4328+50	4328+50	LT
4329+00	4329+00	LT
4329+50	4329+50	LT
4330+00	4330+00	LT
4330+50	4330+50	LT
4331+00	4331+00	LT
4331+50	4331+50	LT
4332+00	4332+00	LT
4332+50	4332+50	LT
4333+00	4333+00	LT
4333+50	4333+50	LT
4334+00	4334+00	LT
4334+50	4334+50	LT
4335+00	4335+00	LT
4335+50	4335+50	LT
4336+00	4336+00	LT
4336+50	4336+50	LT
4337+00	4337+00	LT
4337+50	4337+50	LT
4338+00	4338+00	LT
4338+50	4338+50	LT
4339+00	4339+00	LT
4339+50	4339+50	LT
4340+00	4340+00	LT
4340+50	4340+50	LT
4341+00	4341+00	LT
4341+50	4341+50	LT
4342+00	4342+00	LT
4342+50	4342+50	LT
4343+00	4343+00	LT
4343+50	4343+50	LT
4344+00	4344+00	LT
4344+50	4344+50	LT

TREATED TIMBER CURB ITEM 558		
STATION	STATION	POS
4328+00	4328+00	LT
4328+50	4328+50	LT
4329+00	4329+00	LT
4329+50	4329+50	LT
4330+00	4330+00	LT
4330+50	4330+50	LT
4331+00	4331+00	LT
4331+50	4331+50	LT
4332+00	4332+00	LT
4332+50	4332+50	LT
4333+00	4333+00	LT
4333+50	4333+50	LT
4334+00	4334+00	LT
4334+50	4334+50	LT
4335+00	4335+00	LT
4335+50	4335+50	LT
4336+00	4336+00	LT
4336+50	4336+50	LT
4337+00	4337+00	LT
4337+50	4337+50	LT
4338+00	4338+00	LT
4338+50	4338+50	LT
4339+00	4339+00	LT
4339+50	4339+50	LT
4340+00	4340+00	LT
4340+50	4340+50	LT
4341+00	4341+00	LT
4341+50	4341+50	LT
4342+00	4342+00	LT
4342+50	4342+50	LT
4343+00	4343+00	LT
4343+50	4343+50	LT
4344+00	4344+00	LT
4344+50	4344+50	LT

PROPERTY LINE FENCE TO BE CONSTRUCTED PRIOR TO COMMENCEMENT OF OTHER WORK IN THIS AREA  
NB 4328+50 - 4344+00 RT.

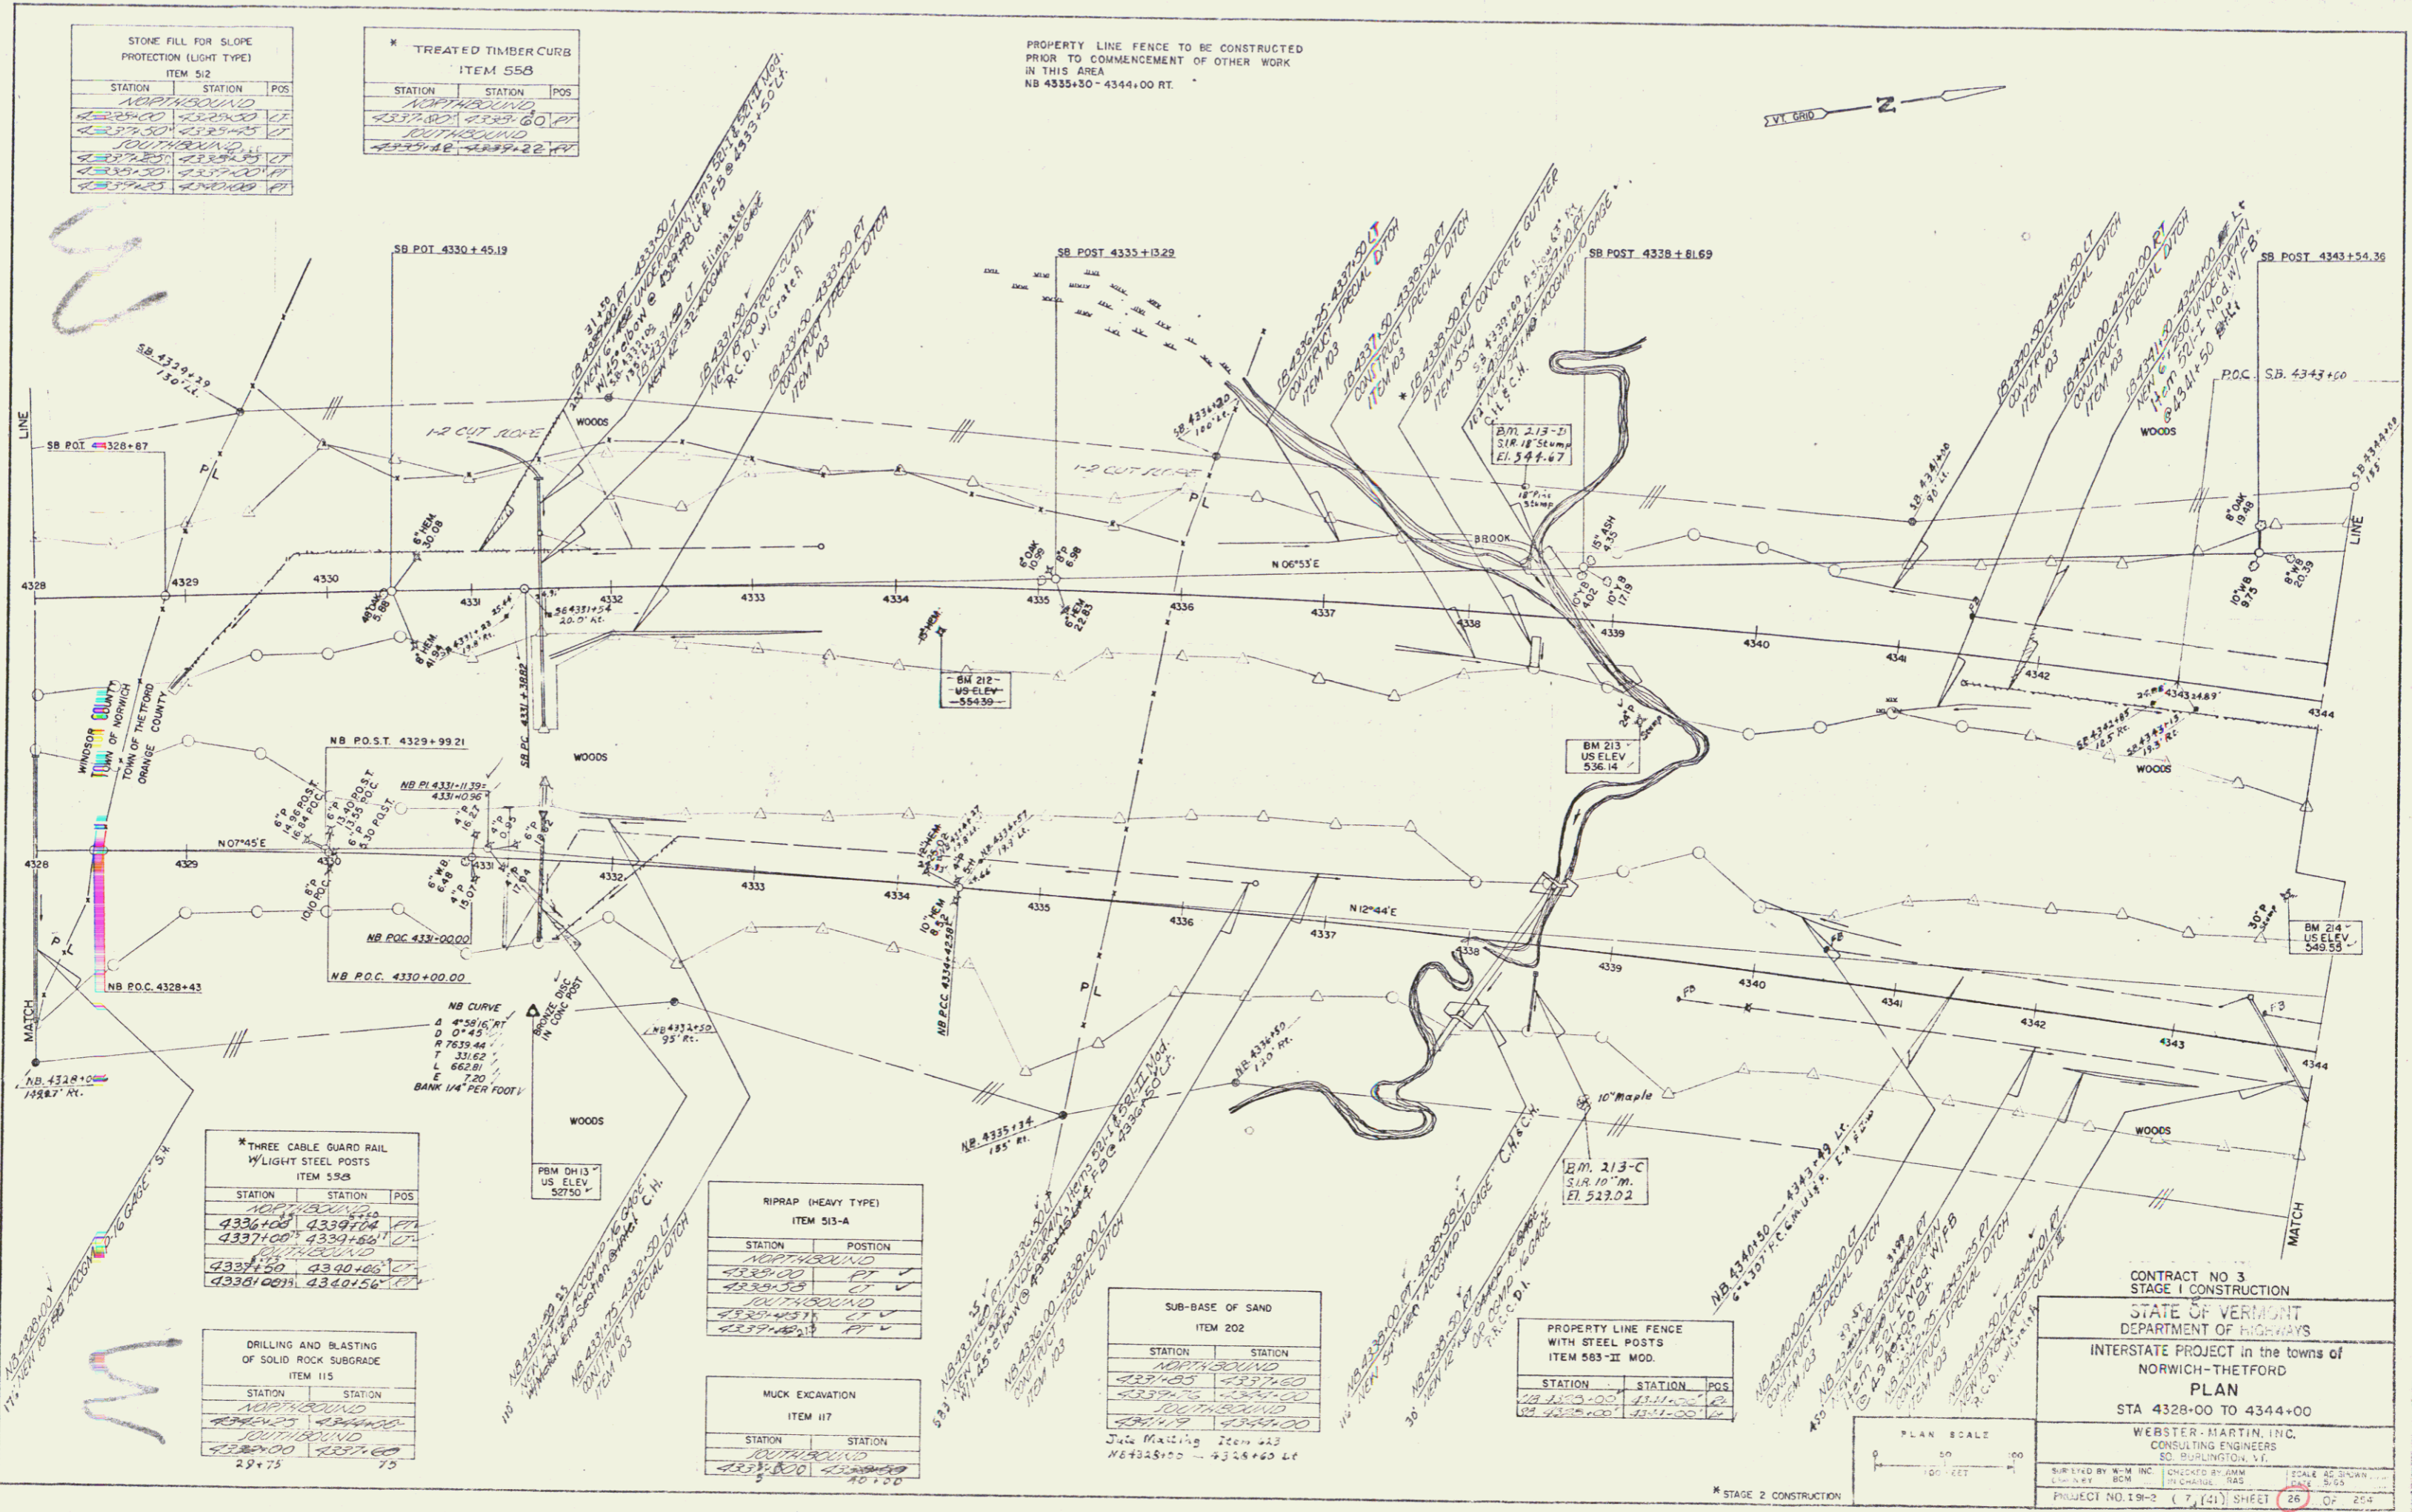

THREE CABLE GUARD RAIL WITH LIGHT STEEL POSTS ITEM 528		
STATION	STATION	POS
4336+00	4336+00	LT
4337+00	4337+00	LT
4337+50	4337+50	LT
4338+00	4338+00	LT
4338+50	4338+50	LT
4339+00	4339+00	LT
4339+50	4339+50	LT
4340+00	4340+00	LT
4340+50	4340+50	LT
4341+00	4341+00	LT
4341+50	4341+50	LT
4342+00	4342+00	LT
4342+50	4342+50	LT
4343+00	4343+00	LT
4343+50	4343+50	LT
4344+00	4344+00	LT
4344+50	4344+50	LT

DRILLING AND BLASTING OF SOLID ROCK SUBGRADE ITEM 115		
STATION	STATION	POS
4328+00	4328+00	LT
4328+50	4328+50	LT
4329+00	4329+00	LT
4329+50	4329+50	LT
4330+00	4330+00	LT
4330+50	4330+50	LT
4331+00	4331+00	LT
4331+50	4331+50	LT
4332+00	4332+00	LT
4332+50	4332+50	LT
4333+00	4333+00	LT
4333+50	4333+50	LT
4334+00	4334+00	LT
4334+50	4334+50	LT
4335+00	4335+00	LT
4335+50	4335+50	LT
4336+00	4336+00	LT
4336+50	4336+50	LT
4337+00	4337+00	LT
4337+50	4337+50	LT
4338+00	4338+00	LT
4338+50	4338+50	LT
4339+00	4339+00	LT
4339+50	4339+50	LT
4340+00	4340+00	LT
4340+50	4340+50	LT
4341+00	4341+00	LT
4341+50	4341+50	LT
4342+00	4342+00	LT
4342+50	4342+50	LT
4343+00	4343+00	LT
4343+50	4343+50	LT
4344+00	4344+00	LT
4344+50	4344+50	LT


RIPRAP (HEAVY TYPE) ITEM 513-A		
STATION	STATION	POS
4328+00	4328+00	LT
4328+50	4328+50	LT
4329+00	4329+00	LT
4329+50	4329+50	LT
4330+00	4330+00	LT
4330+50	4330+50	LT
4331+00	4331+00	LT
4331+50	4331+50	LT
4332+00	4332+00	LT
4332+50	4332+50	LT
4333+00	4333+00	LT
4333+50	4333+50	LT
4334+00	4334+00	LT
4334+50	4334+50	LT
4335+00	4335+00	LT
4335+50	4335+50	LT
4336+00	4336+00	LT
4336+50	4336+50	LT
4337+00	4337+00	LT
4337+50	4337+50	LT
4338+00	4338+00	LT
4338+50	4338+50	LT
4339+00	4339+00	LT
4339+50	4339+50	LT
4340+00	4340+00	LT
4340+50	4340+50	LT
4341+00	4341+00	LT
4341+50	4341+50	LT
4342+00	4342+00	LT
4342+50	4342+50	LT
4343+00	4343+00	LT
4343+50	4343+50	LT
4344+00	4344+00	LT
4344+50	4344+50	LT

MUCK EXCAVATION ITEM 117		
STATION	STATION	POS
4328+00	4328+00	LT
4328+50	4328+50	LT
4329+00	4329+00	LT
4329+50	4329+50	LT
4330+00	4330+00	LT
4330+50	4330+50	LT
4331+00	4331+00	LT
4331+50	4331+50	LT
4332+00	4332+00	LT
4332+50	4332+50	LT
4333+00	4333+00	LT
4333+50	4333+50	LT
4334+00	4334+00	LT
4334+50	4334+50	LT
4335+00	4335+00	LT
4335+50	4335+50	LT
4336+00	4336+00	LT
4336+50	4336+50	LT
4337+00	4337+00	LT
4337+50	4337+50	LT
4338+00	4338+00	LT
4338+50	4338+50	LT
4339+00	4339+00	LT
4339+50	4339+50	LT
4340+00	4340+00	LT
4340+50	4340+50	LT
4341+00	4341+00	LT
4341+50	4341+50	LT
4342+00	4342+00	LT
4342+50	4342+50	LT
4343+00	4343+00	LT
4343+50	4343+50	LT
4344+00	4344+00	LT
4344+50	4344+50	LT

SUB-BASE OF SAND ITEM 202		
STATION	STATION	POS
4328+00	4328+00	LT
4328+50	4328+50	LT
4329+00	4329+00	LT
4329+50	4329+50	LT
4330+00	4330+00	LT
4330+50	4330+50	LT
4331+00	4331+00	LT
4331+50	4331+50	LT
4332+00	4332+00	LT
4332+50	4332+50	LT
4333+00	4333+00	LT
4333+50	4333+50	LT
4334+00	4334+00	LT
4334+50	4334+50	LT
4335+00	4335+00	LT
4335+50	4335+50	LT
4336+00	4336+00	LT
4336+50	4336+50	LT
4337+00	4337+00	LT
4337+50	4337+50	LT
4338+00	4338+00	LT
4338+50	4338+50	LT
4339+00	4339+00	LT
4339+50	4339+50	LT
4340+00	4340+00	LT
4340+50	4340+50	LT
4341+00	4341+00	LT
4341+50	4341+50	LT
4342+00	4342+00	LT
4342+50	4342+50	LT
4343+00	4343+00	LT
4343+50	4343+50	LT
4344+00	4344+00	LT
4344+50	4344+50	LT

PROPERTY LINE FENCE WITH STEEL POSTS ITEM 583-II MOD.		
STATION	STATION	POS
4328+00	4328+00	LT
4328+50	4328+50	LT
4329+00	4329+00	LT
4329+50	4329+50	LT
4330+00	4330+00	LT
4330+50	4330+50	LT
4331+00	4331+00	LT
4331+50	4331+50	LT
4332+00	4332+00	LT
4332+50	4332+50	LT
4333+00	4333+00	LT
4333+50	4333+50	LT
4334+00	4334+00	LT
4334+50	4334+50	LT
4335+00	4335+00	LT
4335+50	4335+50	LT
4336+00	4336+00	LT
4336+50	4336+50	LT
4337+00	4337+00	LT
4337+50	4337+50	LT
4338+00	4338+00	LT
4338+50	4338+50	LT
4339+00	4339+00	LT
4339+50	4339+50	LT
4340+00	4340+00	LT
4340+50	4340+50	LT
4341+00	4341+00	LT
4341+50	4341+50	LT
4342+00	4342+00	LT
4342+50	4342+50	LT
4343+00	4343+00	LT
4343+50	4343+50	LT
4344+00	4344+00	LT
4344+50	4344+50	LT

CONTRACT NO 3  
STAGE I CONSTRUCTION  
STATE OF VERMONT  
DEPARTMENT OF HIGHWAYS  
INTERSTATE PROJECT in the towns of  
NORWICH-THETFORD  
PLAN  
STA 4328+00 TO 4344+00  
WEBSTER-MARTIN, INC.  
CONSULTING ENGINEERS  
50 WASHINGTON VT.  
SCALE AS SHOWN  
PROJECT NO. 198-3 (7, 21) SHEET 26 OF 254

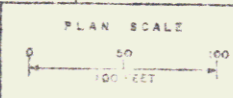

STAGE 2 CONSTRUCTION