



PLAN  
 CHECKED BY: [Signature]  
 DATE: [Date]  
 DRAWN BY: [Signature]  
 DATE: [Date]

PROFILE  
 CHECKED BY: [Signature]  
 DATE: [Date]  
 DRAWN BY: [Signature]  
 DATE: [Date]

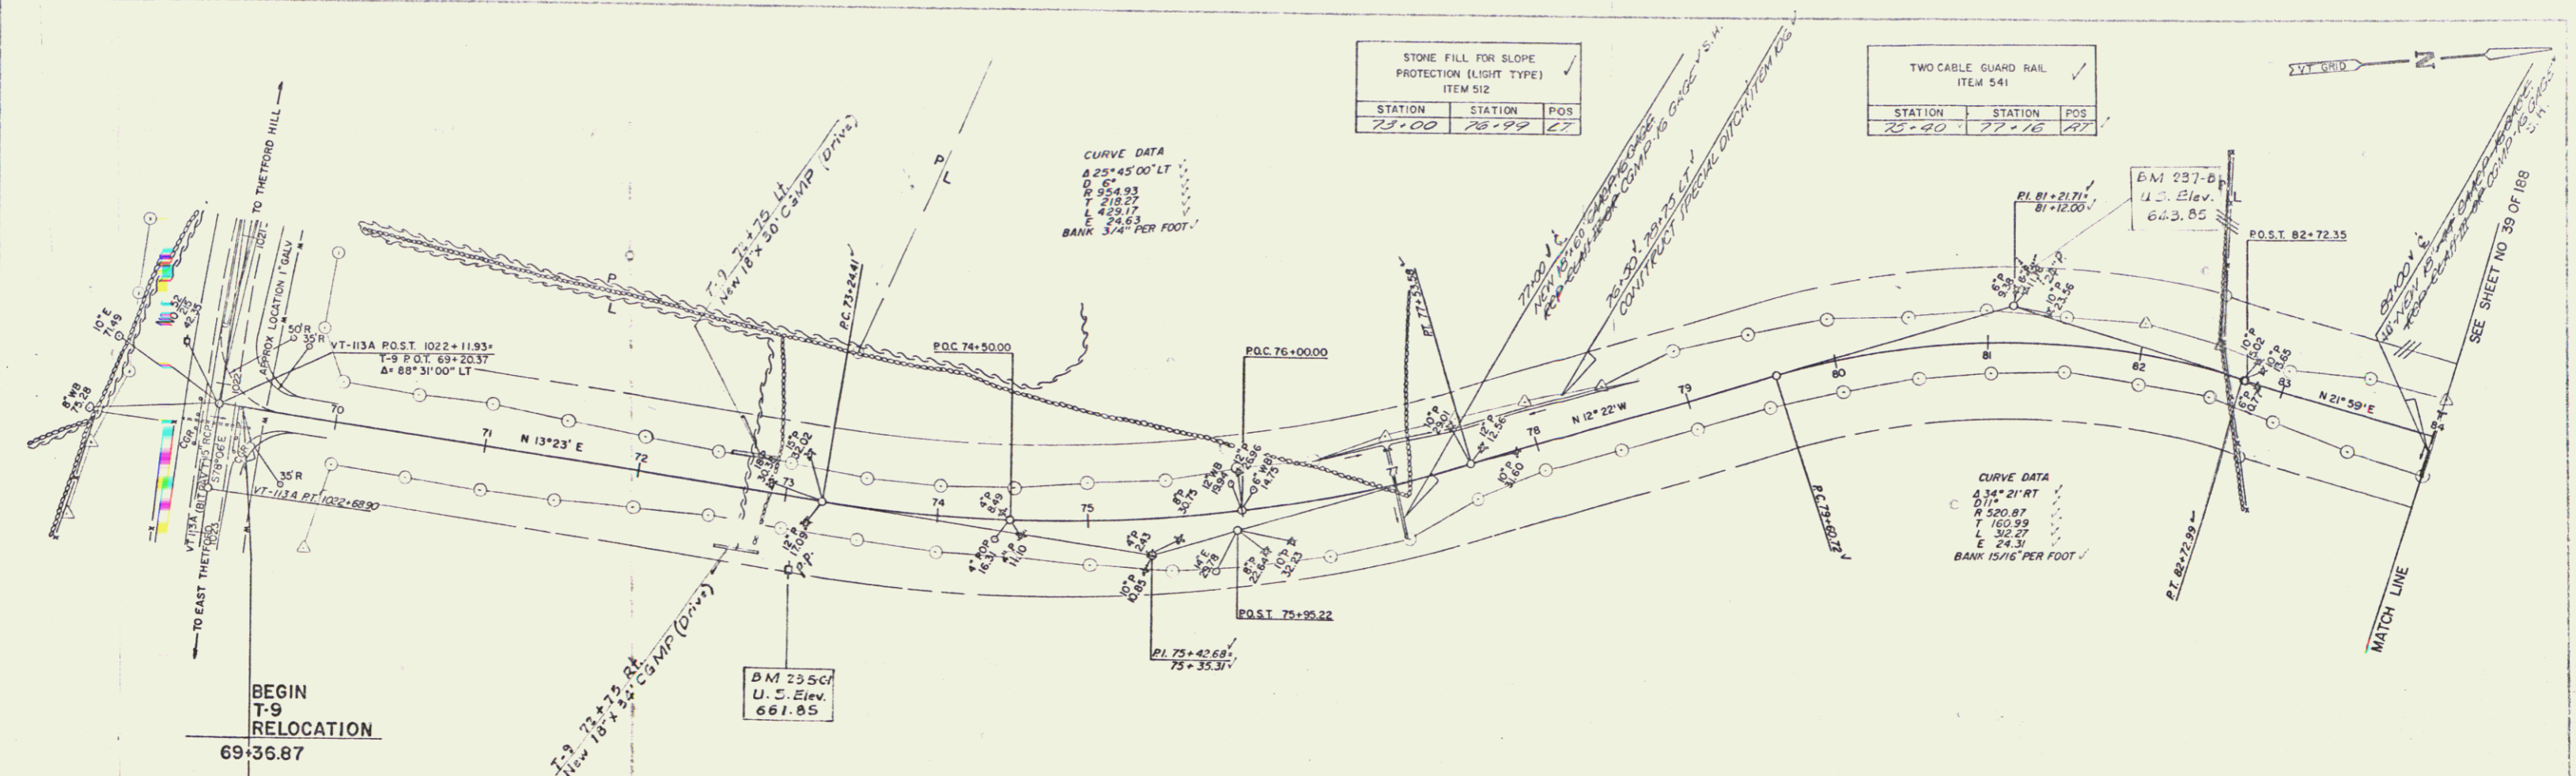

STATION	STATION	POS
73+00	78+99	LT

STATION	STATION	POS
75+40	77+16	RT

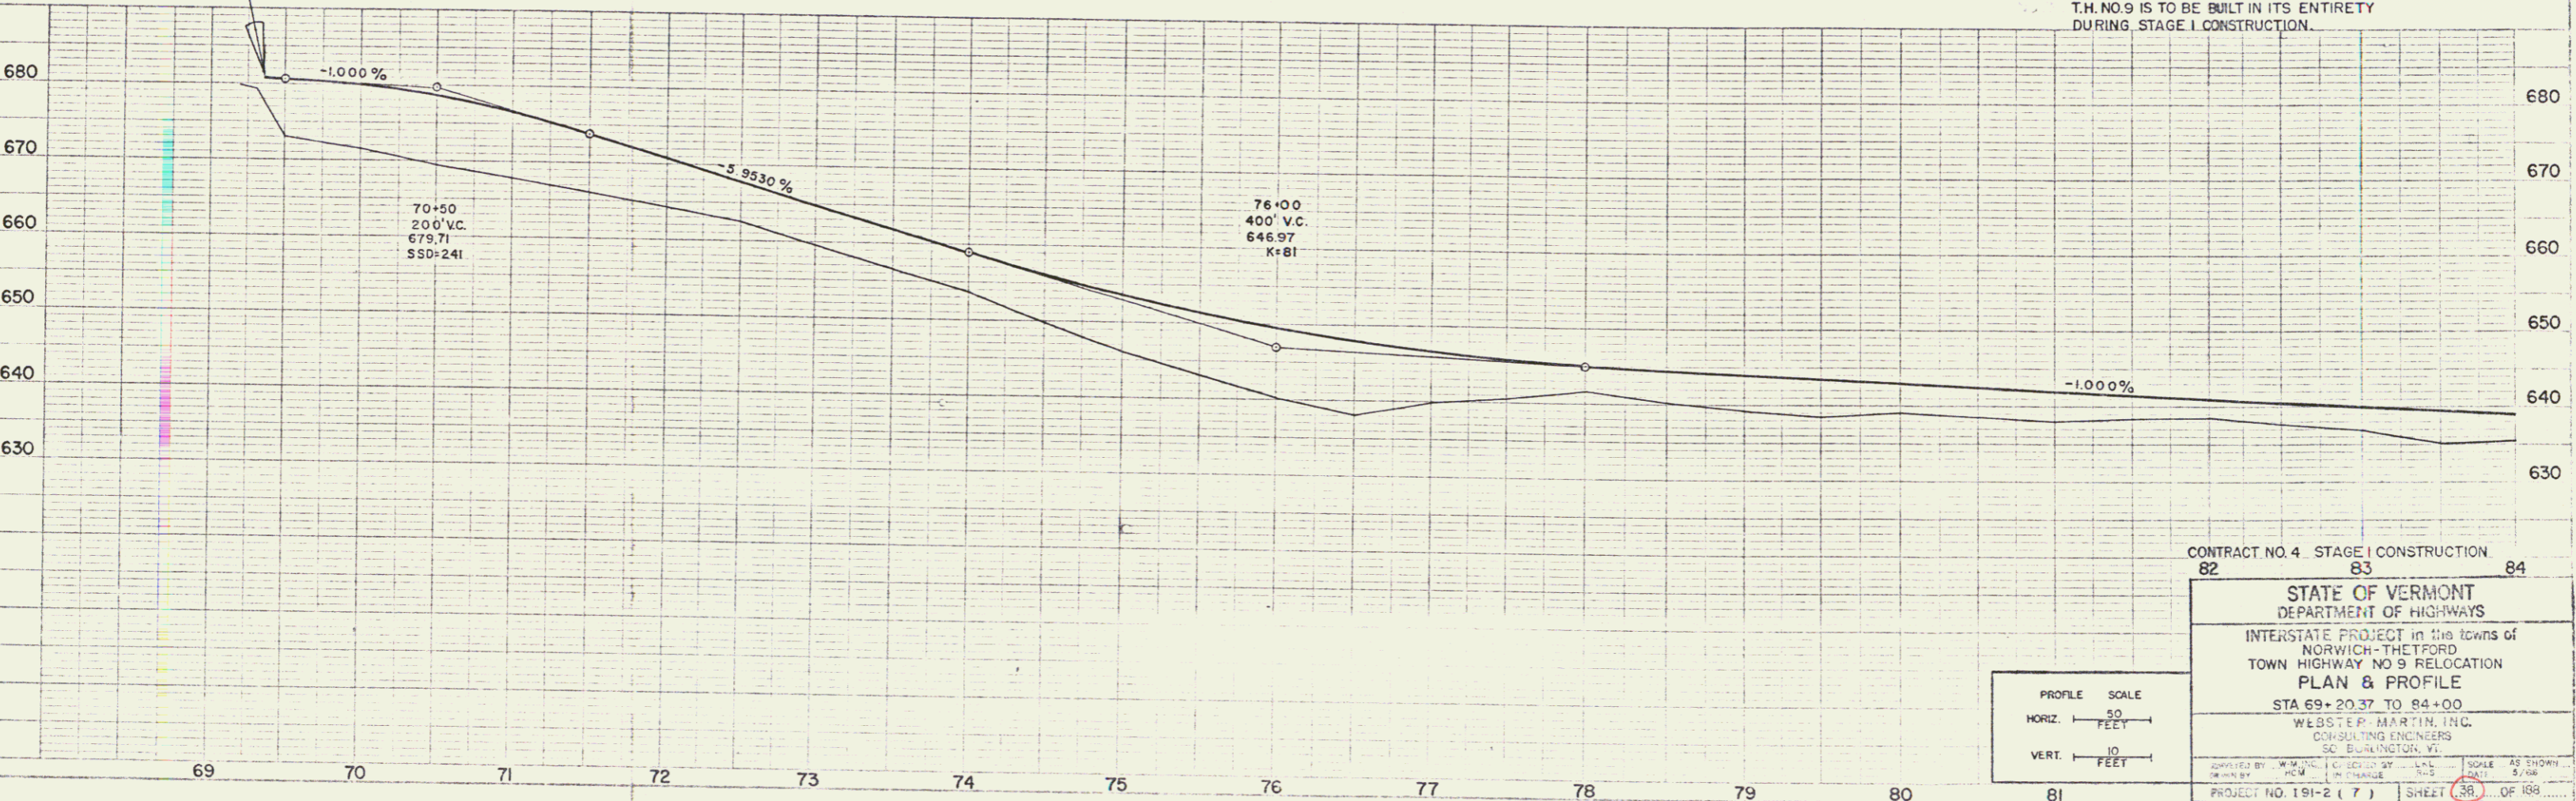

CONTRACT NO. 4 STAGE I CONSTRUCTION  
 82 83 84

STATE OF VERMONT  
 DEPARTMENT OF HIGHWAYS

INTERSTATE PROJECT in the Towns of  
 NORWICH-THEFORD  
 TOWN HIGHWAY NO 9 RELOCATION  
**PLAN & PROFILE**  
 STA 69+20.37 TO 84+00

WEBSTER MARTIN, INC.  
 CONSULTING ENGINEERS  
 50 BURLINGTON, VT.

DESIGNED BY: W.M. [Signature] DATE: 4/8/84  
 CHECKED BY: [Signature] DATE: 5/1/84  
 PROJECT NO. 191-2 (7) SHEET 38 OF 188