


PROPERTY LINE FENCE  
ITEM 583-II MOD  
NB 4595+00 - 4598+00 RT



Control of Access is Complete  
on This Sheet

THETFORD-FAIRLEE  
RIGHT OF WAY PLANS  
STA 4595+00 TO STA 4610+00  
SURVEYED BY: J.E. L. CHECKED BY: M. J. W. DATE: 7/25/00  
PROJECT: I 91-2 (14) SHEET: 31 OF 111

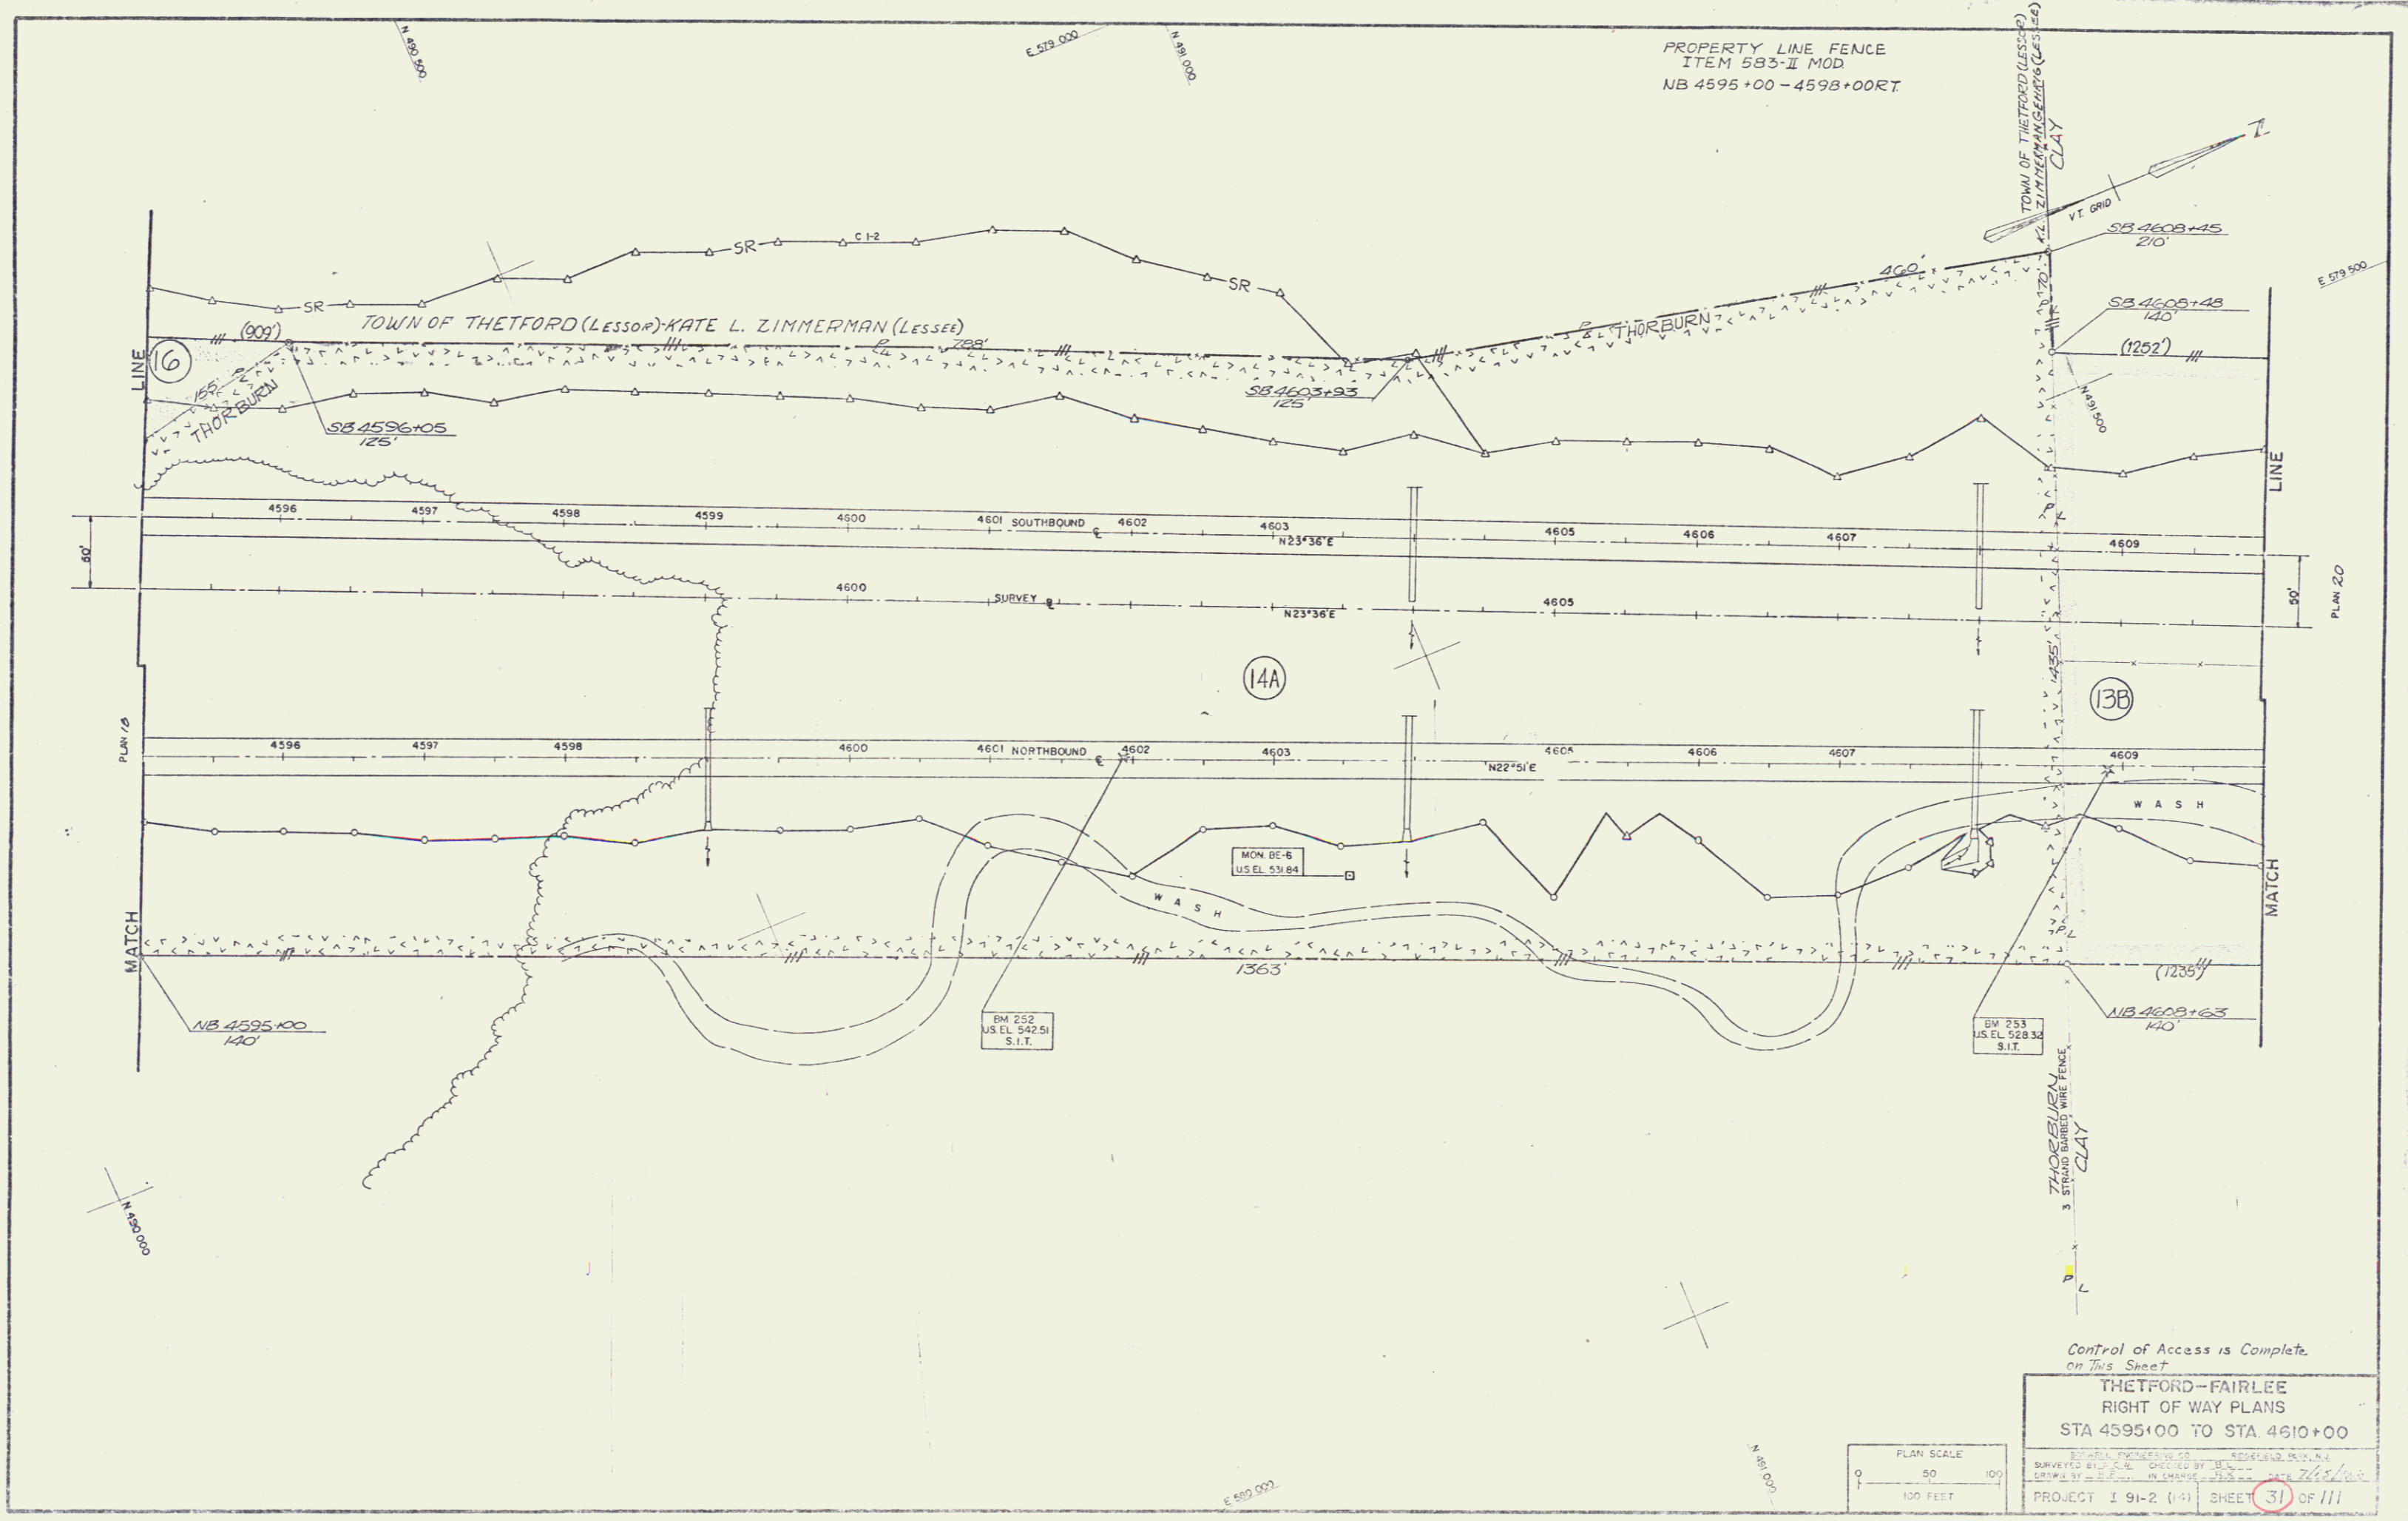