


PROPERTY LINE FENCE  
 ITEM 583-I MOD.  
 NB 4615+00 - 4625+00 RT

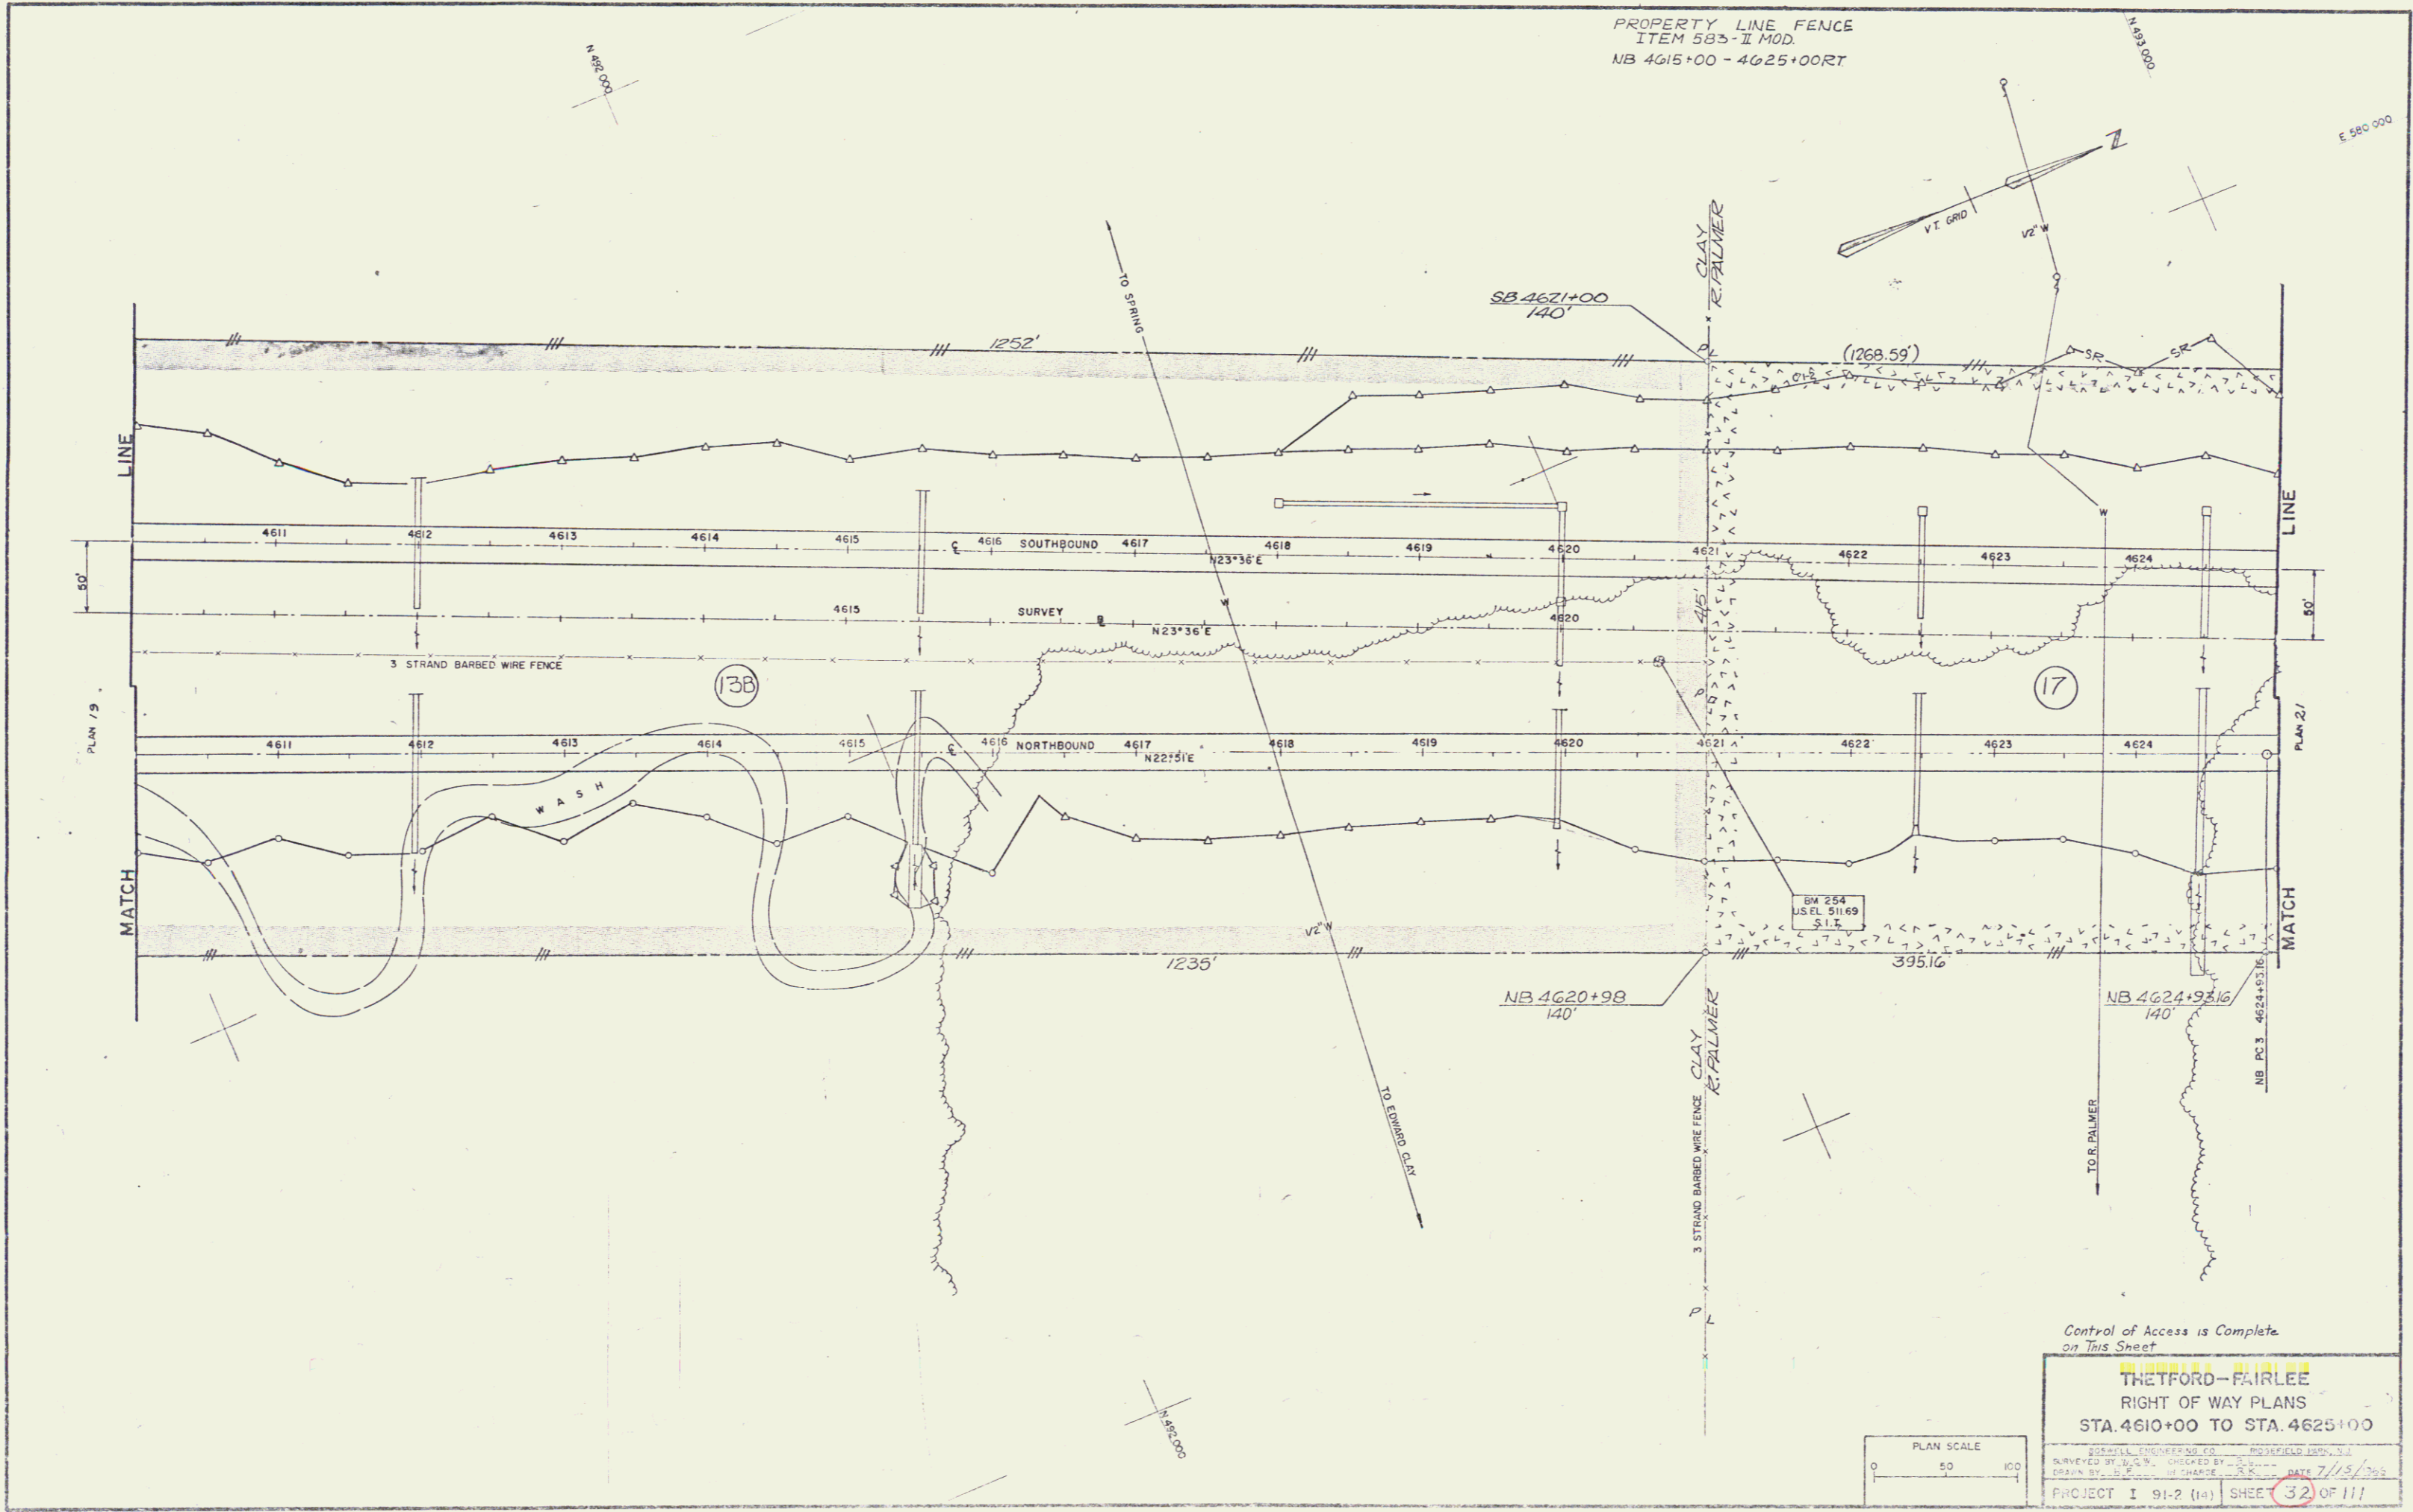

Control of Access is Complete  
 on This Sheet

THETFORD-FAIRLEE  
 RIGHT OF WAY PLANS  
 STA. 4610+00 TO STA. 4625+00

DESIGNED BY: J. G. W. CHECKED BY: J. G. W. DATE: 7/13/2009  
 DRAWN BY: J. G. W. IN CHARGE: J. G. W. DATE: 7/13/2009

PROJECT I 91-2 (14) SHEET 32 OF 111

