



PROPERTY LINE FENCE  
ITEM 583-II MOD  
NB 4671+00 - 4685+00 RT

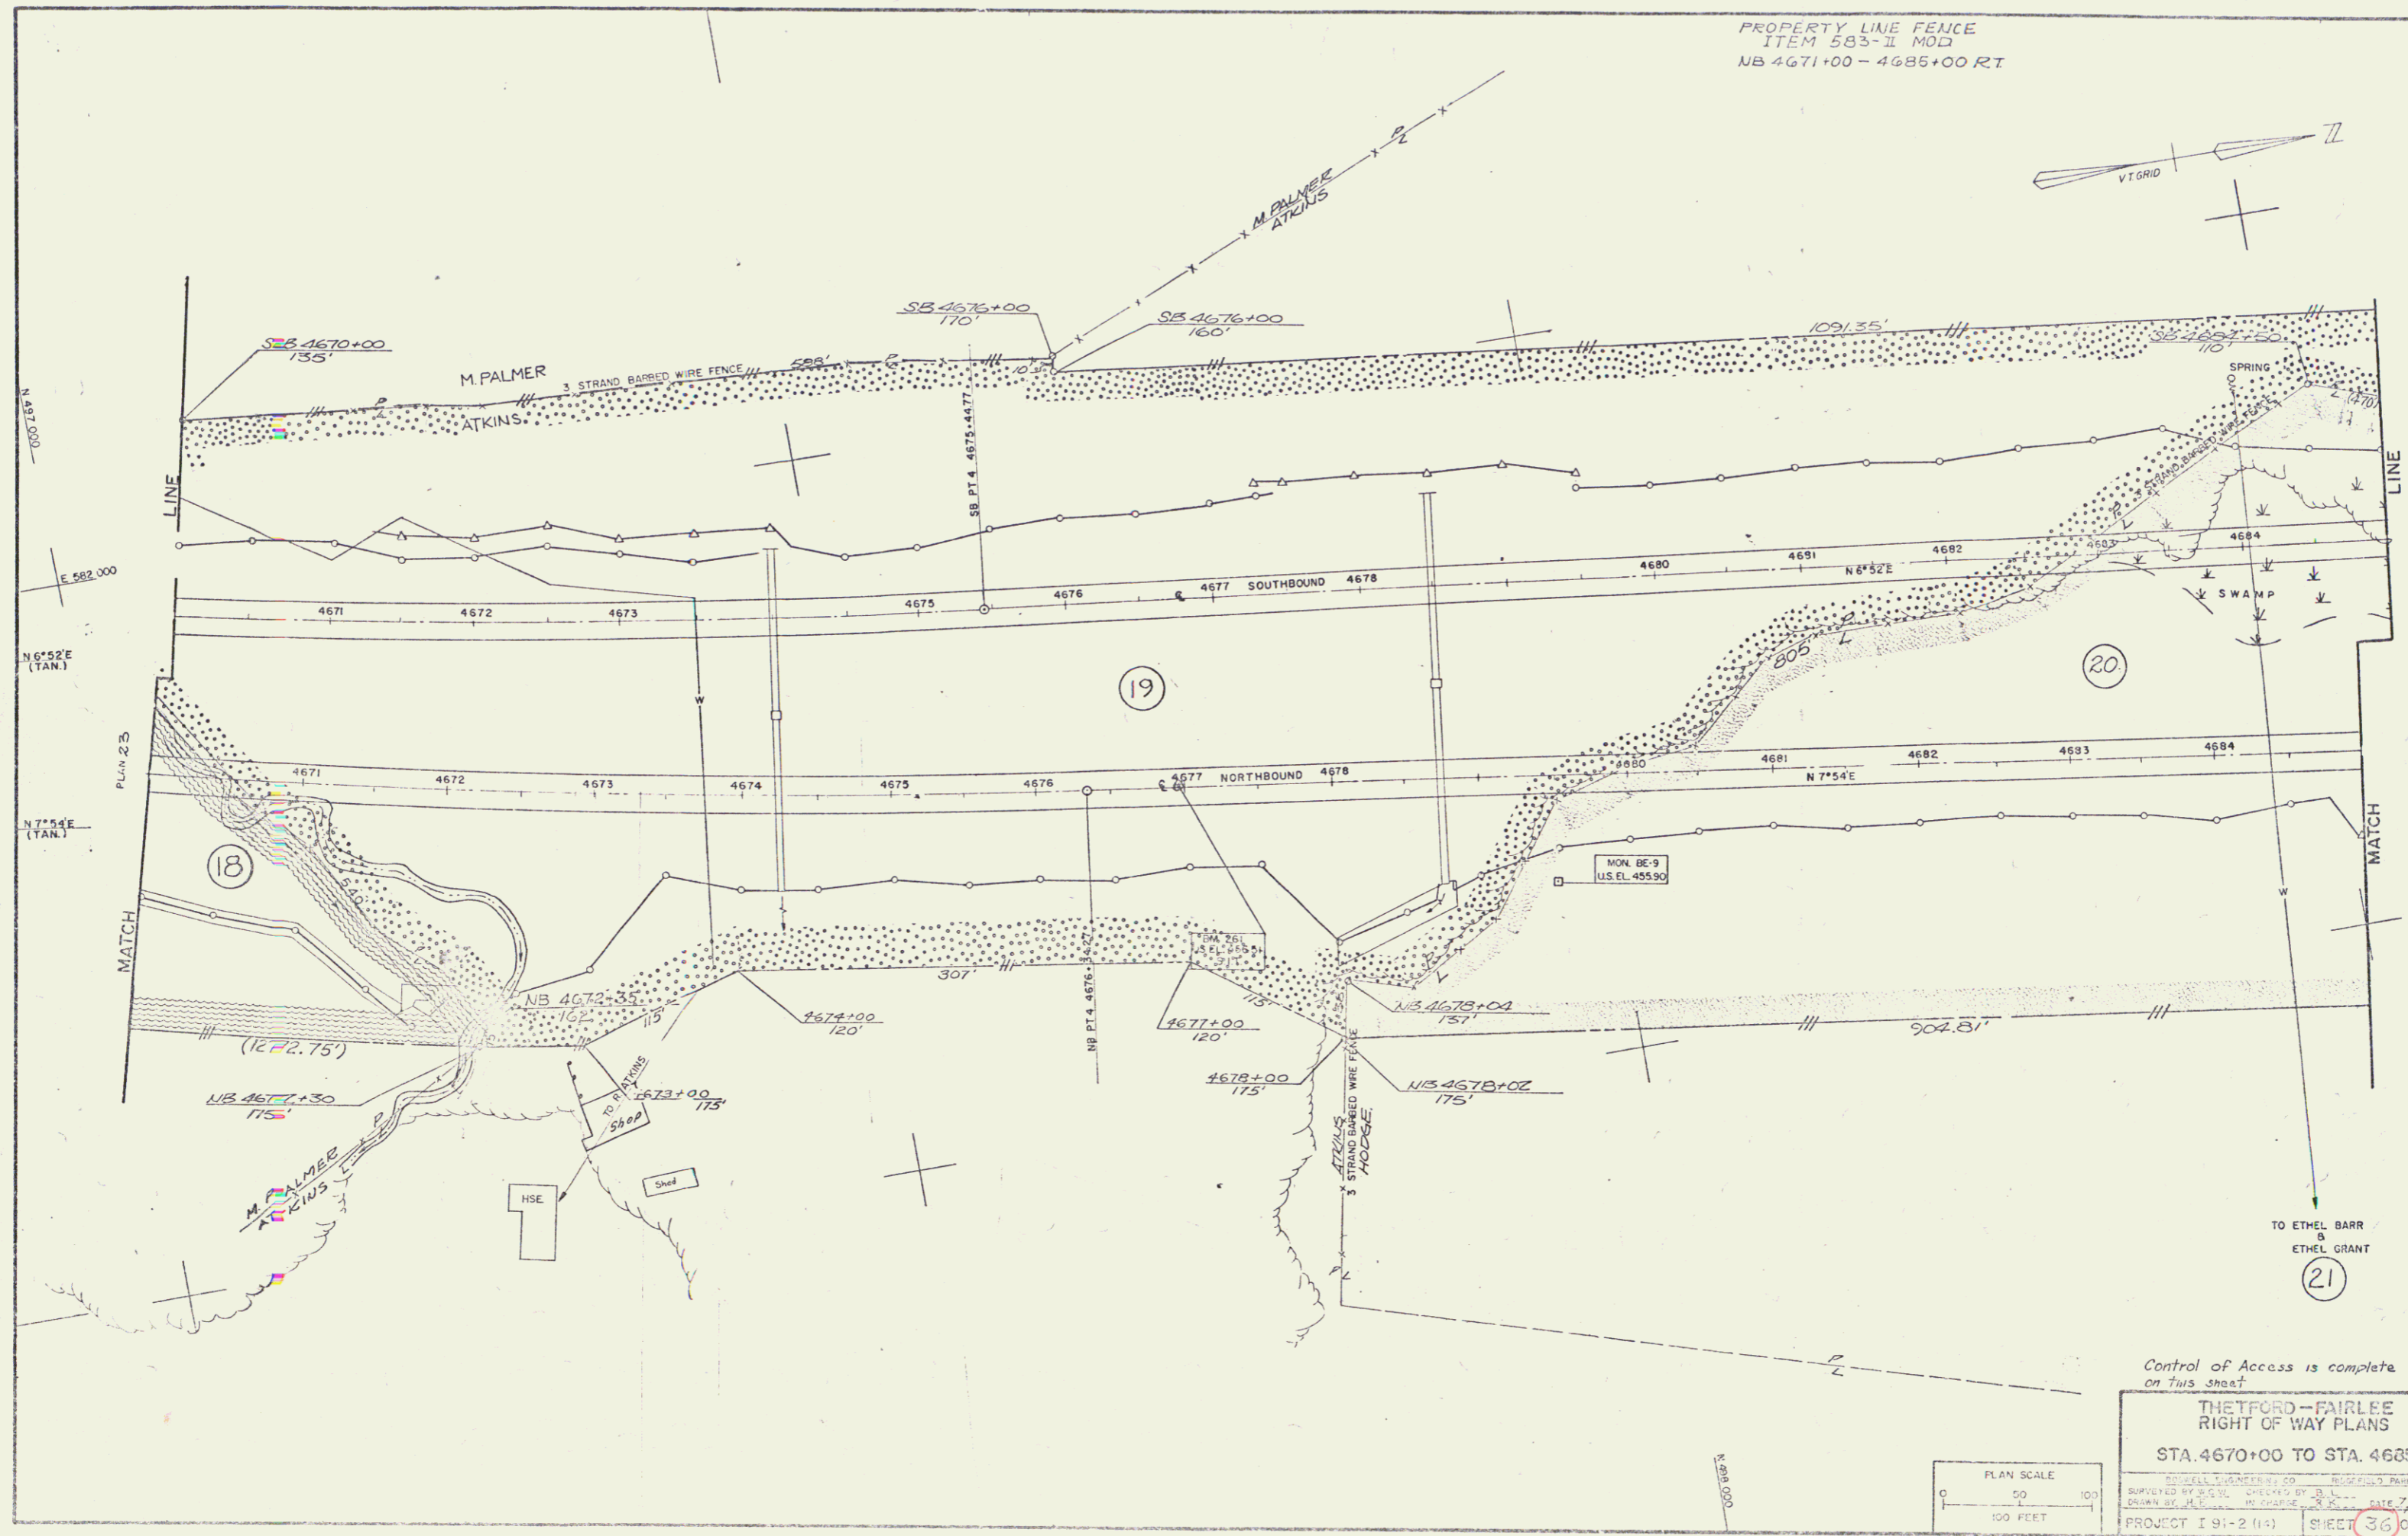

Control of Access is complete  
on this sheet

THETFORD-FAIRLEE  
RIGHT OF WAY PLANS  
STA. 4670+00 TO STA. 4685+00  
PROJECT I 91-2 (14) SHEET 36 OF 111

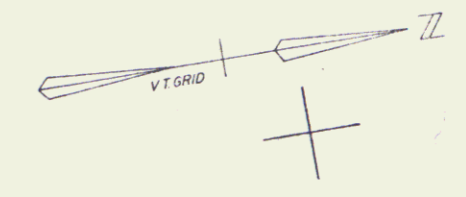