


PROPERTY LINE FENCE
ITEM 583-II MOD.
NB 4685+00-4700+00 RT

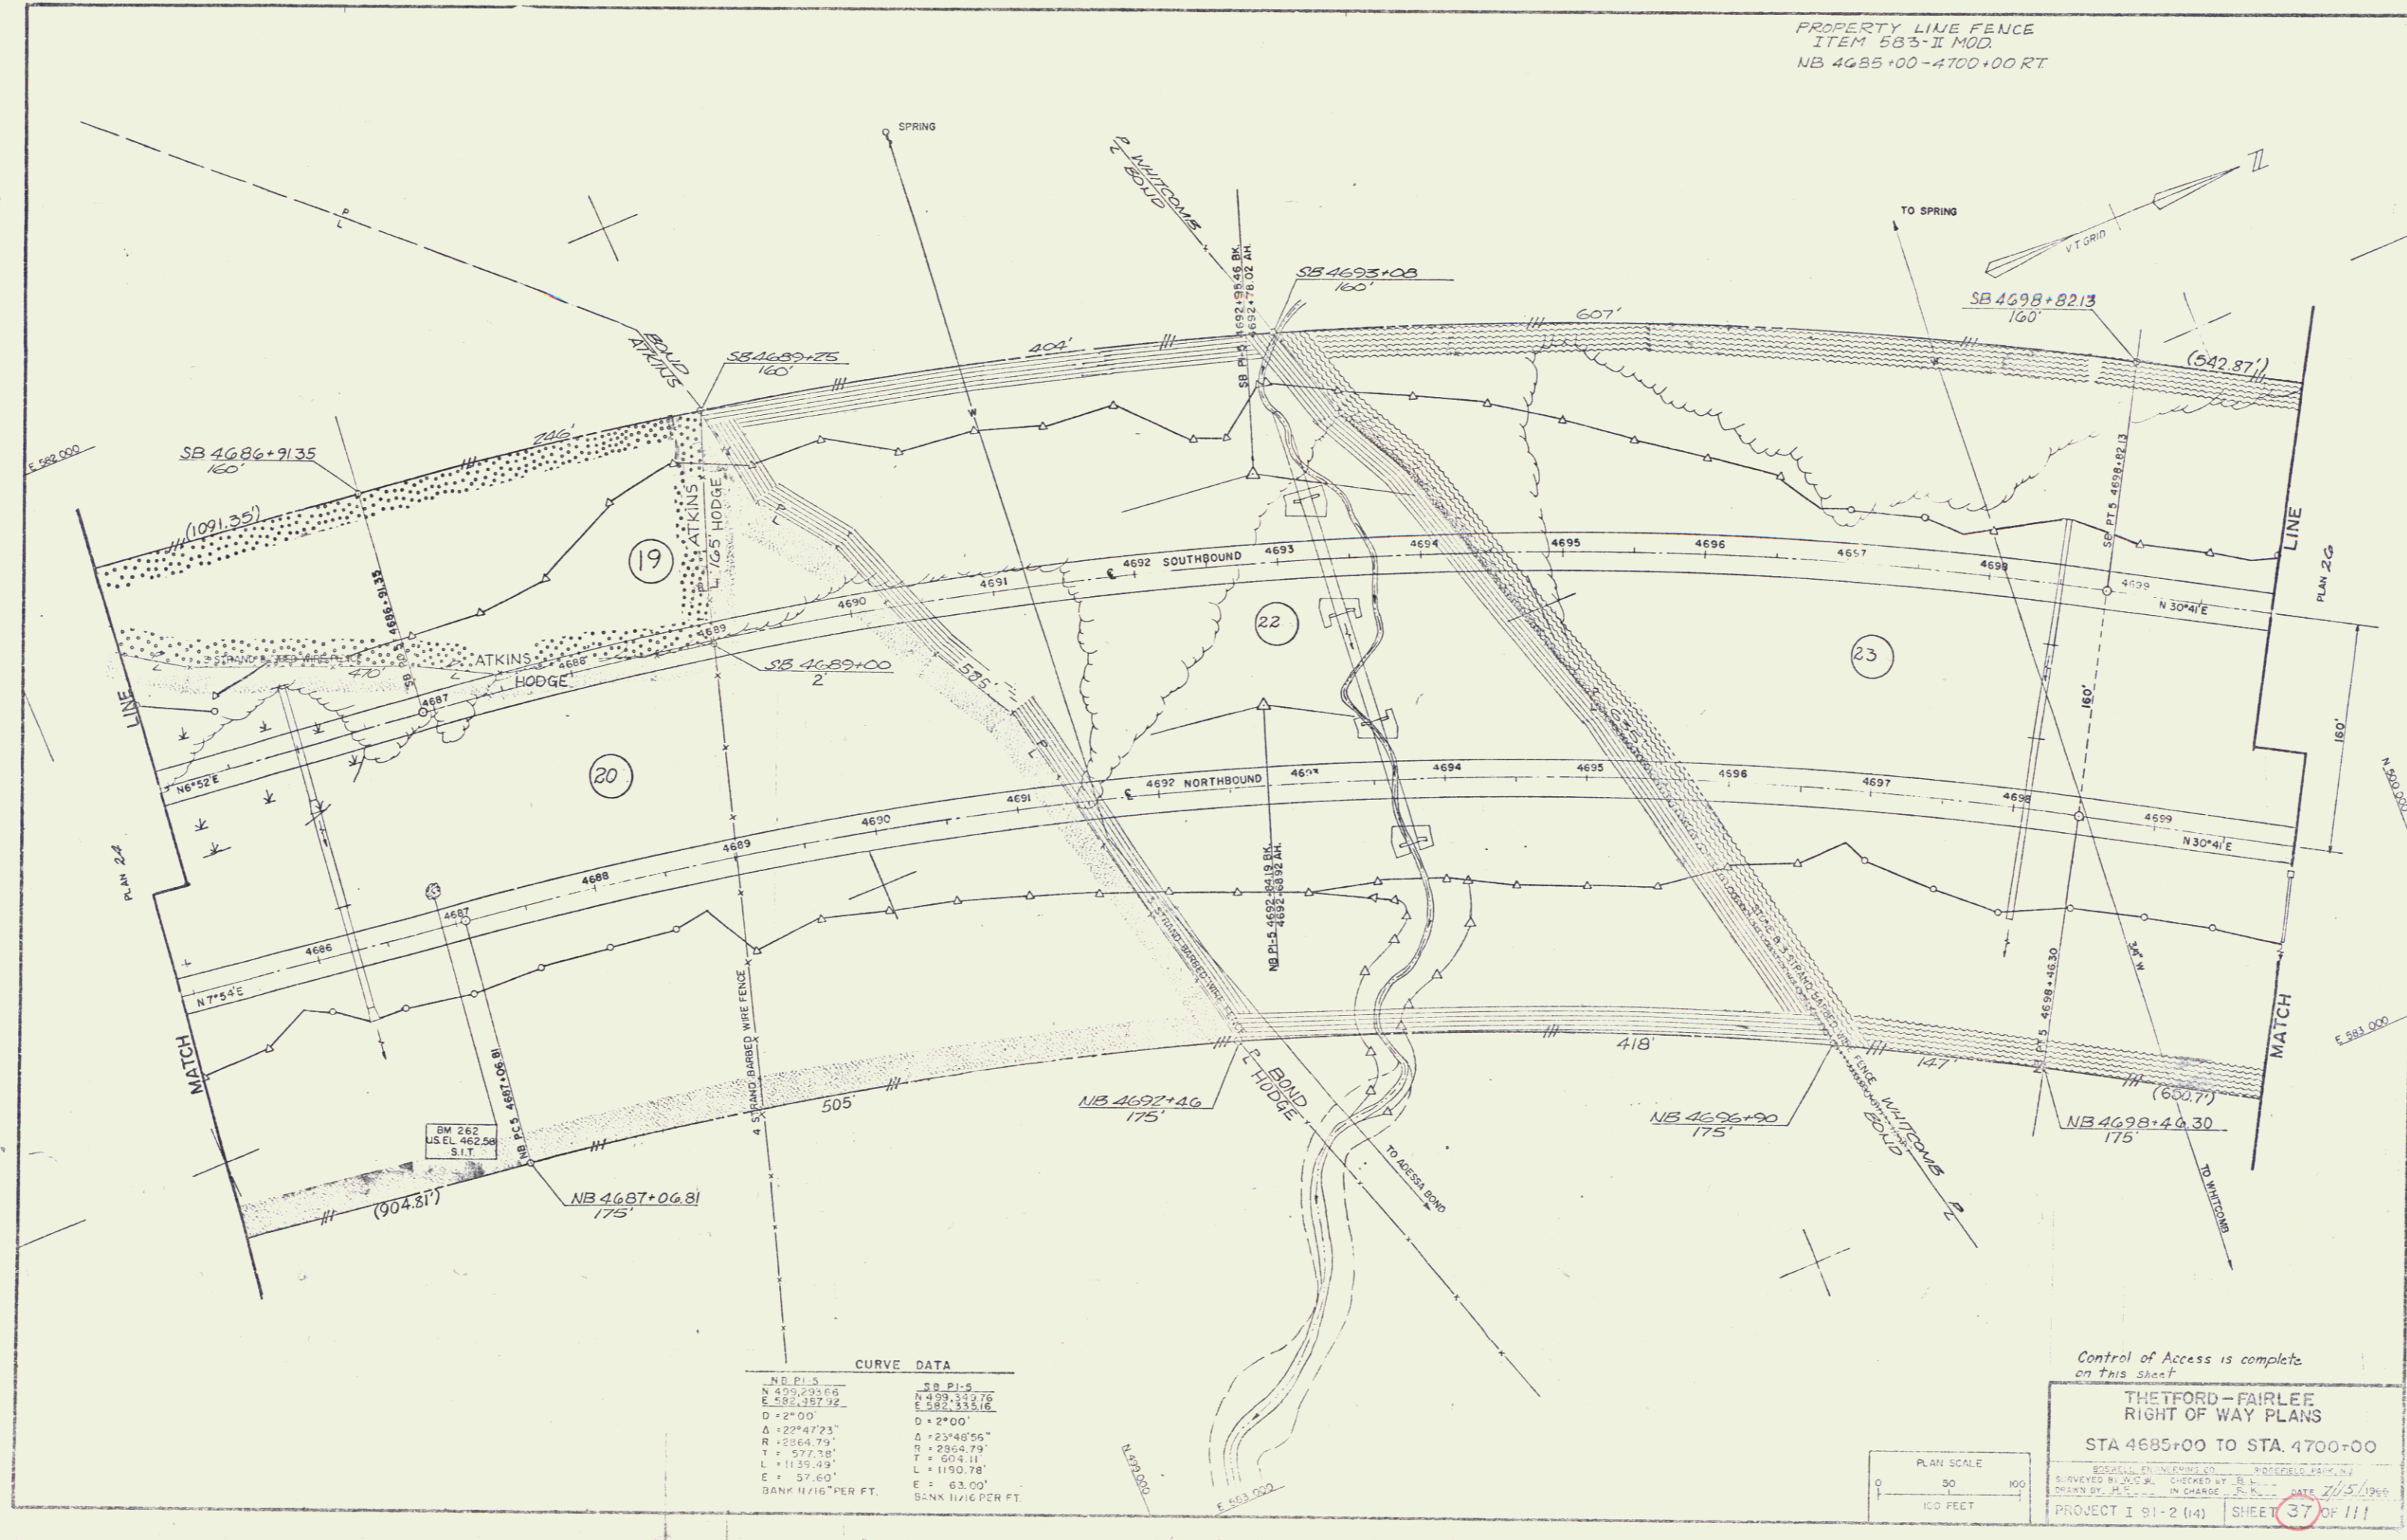

CURVE DATA

NB P1-3	SB P1-5
N 499,293.68	N 459,344.76
E 582,387.92	E 582,333.16
D = 2°00'	D = 2°00'
Δ = 122°47'23"	Δ = 23°48'56"
R = 2864.79'	R = 2864.79'
T = 577.78'	T = 604.11'
L = 1139.49'	L = 1190.78'
E = 37.60'	E = 63.00'
BANK 11/16" PER FT.	BANK 11/16" PER FT.

Control of Access is complete
on this sheet

**THETFORD - FAIRLEE
RIGHT OF WAY PLANS**

STA 4685+00 TO STA. 4700+00

BOSSILL ENGINEERING, INC. PROJECT 91-2 (14)
SURVEYED BY J.C. & J.L. CHECKED BY J.L. DATE 7/15/1994
DRAWN BY J.L. IN CHARGE J.C. DATE 7/15/1994
PROJECT I 91-2 (14) SHEET 37 OF 111

