


PROPERTY LINE FENCE  
ITEM 683-I MOD  
NB 4700+00 - 4715+00 RT

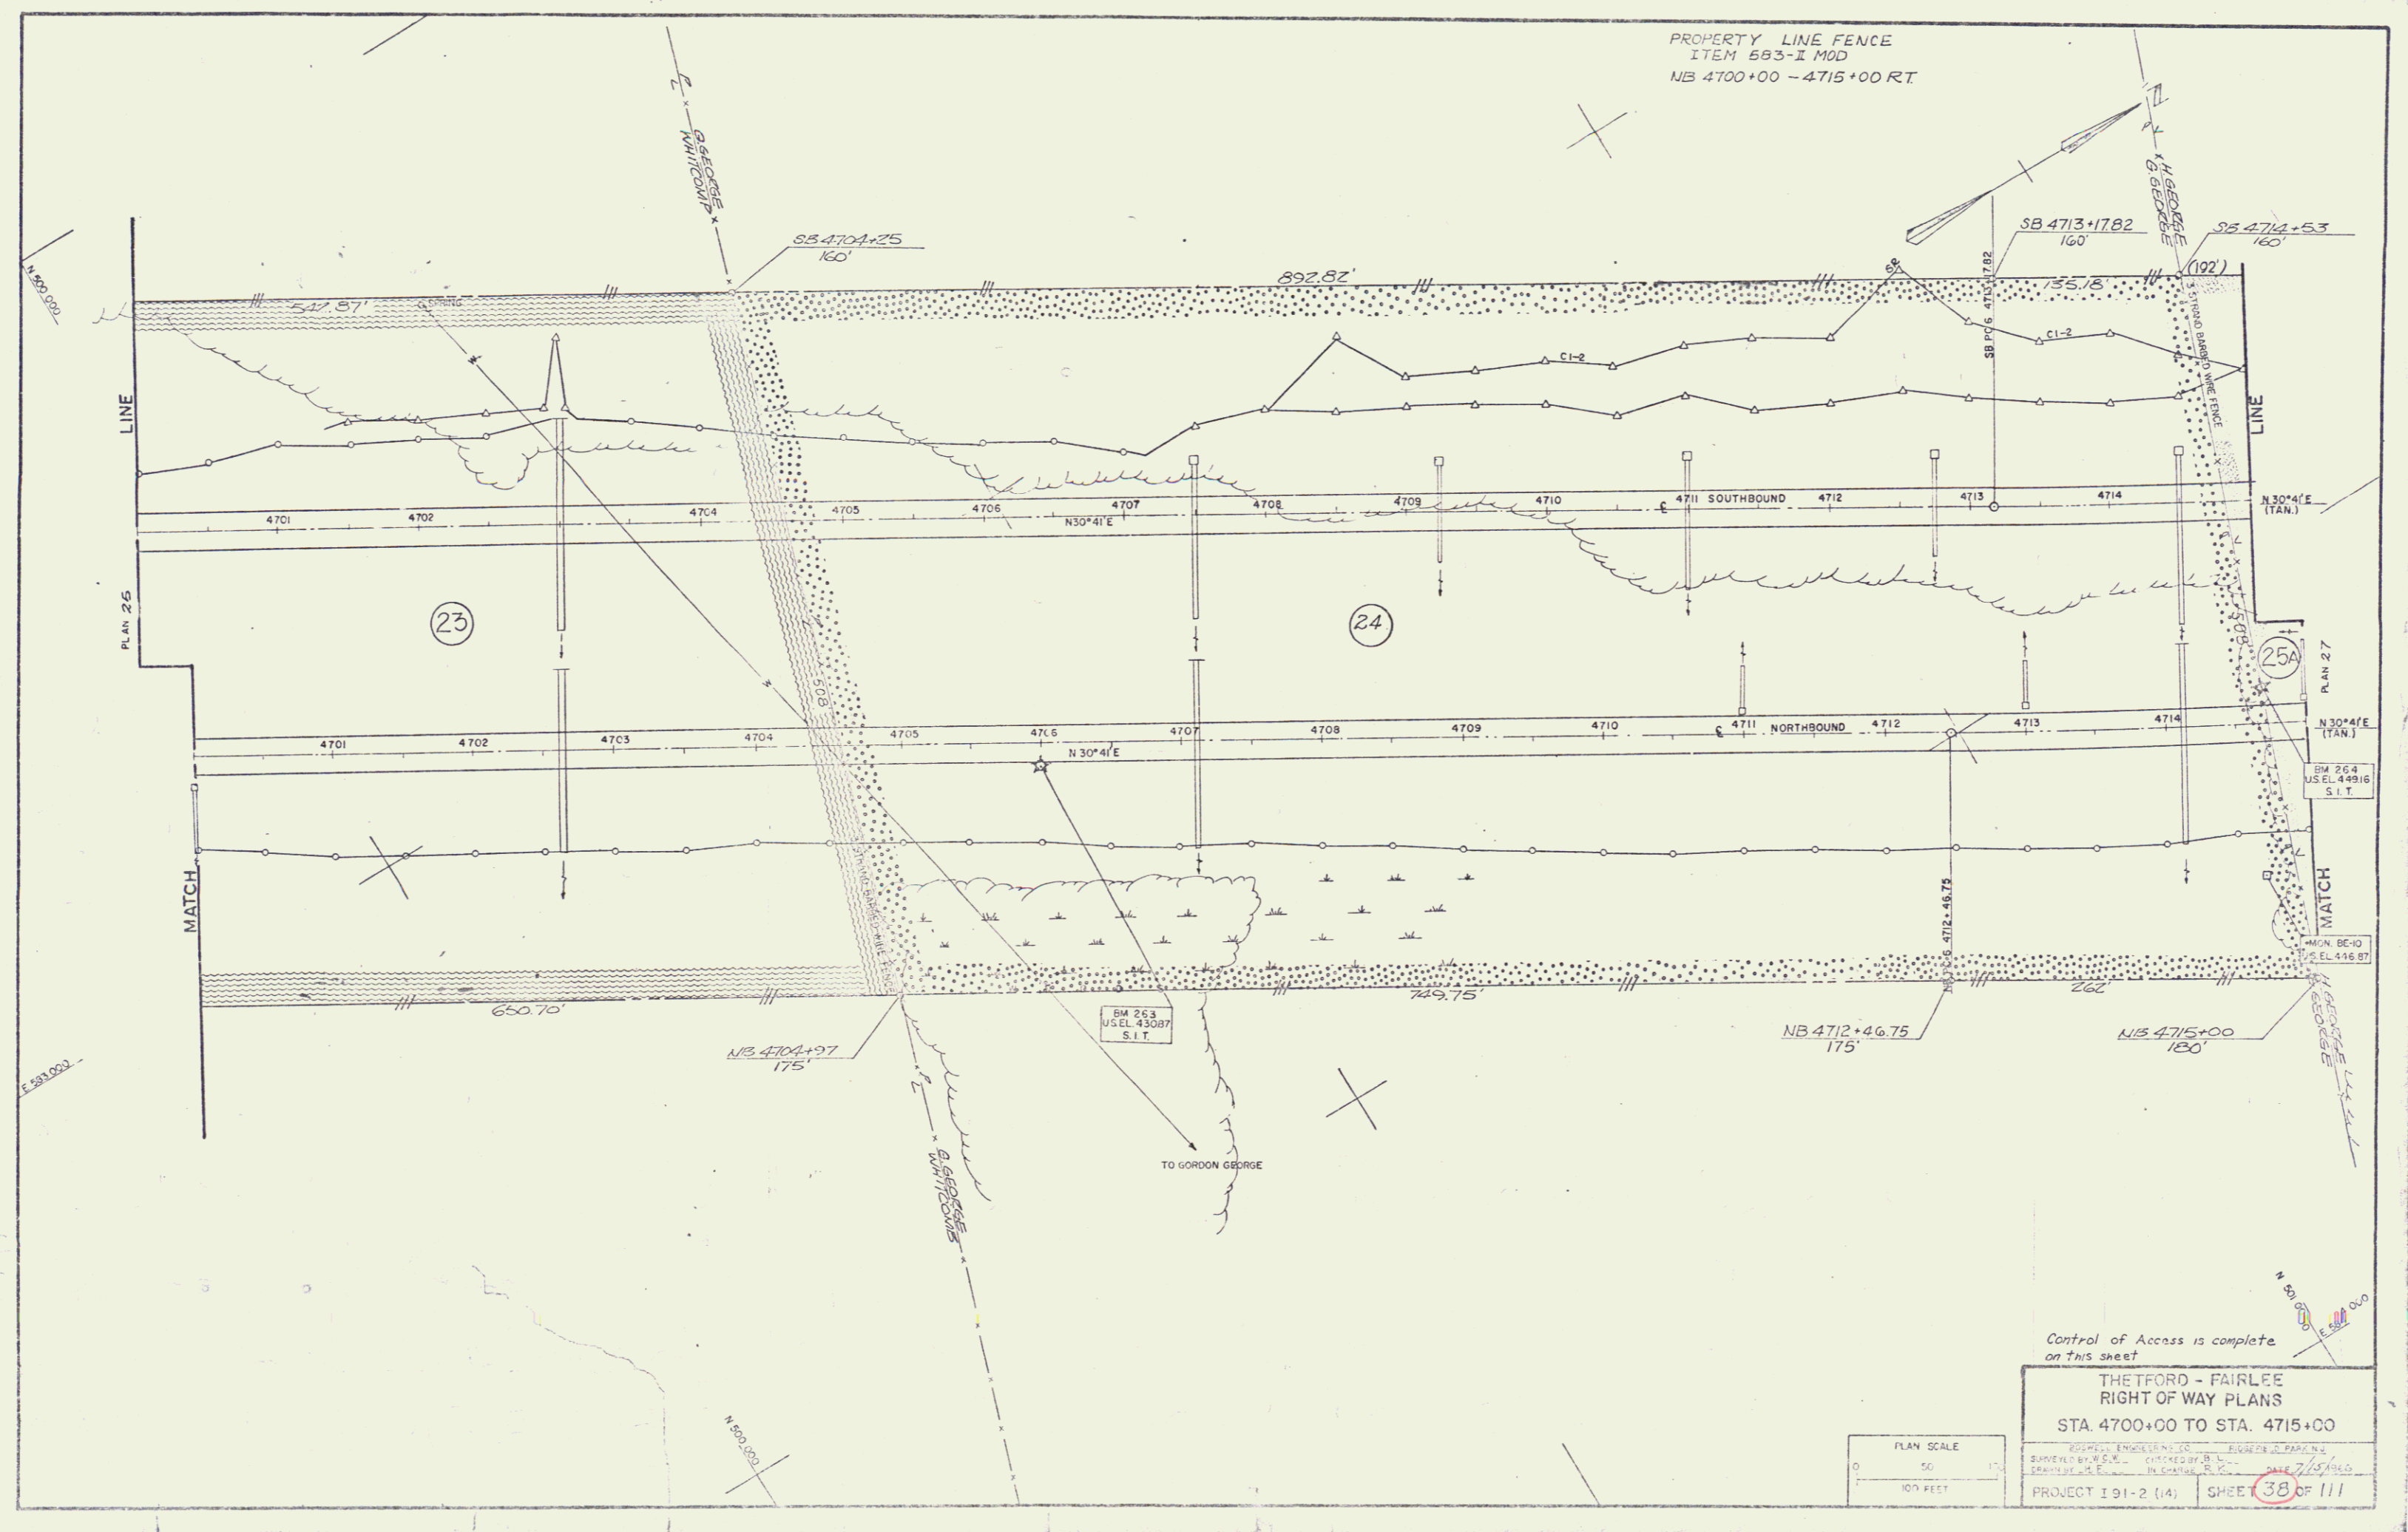

Control of Access is complete  
on this sheet

THE FORD - FAIRLEE  
RIGHT OF WAY PLANS  
STA. 4700+00 TO STA. 4715+00

PROJECT I 91-2 (14) SHEET 38 OF 111

PLAN SCALE  
0 50 100  
100 FEET