


PROPERTY LINE FENCE  
ITEM 583-II MOD  
NB 4715+00 - 4730+00 RT

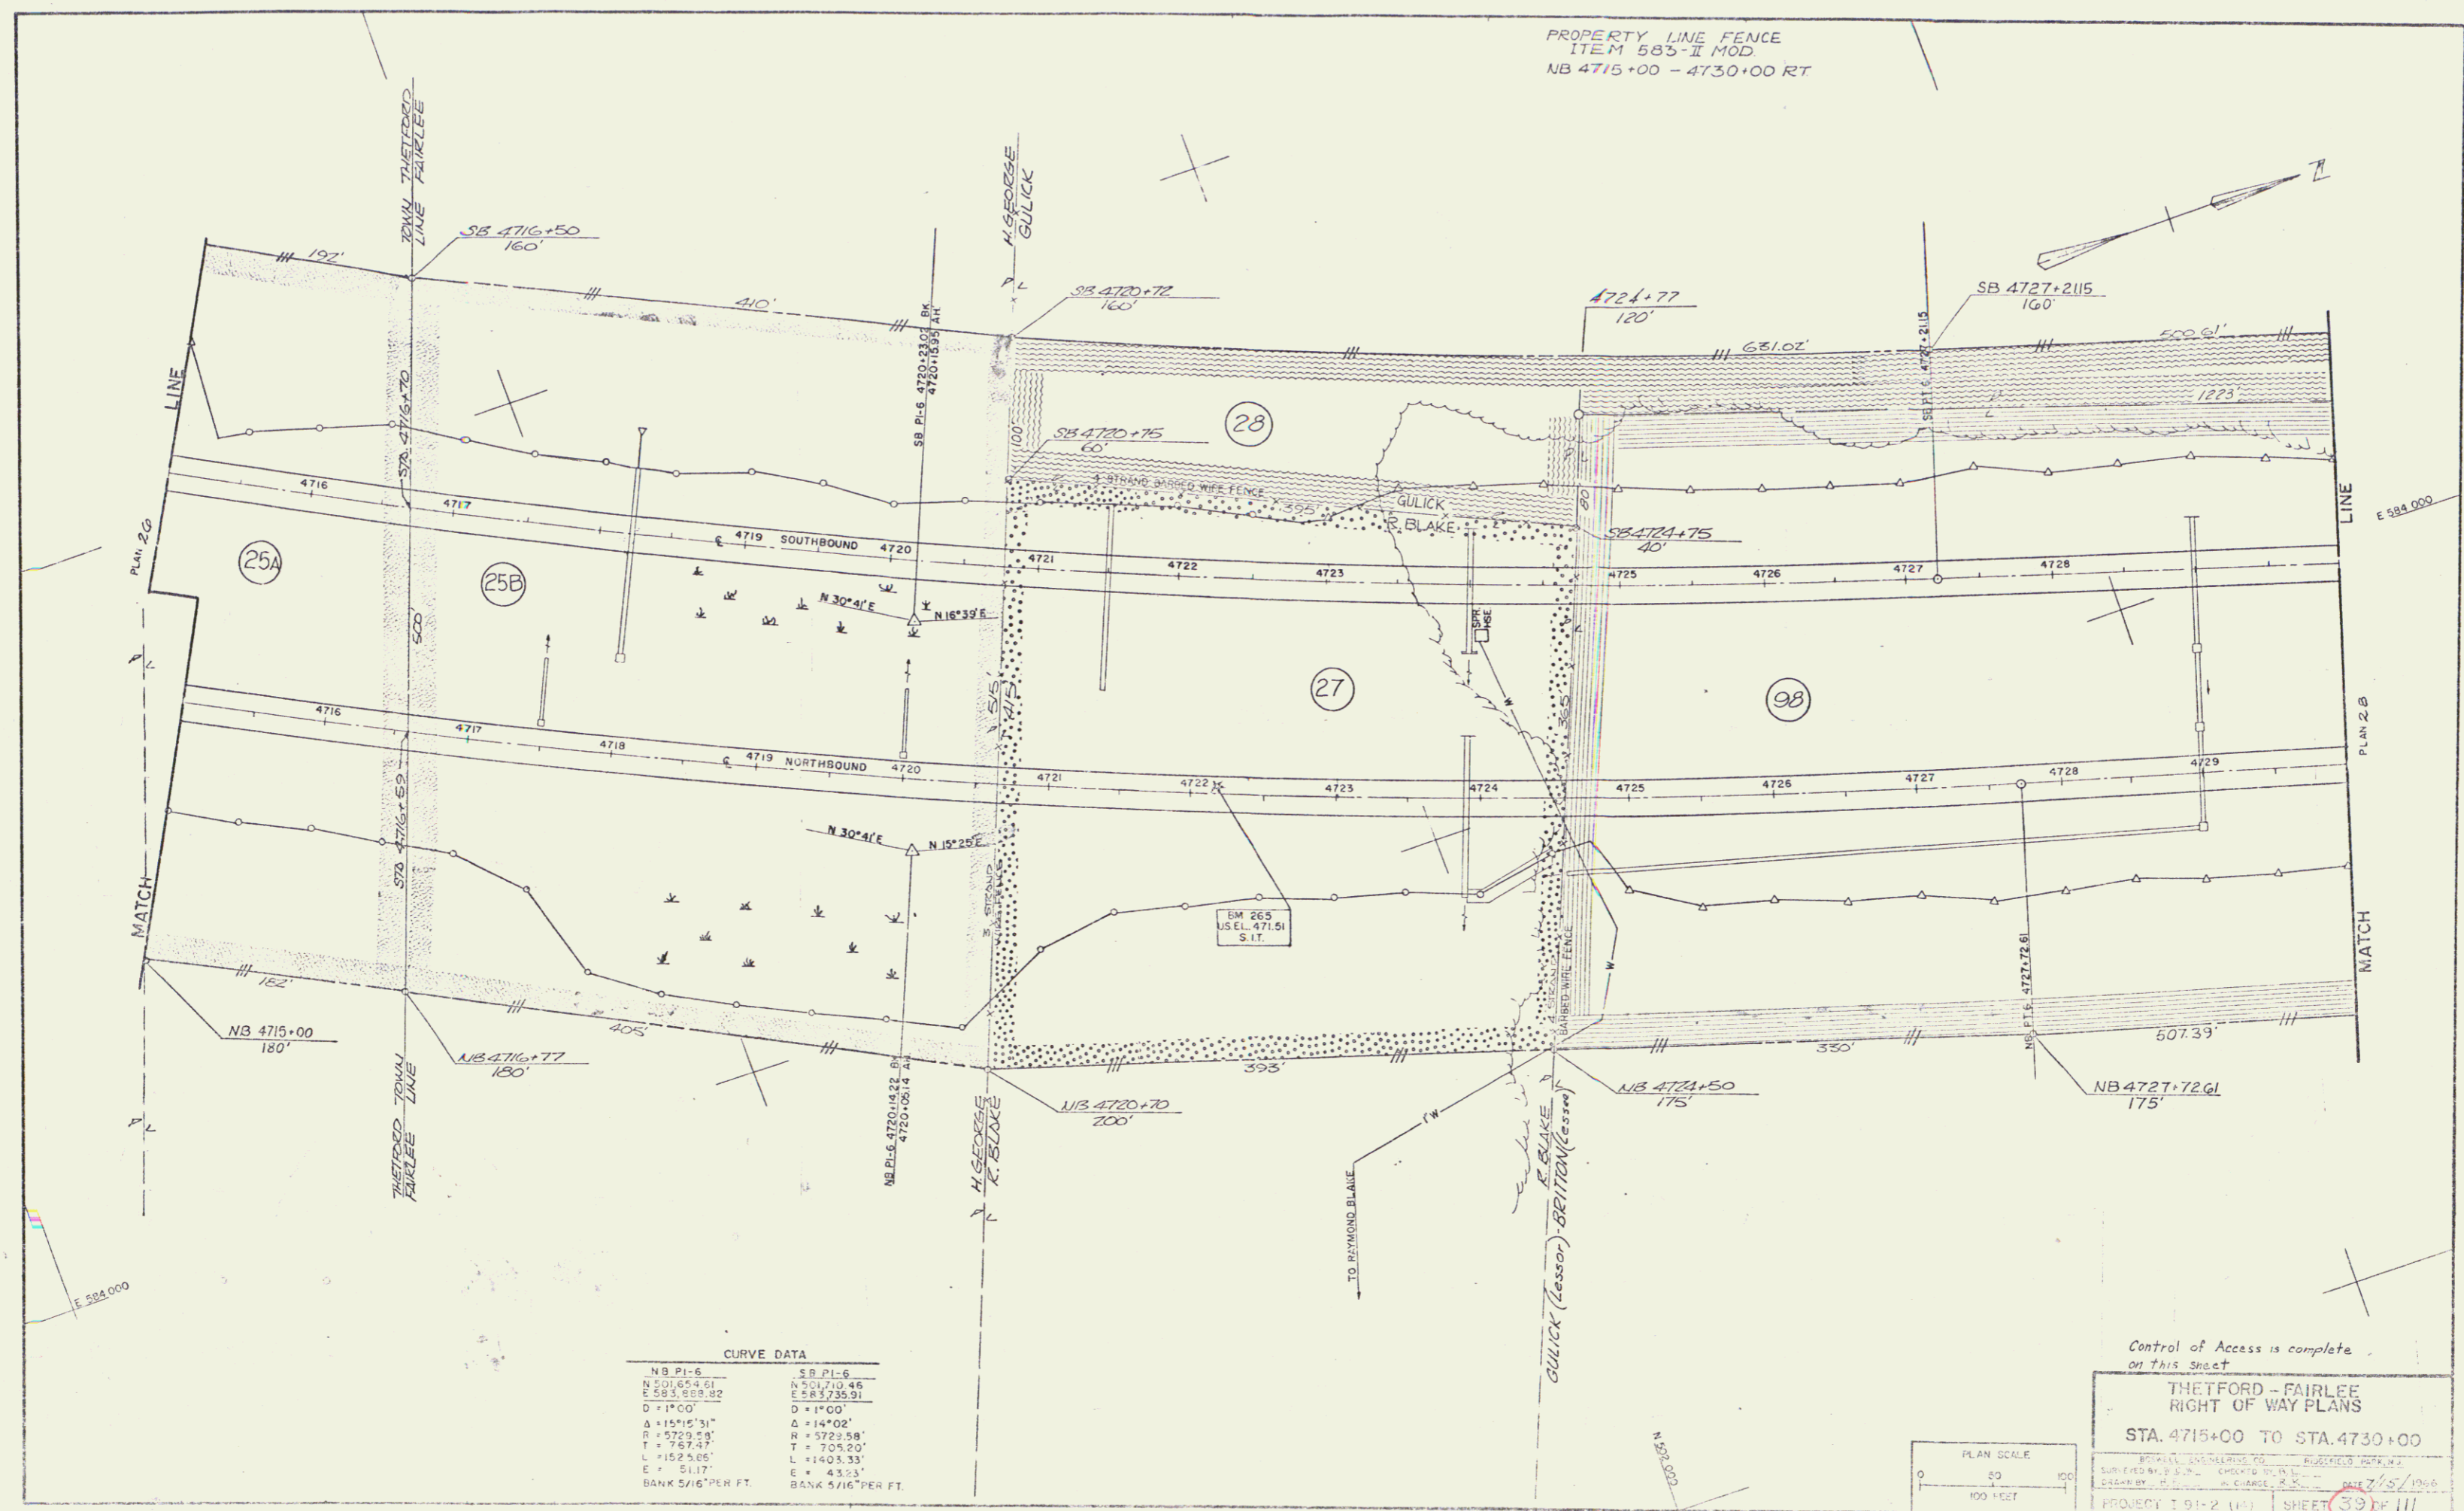

MATCH LINE PLAN 20

MATCH LINE PLAN 21

CURVE DATA

NB PI-6	SB PI-6
N 501.65+61	N 501.70+46
E 583.508+82	E 583.735+91
D = 1°00'	D = 1°00'
Δ = 15°15'31"	Δ = 14°02'
R = 5729.53'	R = 5729.58'
T = 767.94'	T = 705.20'
L = 152.505'	L = 140.333'
E = 5117'	E = 4333'
BANK 5/16" PER FT.	BANK 5/16" PER FT.

Control of Access is complete on this sheet

**THETFORD - FAIRLEE  
RIGHT OF WAY PLANS**

STA. 4715+00 TO STA. 4730+00

PROJECT 1.91-2 (10) SHEET 39 OF 111

