



PROPERTY LINE FENCE  
ITEM 5B3-II MOD.  
SB 4736+80-4738+95 LT  
NB 4730+00-4735+70 RT  
NB 4739+25-4742+00 RT  
SB 4739+60-4742+00 LT

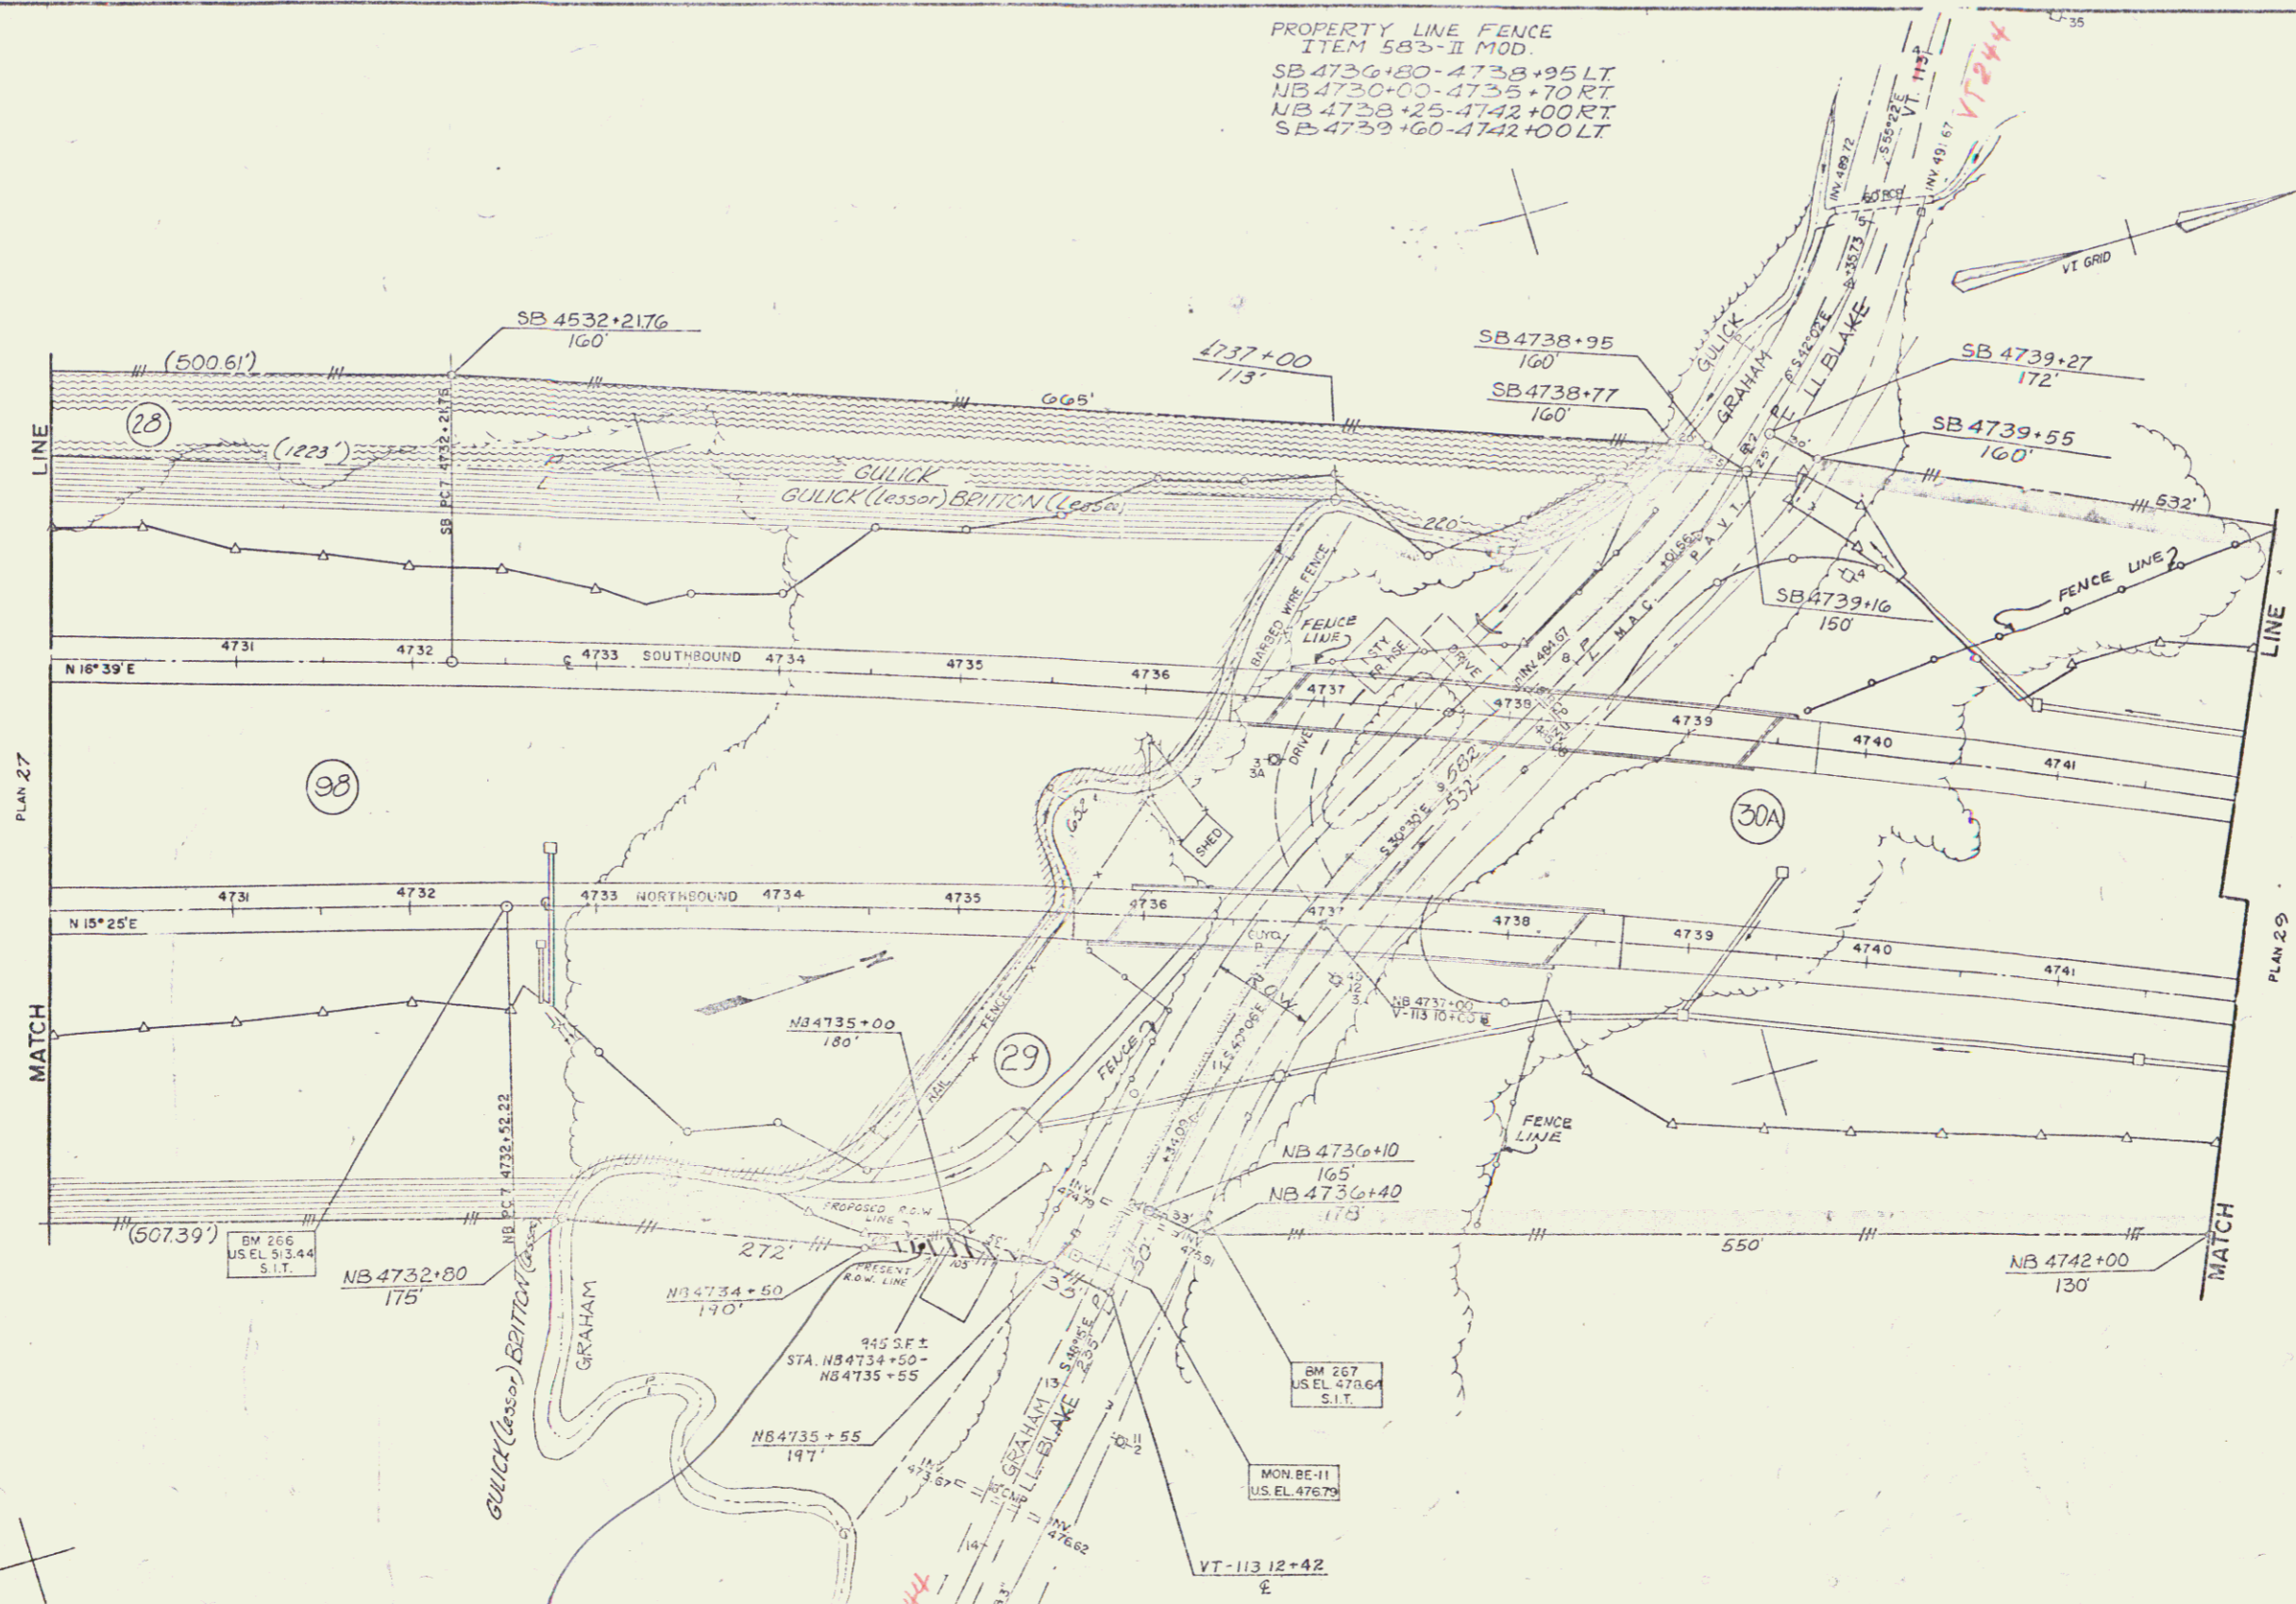

State of VT to Phyllis  
William Graham, Jr.  
dtd 4/14/70 BK? P3?

Control of Access is complete on this sheet

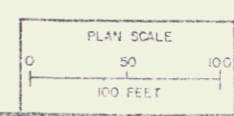

THETFORD - FAIRLEE  
RIGHT OF WAY PLANS  
STA. 4730+00 TO STA. 4742+00  
PROJECT I 91-2 (10) SHEET 40 OF 111