


PROPERTY LINE FENCE  
 ITEM 583-11 MOD  
 SB 4822+00 - 4830+00 LT  
 NB 4815+00 - 4830+00 RT

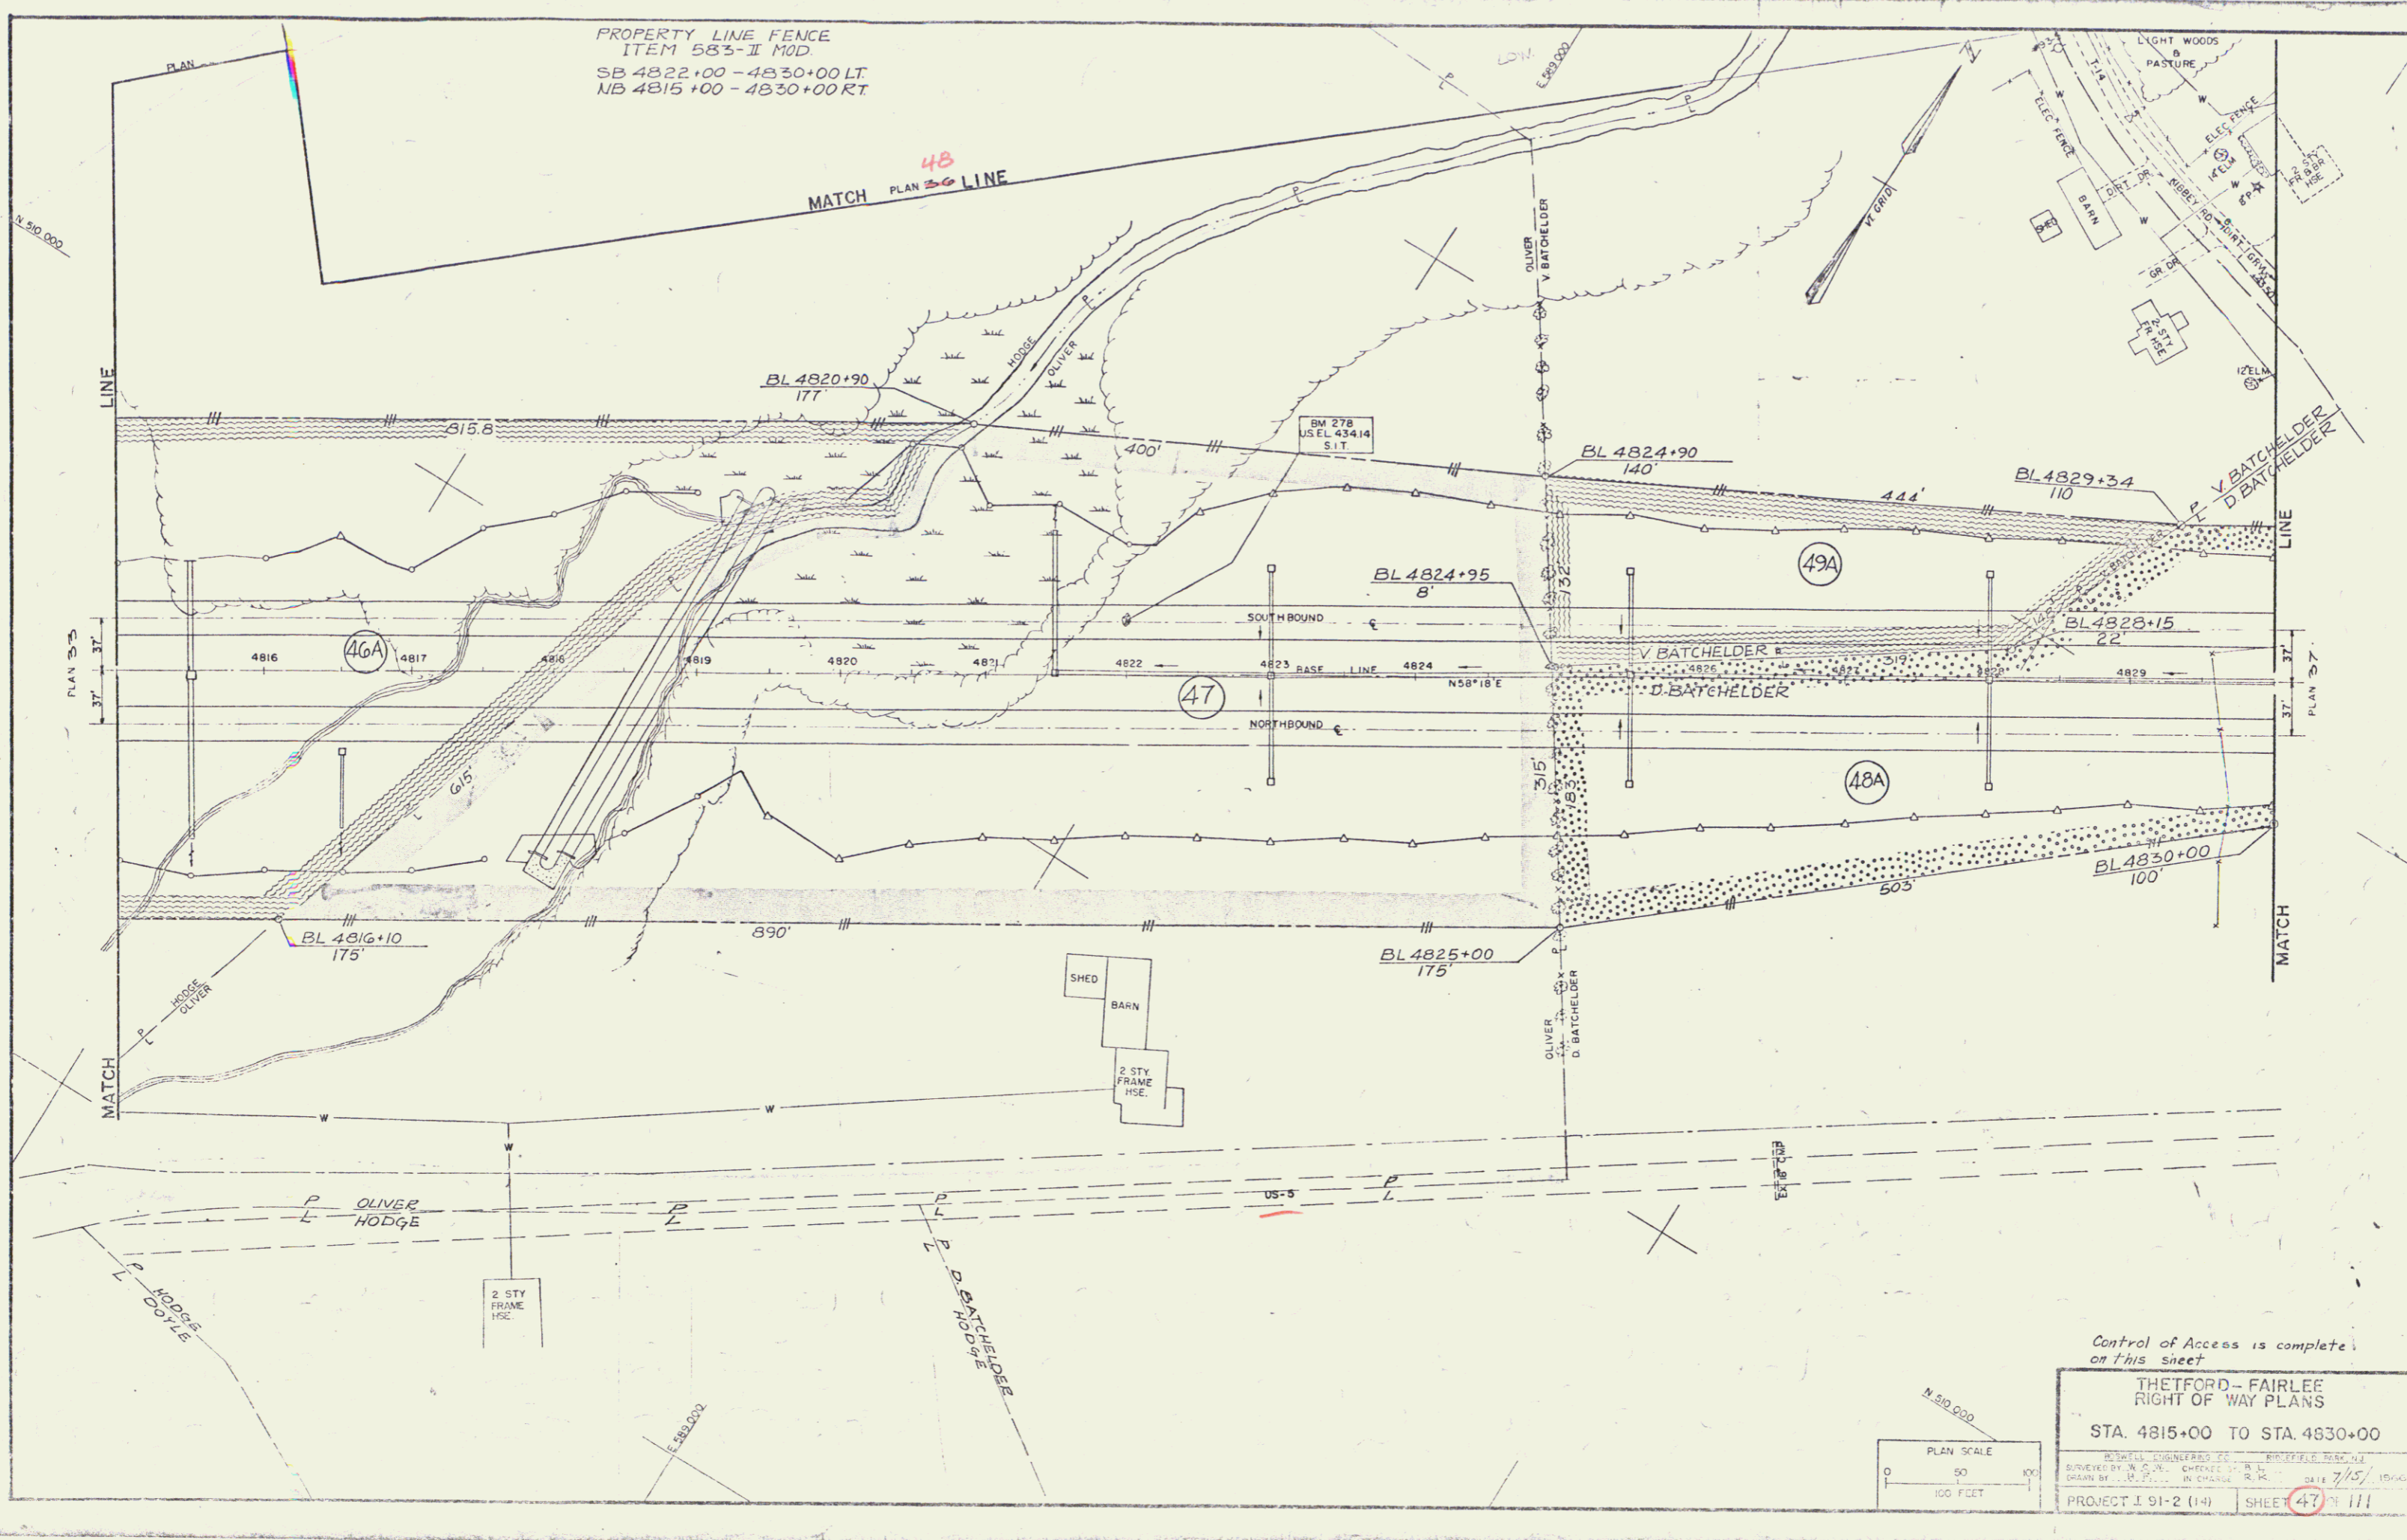

Control of Access is complete  
 on this sheet

THETFORD - FAIRLEE  
 RIGHT OF WAY PLANS  
 STA. 4815+00 TO STA. 4830+00

DESIGNED BY: J. W. ... DRAWN BY: ... DATE: 7/15/1960  
 PROJECT I 91-2 (14) SHEET 47 OF 111

