


PROPERTY LINE FENCE
 ITEM 583-I MOD
 SB 4830+00 - 4845+00 LT
 NB 4830+00 - 4845+00 RT

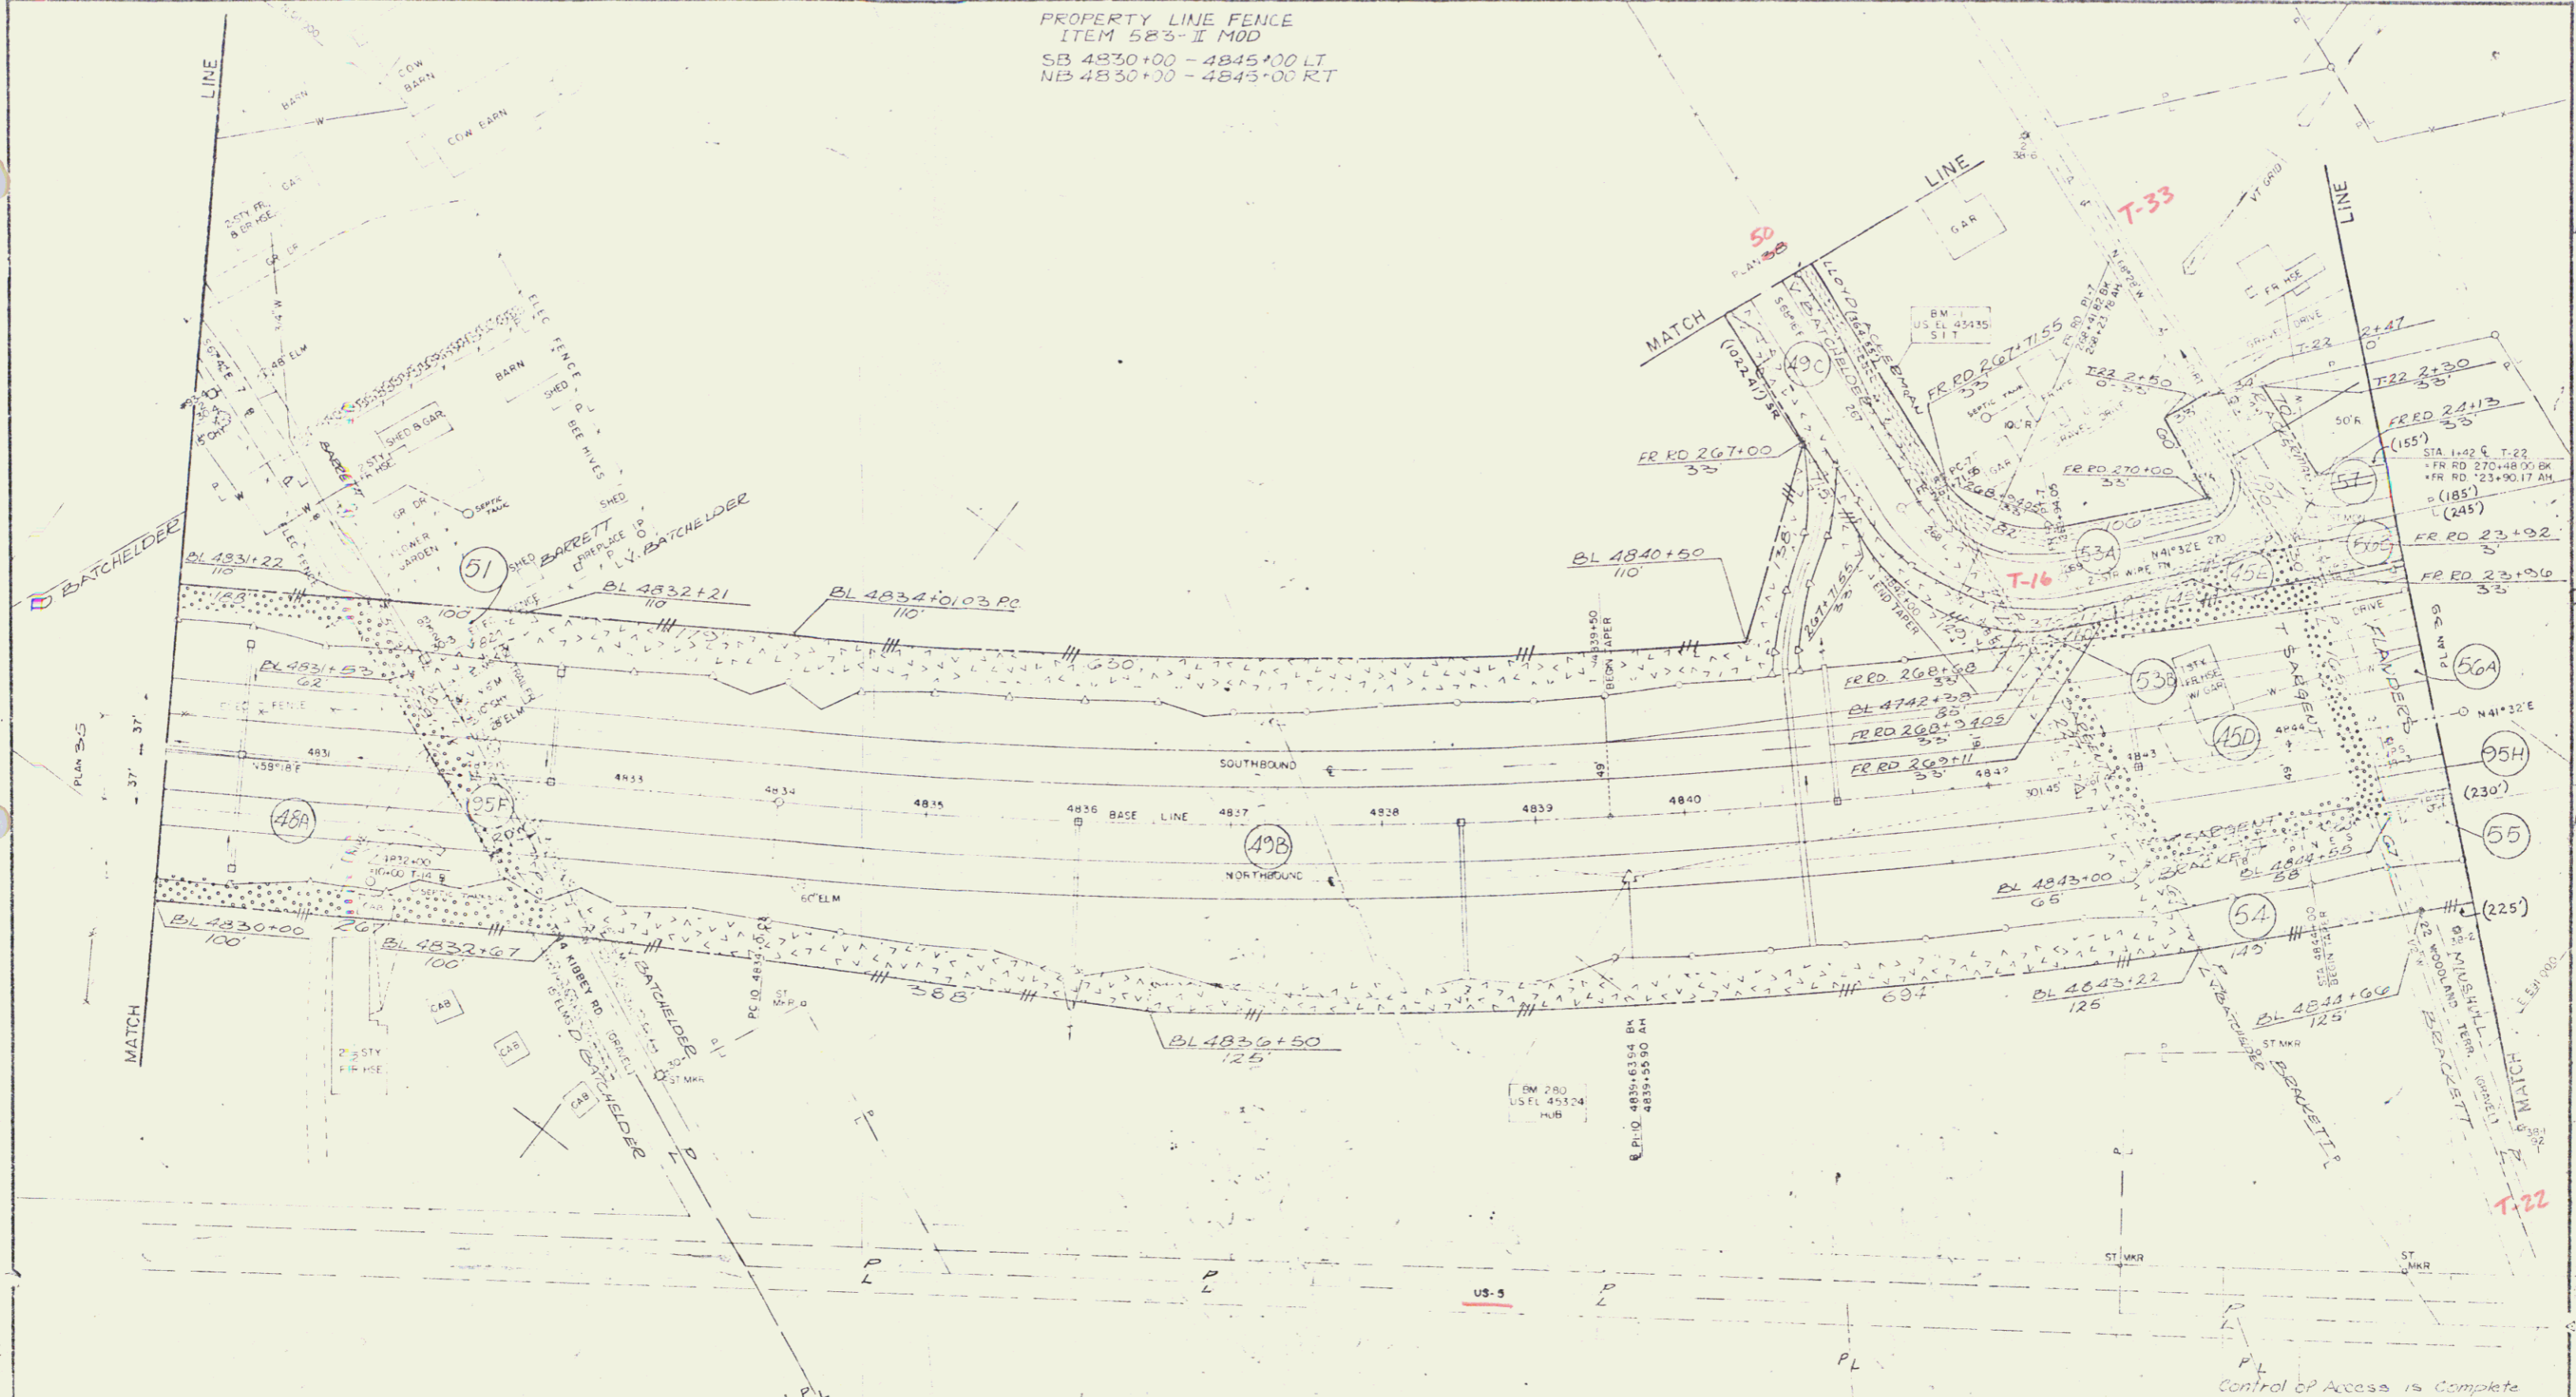

CURVE DATA

| PI-10 | FR RD. PI-7 |
|-------------------|-------------------|
| N 511 061.44 | N 511 344.18 |
| E 590 474.33 | E 590 536.37 |
| D = 117.30' | D = 57.17' 05" |
| L = 107.46' | L = 70.12' |
| L = 1819.72' | L = 100.00' |
| L = 147.91' | L = 70.12' |
| L = 114.77' | L = 122.50' |
| L = 112.6' | L = 22.22' |
| ARC = 1/2" PER FT | ARC = 1/2" PER FT |

Control of Access is Complete on this sheet

THETFORD - FAIRLEE
 RIGHT OF WAY PLANS
 STA 4830+00 TO STA 4845+00

DATE: 7/13/11
 PROJECT: 191-2 (14) SHEET: 49 OF 111

44

45