


TR 134+75 LT - NB 4536+95 RT CONSTRUCT PROPERTY LINE FENCE, ITEM 583 MOD. PRIOR TO COMMENCEMENT OF OTHER WORK IN THIS AREA.	PROPERTY LINE FENCE ITEM 583 - 2 MOD. NB 4520+00 - 4536+00 RT SB 4520+00 - 4536+00 LT	* STEEL BEAM GUARD RAIL ITEM 545 - A (SEE 1902001) SB 4533+00 - 4534+15 LT SB 4533+00 - 4535+75 RT NB 4533+00 - 4535+15 LT NB 4533+00 - 4535+15 RL	ADDITIONAL 1/2" SURFACING OF SAND ITEM 202 SB 4520+00 - 4531+00 NB 4520+00 - 4526+00	* THREE CABLE GUARD RAIL WITH LIGHT STEEL POSTS ITEM 538 NB 4520+00 - 4531+04 RT	STONE FILL FOR SLOPE PROTECT (HEAVY TYPE) - ITEM 611 SB 4534+25 RT (W/VELOCITY RETARDER)	RIPRAP - ITEM 613-A (HEAVY TYPE) SB 4534+25 RT SB 4534+25 LT NB 4534+25 RT NB 4534+25 LT
-----------------------------------------------------------------------------------------------------------------------------------------	------------------------------------------------------------------------------------------------	-------------------------------------------------------------------------------------------------------------------------------------------------------------------	-----------------------------------------------------------------------------------------------	----------------------------------------------------------------------------------------	---------------------------------------------------------------------------------------------------	---------------------------------------------------------------------------------------------------------



T-9 TIES		NB TIES		SB TIES	
RE-4' ELM	RE-20' BRUSH	RE-6' P	RE-6' P	RE-5' M	RE-24' P
RE-5' M	RE-2' ELM	RE-10' BRCH	RE-10' BRCH	RE-8' M	RE-35' P
RE-10' BRCH	RE-2' ELM	RE-10' BRCH	RE-10' BRCH	RE-8' M	RE-35' P
RE-10' BRCH	RE-2' ELM	RE-10' BRCH	RE-10' BRCH	RE-8' M	RE-35' P

CURVE DATA	
T-9, PI-2	N 484.09 23
E 577.135 05	
D = 543.45	
L = 290.35	
R = 1000'	
L = 506.79	
T = 258.71	
E = 32.96'	
BANK 6" R / 12" FT	

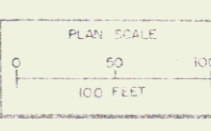

THETFORD - FAIRLEE
CONTRACT STAGE 2 CONSTRUCTION
STA. 4520+00 TO STA. 4536+00

CONTROL OF ACCESS IS COMPLETE ON THIS SHEET.
*STAGE 2 CONSTRUCTION

PROJECT 1 91-2 (3) SHEET 52 OF 60