


PROPERTY LINE FENCE ITEM 563-3L WOOD SB 4550+00-4555+00 LT NB 4550+00-4555+00 RT	DRILLING & BLASTING OF SOLID ROCK SUBGRADE ITEM 115 SB 4550+00-4558+50 NB 4550+00-4550+50	* THREE CABLE GUARD RAIL WITH LIGHT STEEL POSTS ITEM 538 NB 4555+04-4561+50 RT NB 4555+04-4561+50 LT SB 4557+00-4557+50 RT SB 4557+00-4557+50 LT	STONE FILL FOR SLOPE PROTECT. (HEAVY TYPE)-ITEM 511 NB 4550+00 RT (W/ VELOCITY RETARDER) SB 4552+00	* TREATED TIMBER CURB ITEM 550 NB 4558+00-4564+00 RT SB 4558+00-4564+00 RT
---	---	--	---	--


NB 4550+00-4555+00 RT. CONSTRUCT PROPERTY LINE FENCE, ITEM 563, MOD. PRIOR TO COMMENCEMENT OF OTHER WORK IN THIS AREA.

STEEL BEAM GUARD RAIL WITH STEEL POSTS ITEM 545A (3 STRANDS)
 NB 4549+75-4554+25 RT
 NB 4550+25-4554+25 LT
 SB 4553+00-4553+50 RT
 SB 4553+00-4553+50 LT

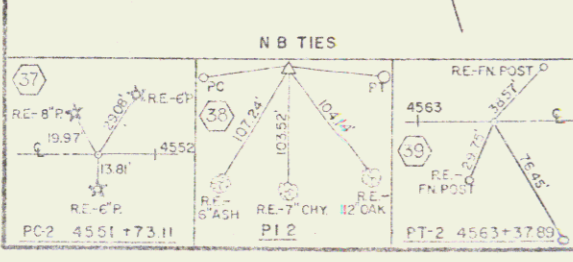

CURVE DATA

NB PI-2		SB PI-2	
ST	4555.0000	ST	4557.0000
RE	537.78178	RE	4557.0000
D	0°30'	D	0°44'42.40"
A	5°43'25"	A	7°18'00"
R	11,409.91'	R	7659.44'
T	302.89'	T	408.27'
L	1,164.78'	L	975.23'
E	14.82'	E	15.45'
BANK	1/4' PER FT	BANK	1/4' PER FT

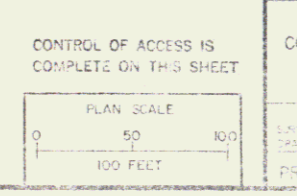

CONTROL OF ACCESS IS COMPLETE ON THIS SHEET

THETFORD-FAIRLEE CONTRACT
 STAGE 2 CONSTRUCTION
 STA. 4550+00 TO STA. 4565+00

PROJECT 1 91-2 (9) SHEET 58 OF 160