


ADDITIONAL ITEM 503
ITEM 503
NB 4568+00-4574+00
SB 4574+00-4578+00

PROPERTY LINE FENCE
ITEM 503-TI MOD.
SB 4574+00-4574+00
SB 4574+00-4574+00
NB 4573+00-4573+00
NB 4573+00-4573+00

WITH 1 1/2" DIA. RAIL WITH
LIGHT STEEL POSTS ITEM 503
NB 4568+00-4568+00
NB 4572+00-4572+00
SB 4573+00-4573+00
SB 4573+00-4573+00

STONE FILL FOR SLOPE PROTECT
(HEAVY TYPE)-ITEM 511
NB 4574+00-4574+00
NB 4574+00-4574+00
(W/ VELOCITY RETARDER)

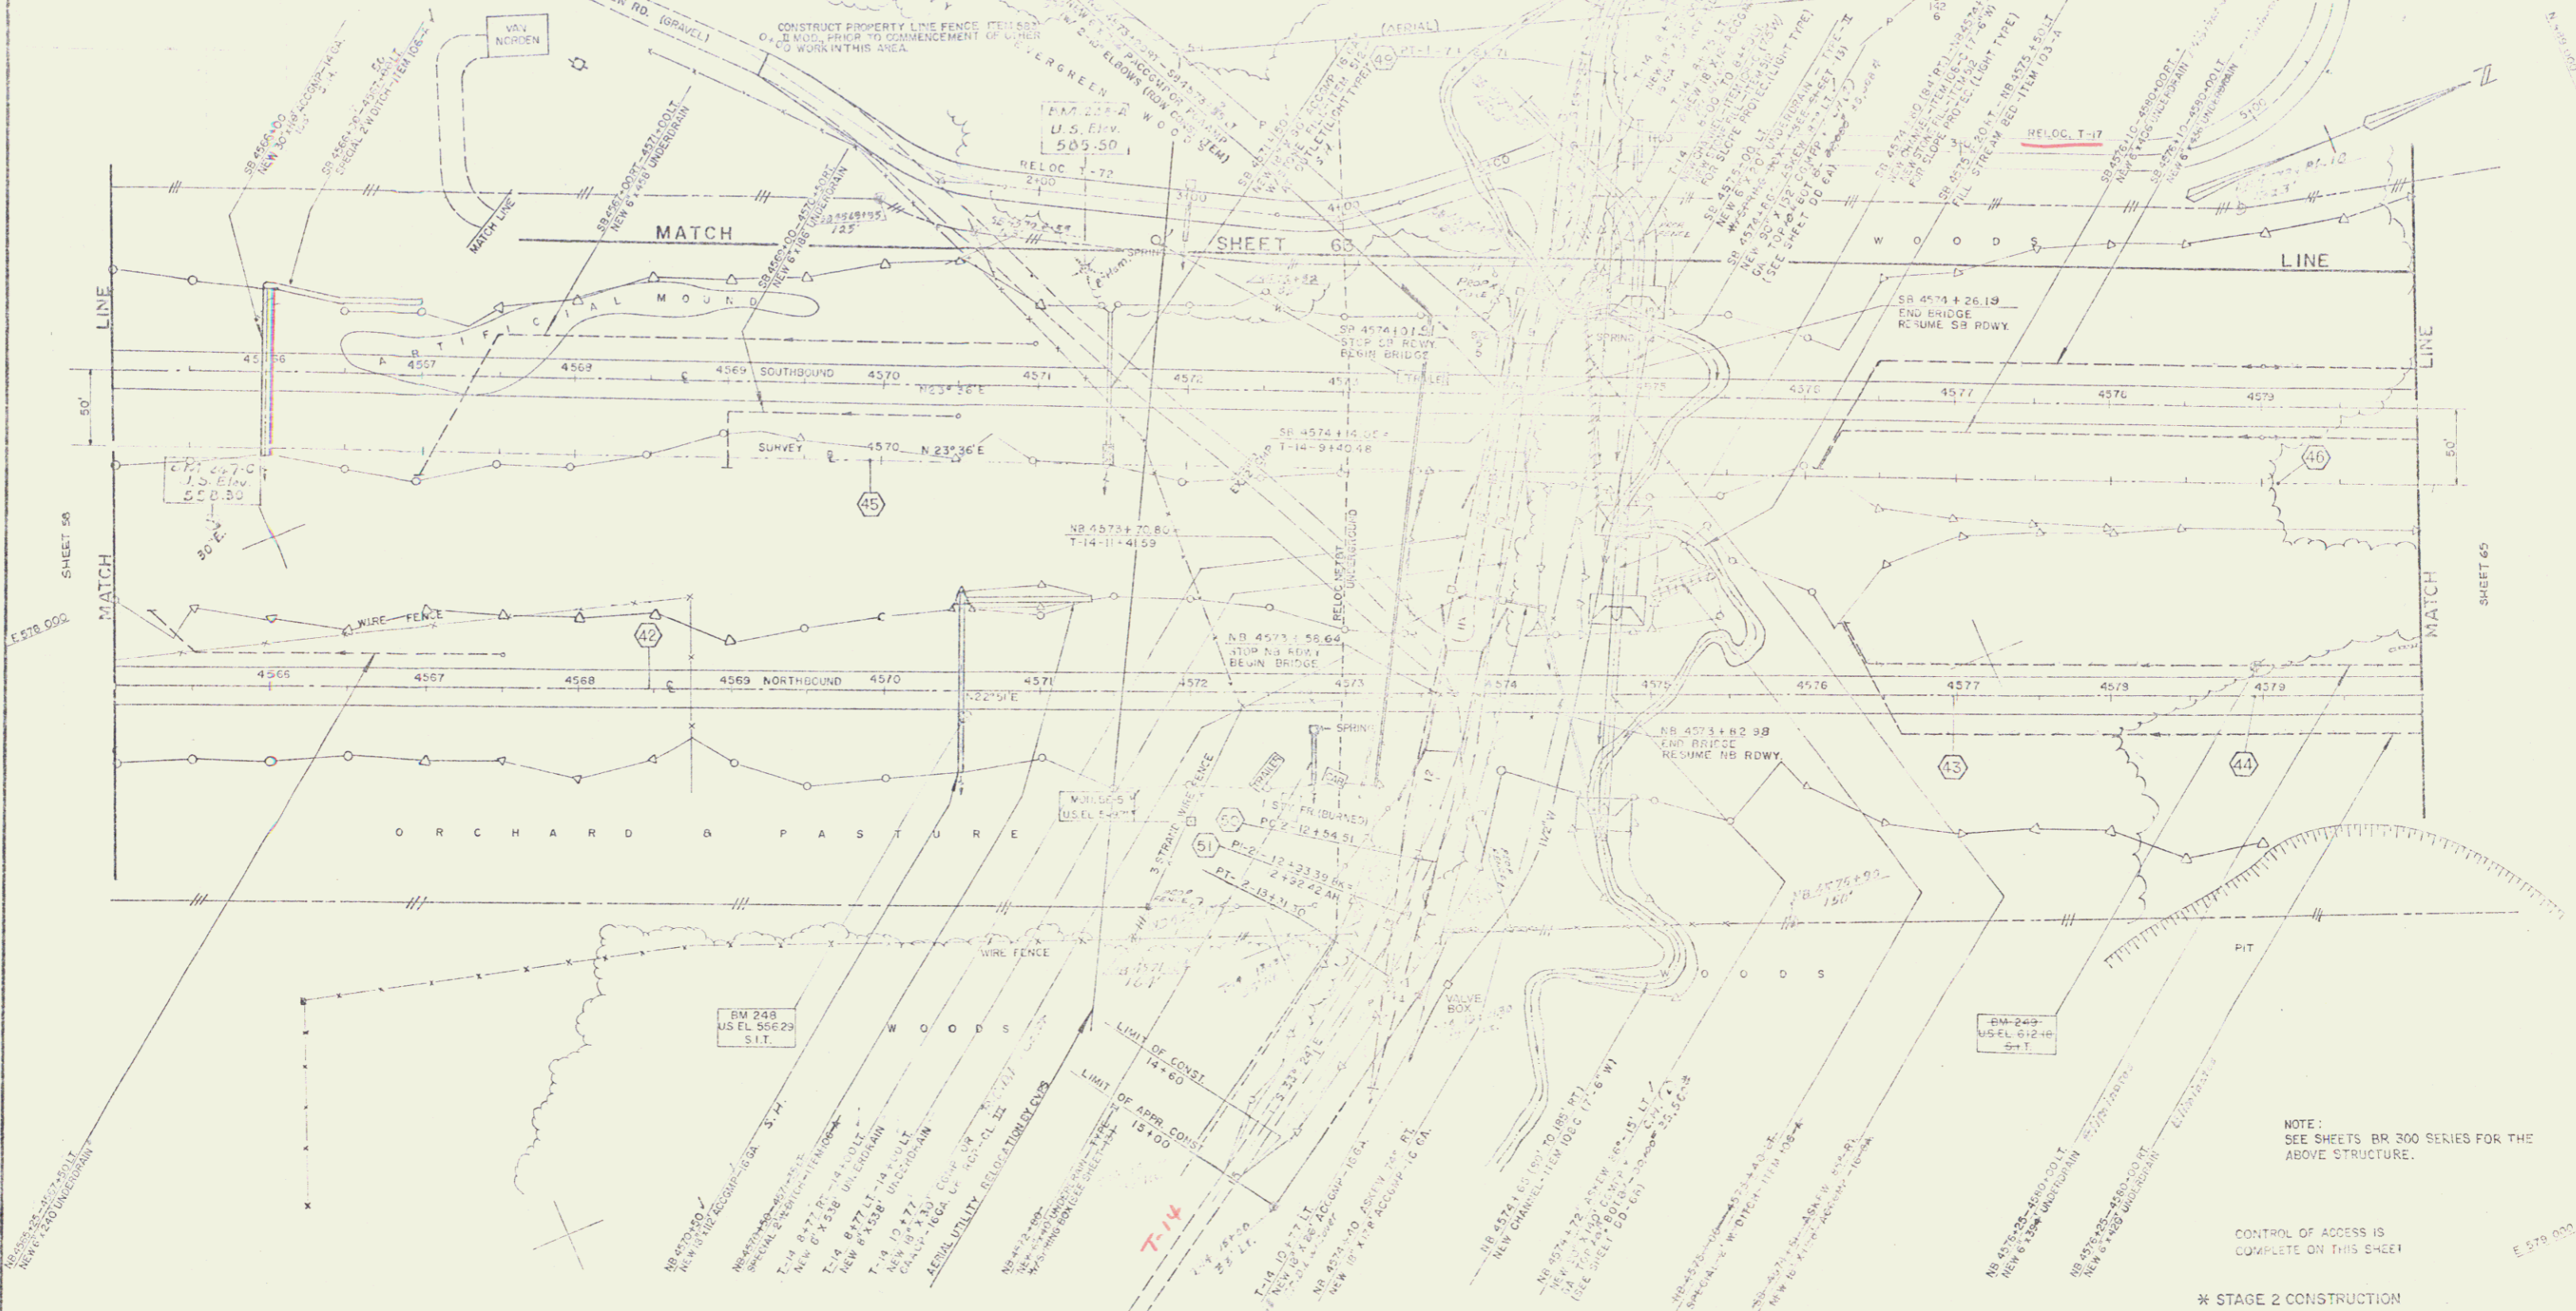

NOTE:
SEE SHEETS BR 300 SERIES FOR THE
ABOVE STRUCTURE.

CONTROL OF ACCESS IS
COMPLETE ON THIS SHEET

* STAGE 2 CONSTRUCTION

NB TIES		SB TIES		RELOC T-14 TIES		T-14 PELOC-CURVE DATA	
42	RE-47P STA 4568+45.08	43	RE-47P STA 4571+25.16	44	RE-47P STA 4574+02.48	45	RE-47P STA 4577+11.16
46	RE-47P STA 4570+14.14	47	RE-47P STA 4573+03.14	48	RE-47P STA 4576+12.14	49	RE-47P STA 4579+01.14
50	RE-47P STA 4582+00.14	51	RE-47P STA 4585+09.14	52	RE-47P STA 4588+18.14	53	RE-47P STA 4591+27.14
54	RE-47P STA 4594+36.14	55	RE-47P STA 4597+45.14	56	RE-47P STA 4600+54.14	57	RE-47P STA 4603+63.14

THEYFORD-FAIRLEE
CONTRACT STAGE 2 CONSTRUCTION
STA 4568+00 TO STA 4580+00

PROJECT I 91-2 (3) SHEET 60