

NR 458425--4595+00 RT
 CONSTRUCT PROPERTY LINE FENCE, ITEM 533-II
 MOD. PRIOR TO COMMENCEMENT OF OTHER WORK
 IN THIS AREA.


PROPERTY LINE FENCE
 ITEM 533-II MOD.
 SB 4580+00--4595+00 LT
 NB 4580+00--4595+00 RT

DRILLING & BLASTING OF SOLID ROCK
 SUBGRADE
 ITEM 115
 SB 4593+50--4595+00

ADDITIONAL 12" SUBGRADE OF SAND
 ITEM 202
 NR 4592+00--4595+00


THREE CABLE GUARD RAIL WITH
 LIGHT STEEL POSTS
 ITEM 538
 NB 4583+04--4592+00 RT
 NB 4583+04--4592+00 LT
 SB 4584+06--4592+00 RT

PLANK GUARD RAIL
 ITEM 540
 NB 4581+20 RT

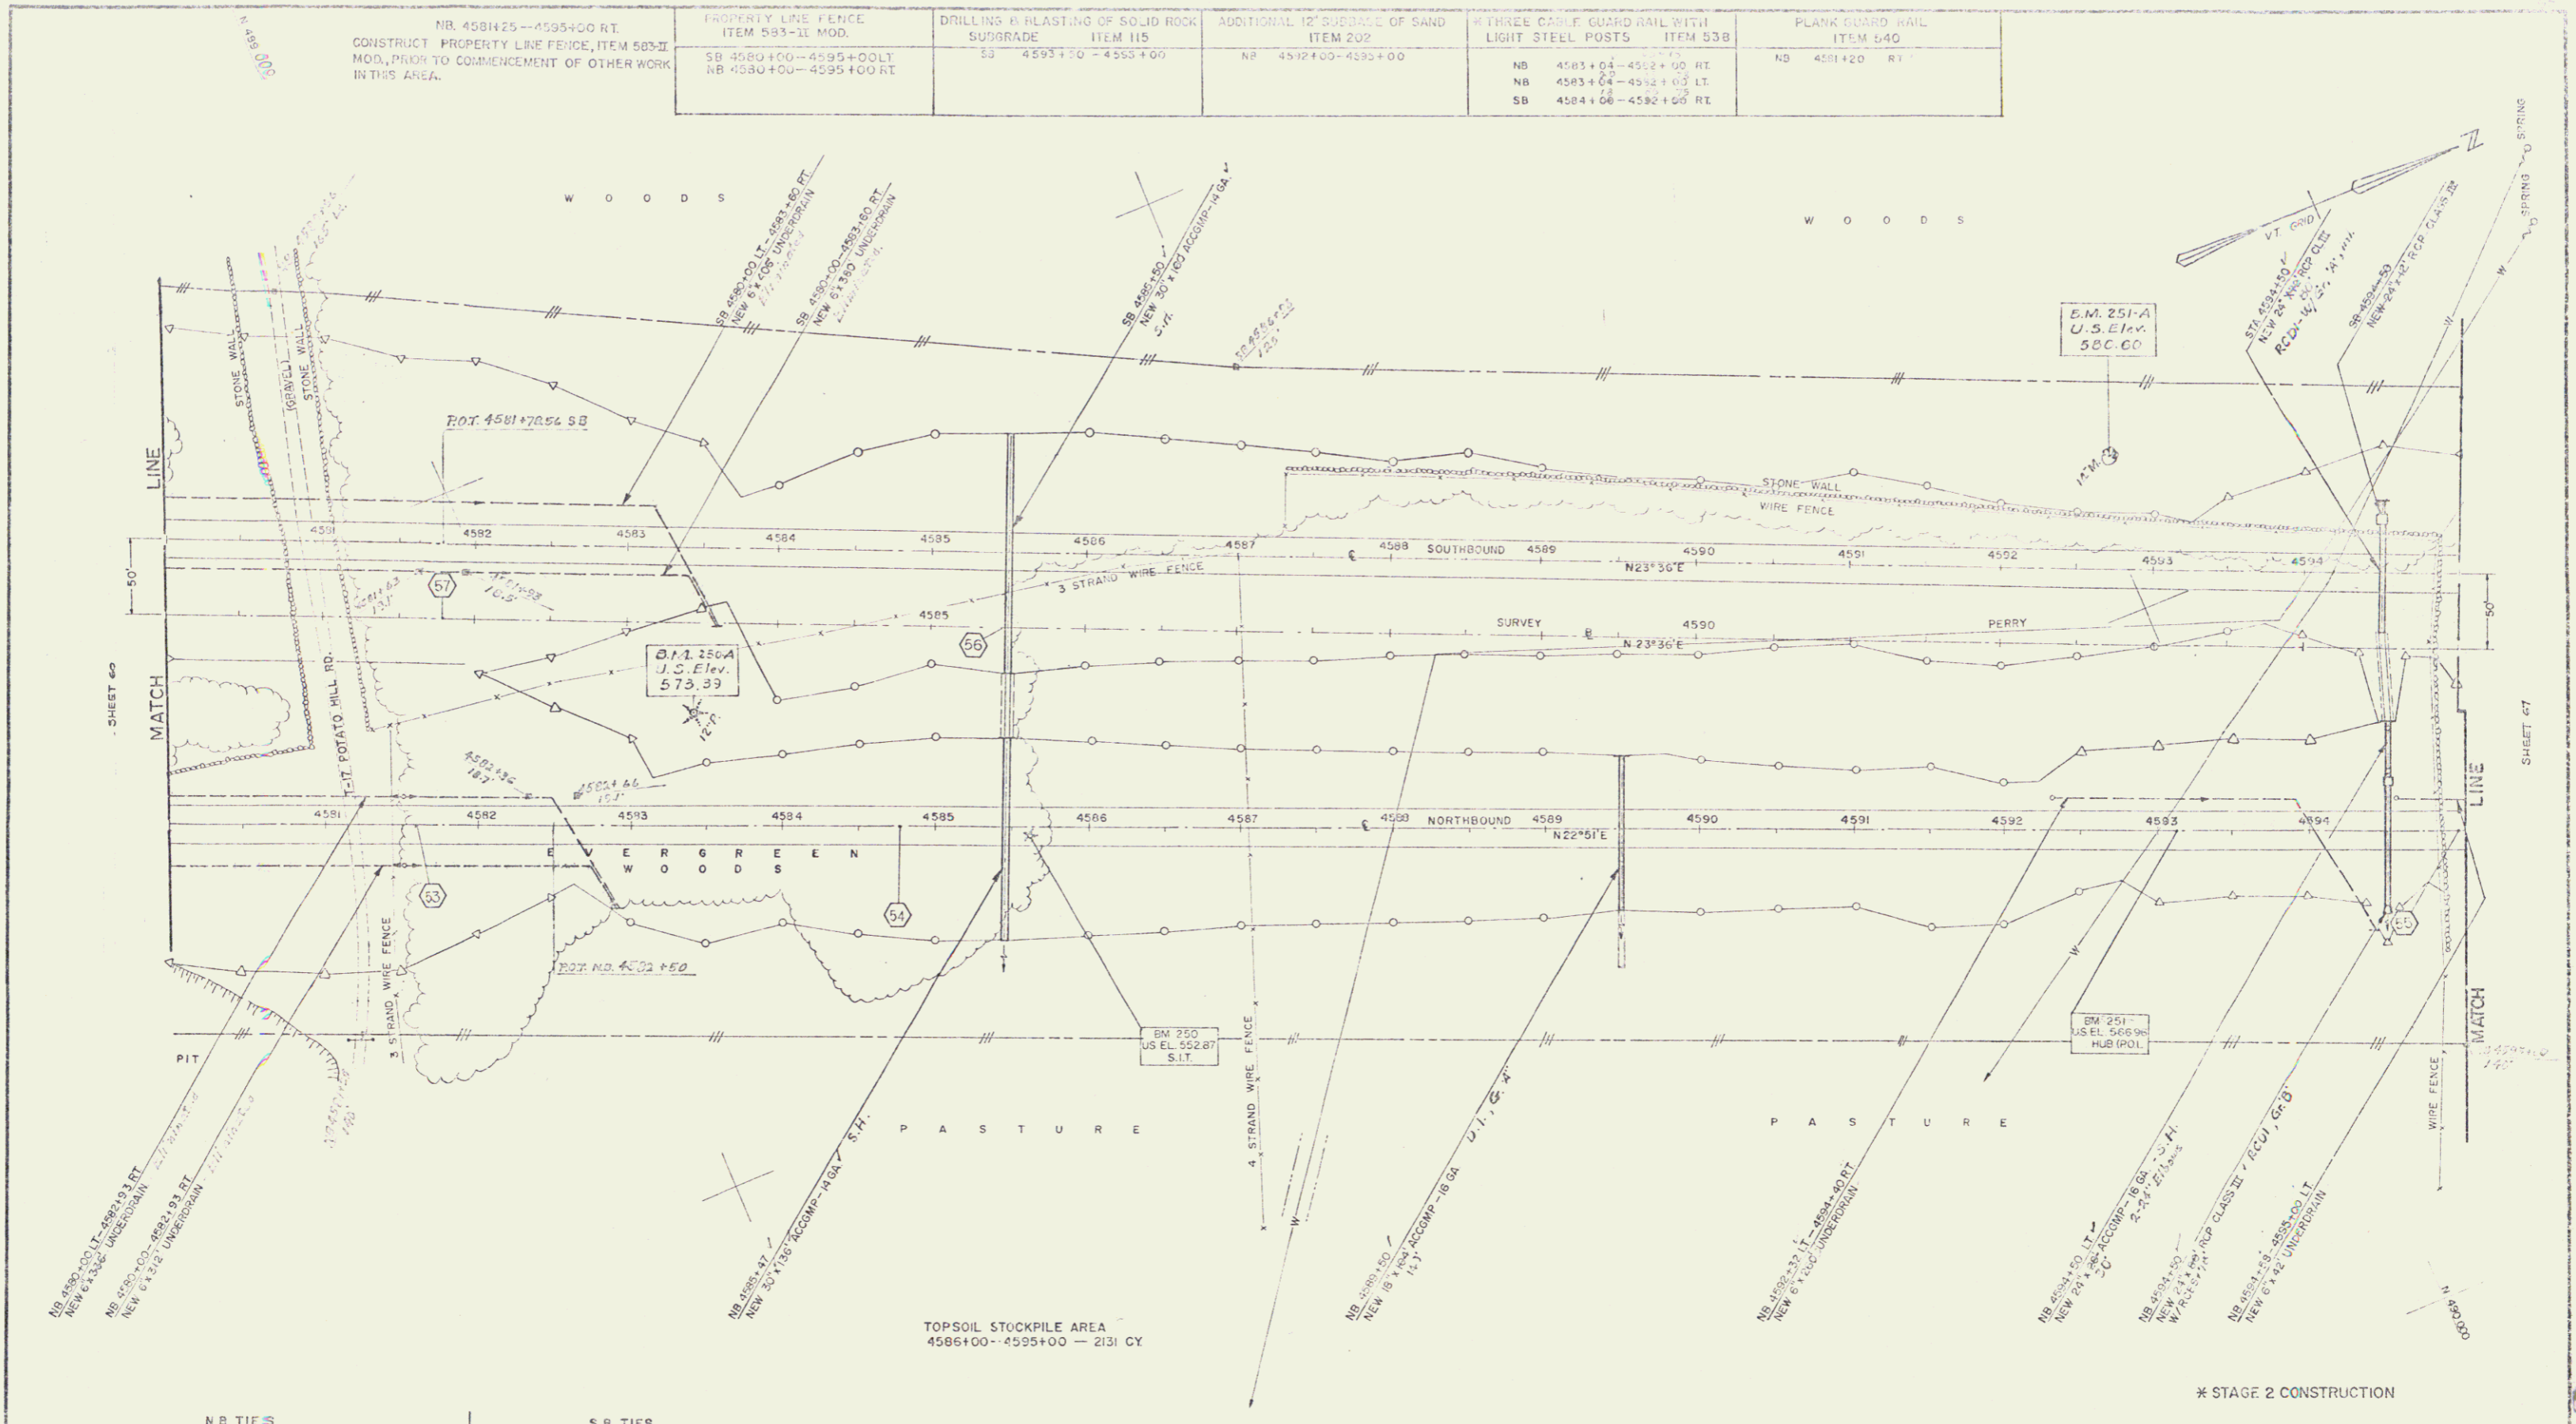

NB TIES		SB TIES		
RE-14" P 20.77' STA 4591+59.74	RE-15" P 13.91' STA 4584+75.52	RE-15" POST 15.0' STA 4594+55.85	RE-6" HEM 14.7' STA 4585+46.24	RE-6" HEM 13.02' 18.04' STA 4591+76.50

CONTROL OF ACCESS IS
 COMPLETE ON THIS SHEET

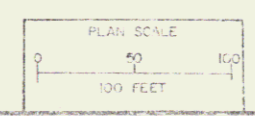

THE IFORD - FAIRLEE
 CONTRACT STAGE 2 CONSTRUCTION
 STA. 4580+00 TO STA 4595+00

PROJECT 91-2 (9) SHEET 65 OF 65