



*STD STEEL BEAM GUARD RAIL WITH STEEL POSTS ITEM 545A
 SB 4623+50 - 4625+00 RT.

DRILLING & BLASTING OF SOLID ROCK SUBGRADE ITEM 115
 SB 4619+00 - 4619+50
 SB 4615+00 - 4625+00

ADDITIONAL 12" SUBGRADE OF SAND ITEM 202
 NB 4616+00 - 4620+50

THREE CABLE GUARD RAIL WITH STEEL POSTS ITEM 539
 NB 4610+00 - 4619+50 RT
 NB 4623+00 - 4625+00 RT
 SB 4623+50 - 4625+00 RT

PROPERTY LINE FENCE ITEM 593-II MOD.
 NB 4610+00 - 4625+00 RT
 SB 4610+00 - 4625+00 LT

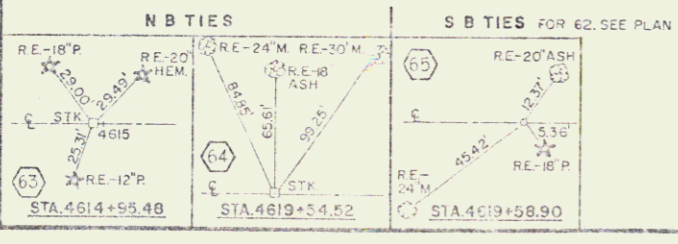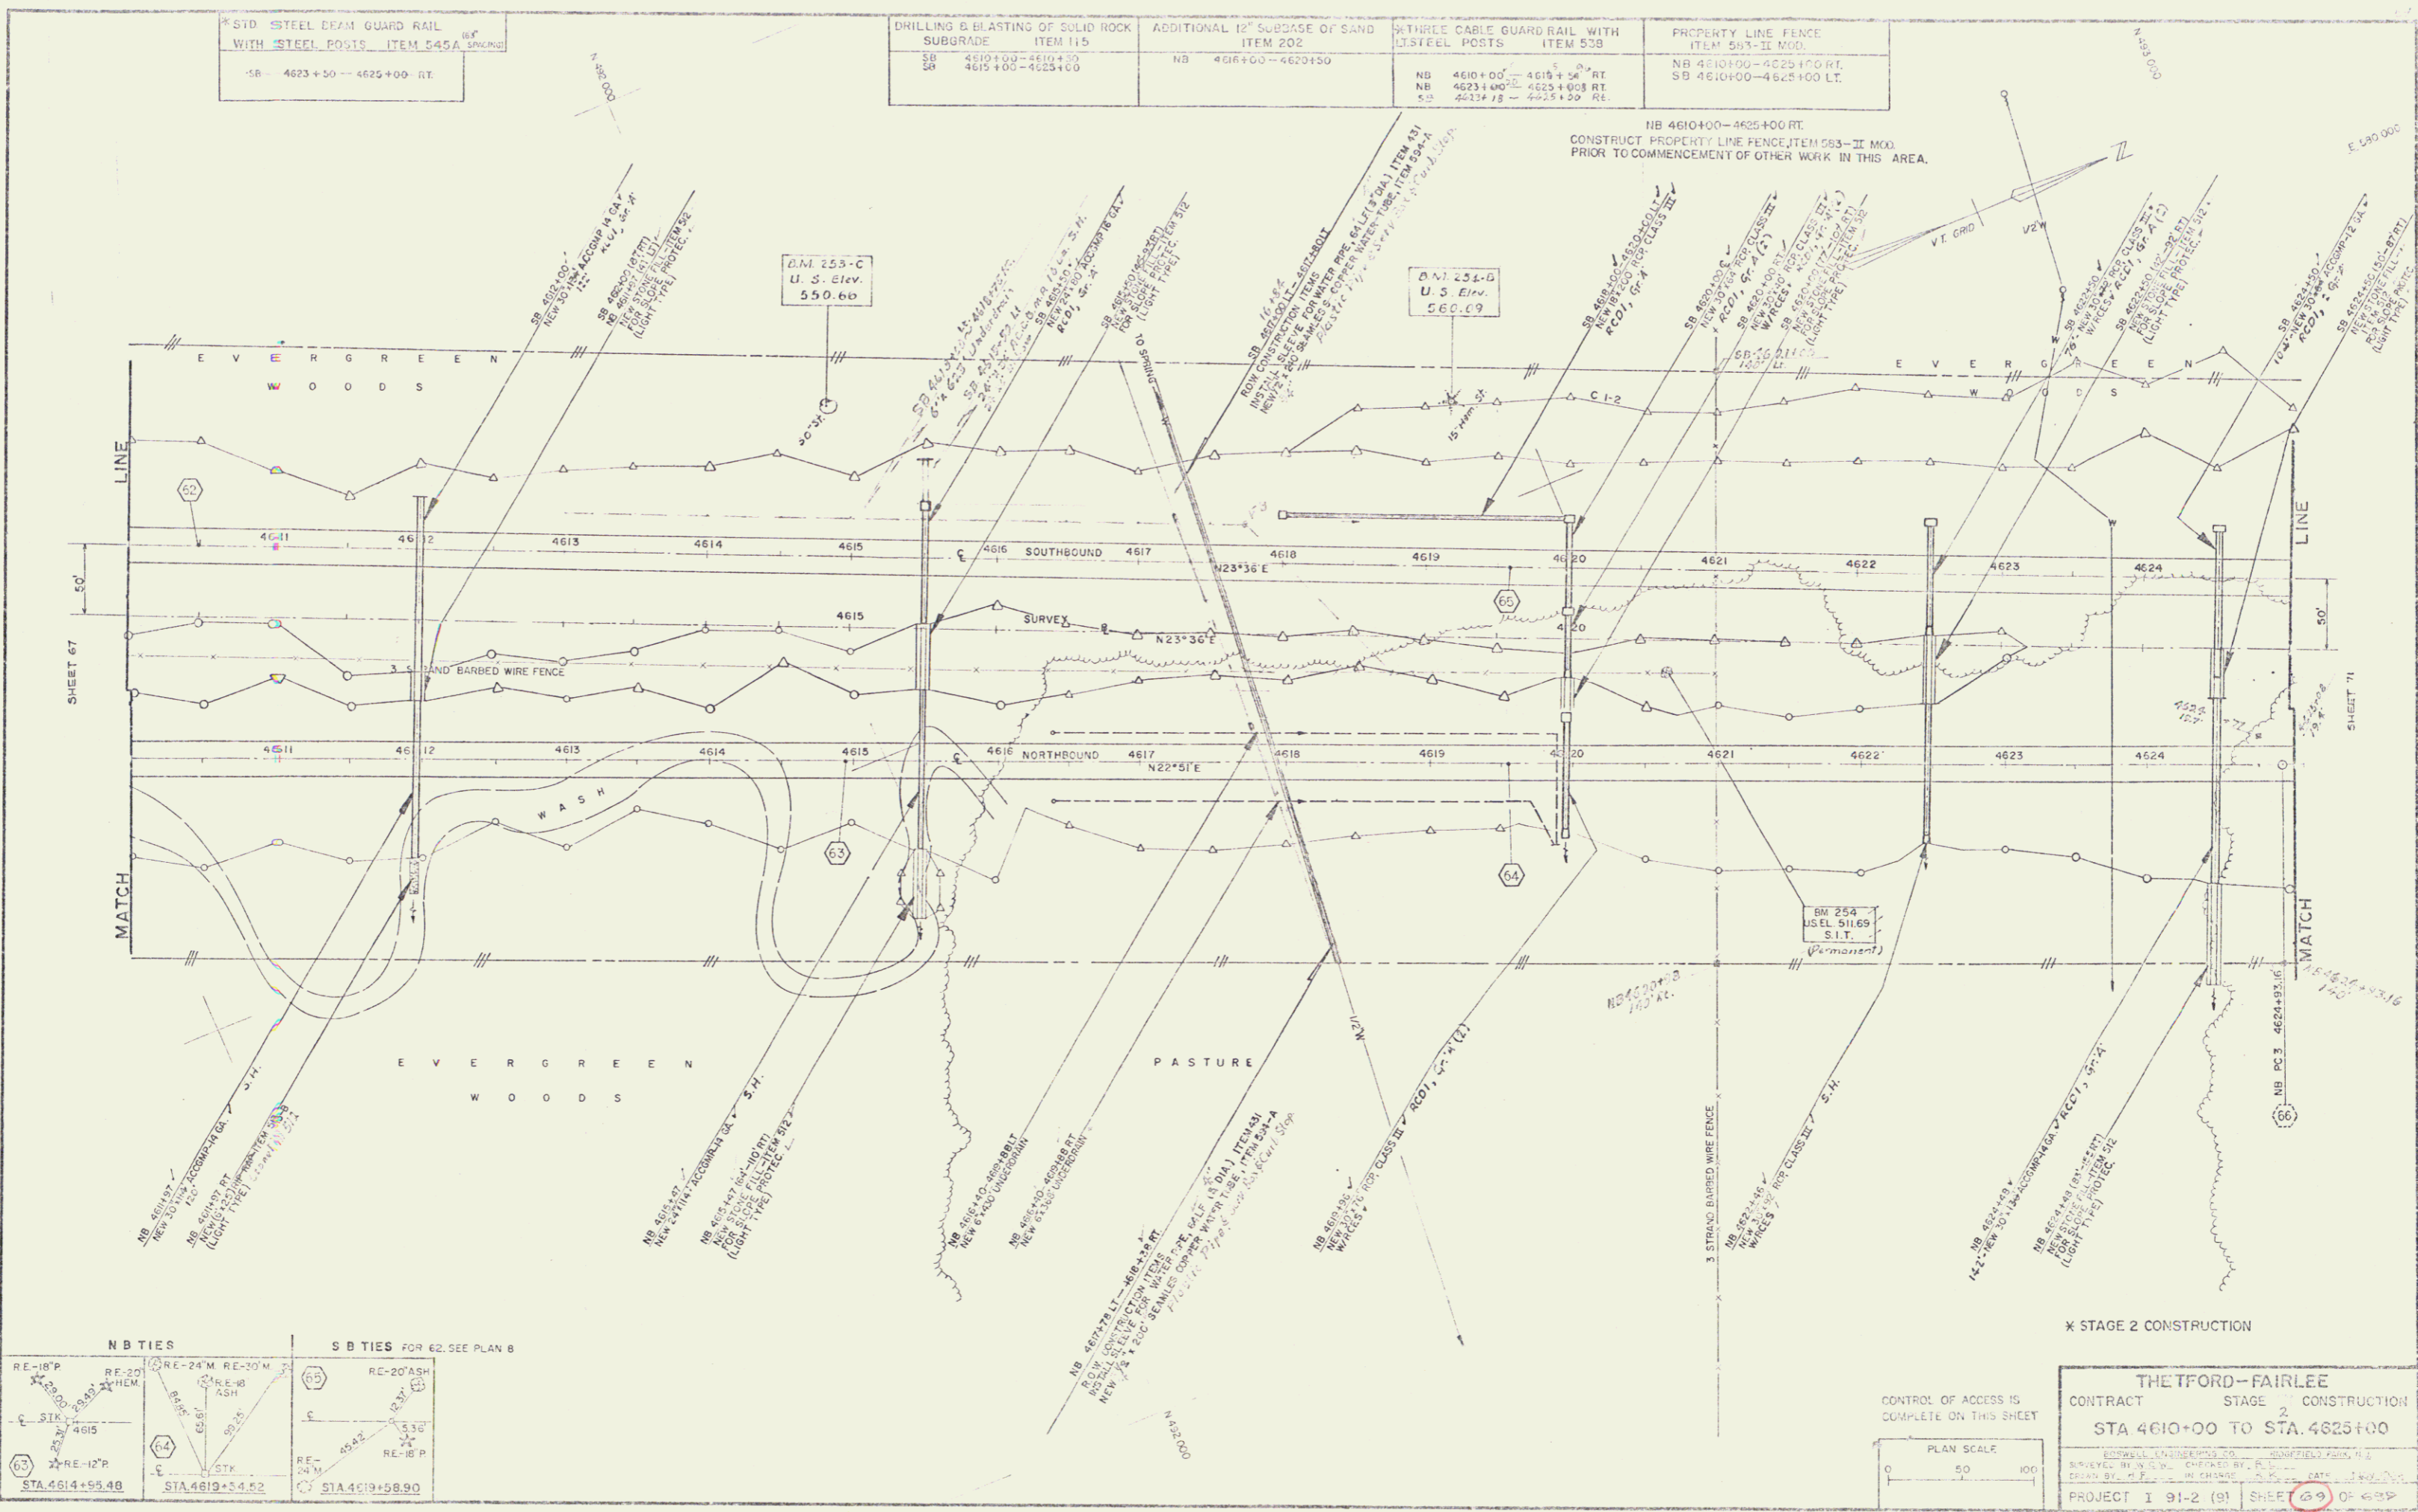

CONTROL OF ACCESS IS COMPLETE ON THIS SHEET

PLAN SCALE
 0 50 100

THE TFORD - FAIRLEE
 CONTRACT STAGE 2 CONSTRUCTION
 STA 4610+00 TO STA. 4625+00

EDWARDS ENGINEERING CO. - FAIRFIELD, PA, U.S.A.
 DRAWN BY: J.E.W. CHECKED BY: J.P.C. DATE: 10/1/79
 PROJECT 1 91-2 (91) SHEET 69 OF 69
 (24) 44 of 100