
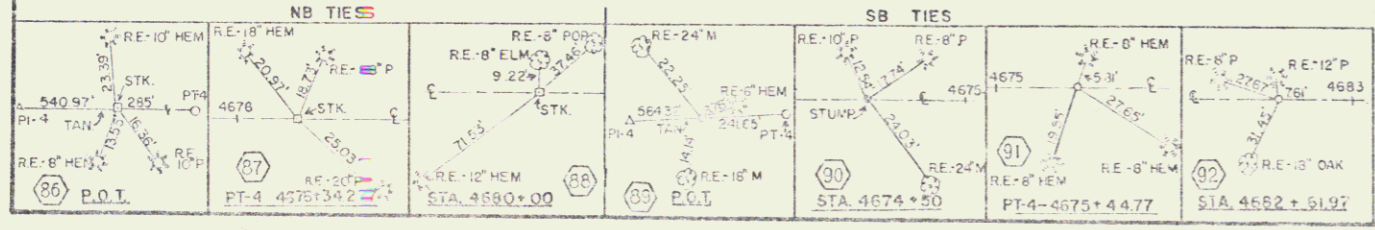


STD. STEEL BEAM GUARD RAIL WITH VIII STEEL POSTS ITEM 503A	PROPERTY LINE FENCE ITEM 503-B MCD.	* JUTE MATTING ITEM 625	MUCK EXCAVATION-ITEM 117	ADDITIONAL 12" SUBBASE OF SAND ITEM 202	THREE CABLE GUARD RAIL WITH LIGHT STEEL POSTS ITEM 538	STONE FILL FOR SLOPE PROTEC. (HEAVY TYPE)-ITEM 511	RIPRAP - ITEM 511-A (HEAVY TYPE)
NB 4671+00-4673+00 RT NB 4677+00-4679+00 RT	NB 4670+00-4685+00 RT SB 4670+00-4685+00 LT	NB 4670+00-4674+33 LT (MED) NB 4677+00-4680+50 LT (MED)	SB 4683+00-4685+00	NB 4681+00-4685+00	NB 4670+00-4674+00 RT SB 4670+00-4674+00 LT	NB 4678+00-4679+80 RT ✓	NB 4672+00 RT

NB 4670+00-4672+30RT.
NB 4678+00-4685+00RT.
CONSTRUCT PROPERTY LINE FENCE ITEM 503-B MCD.
PRIOR TO COMMENCEMENT OF OTHER WORK IN THIS AREA.

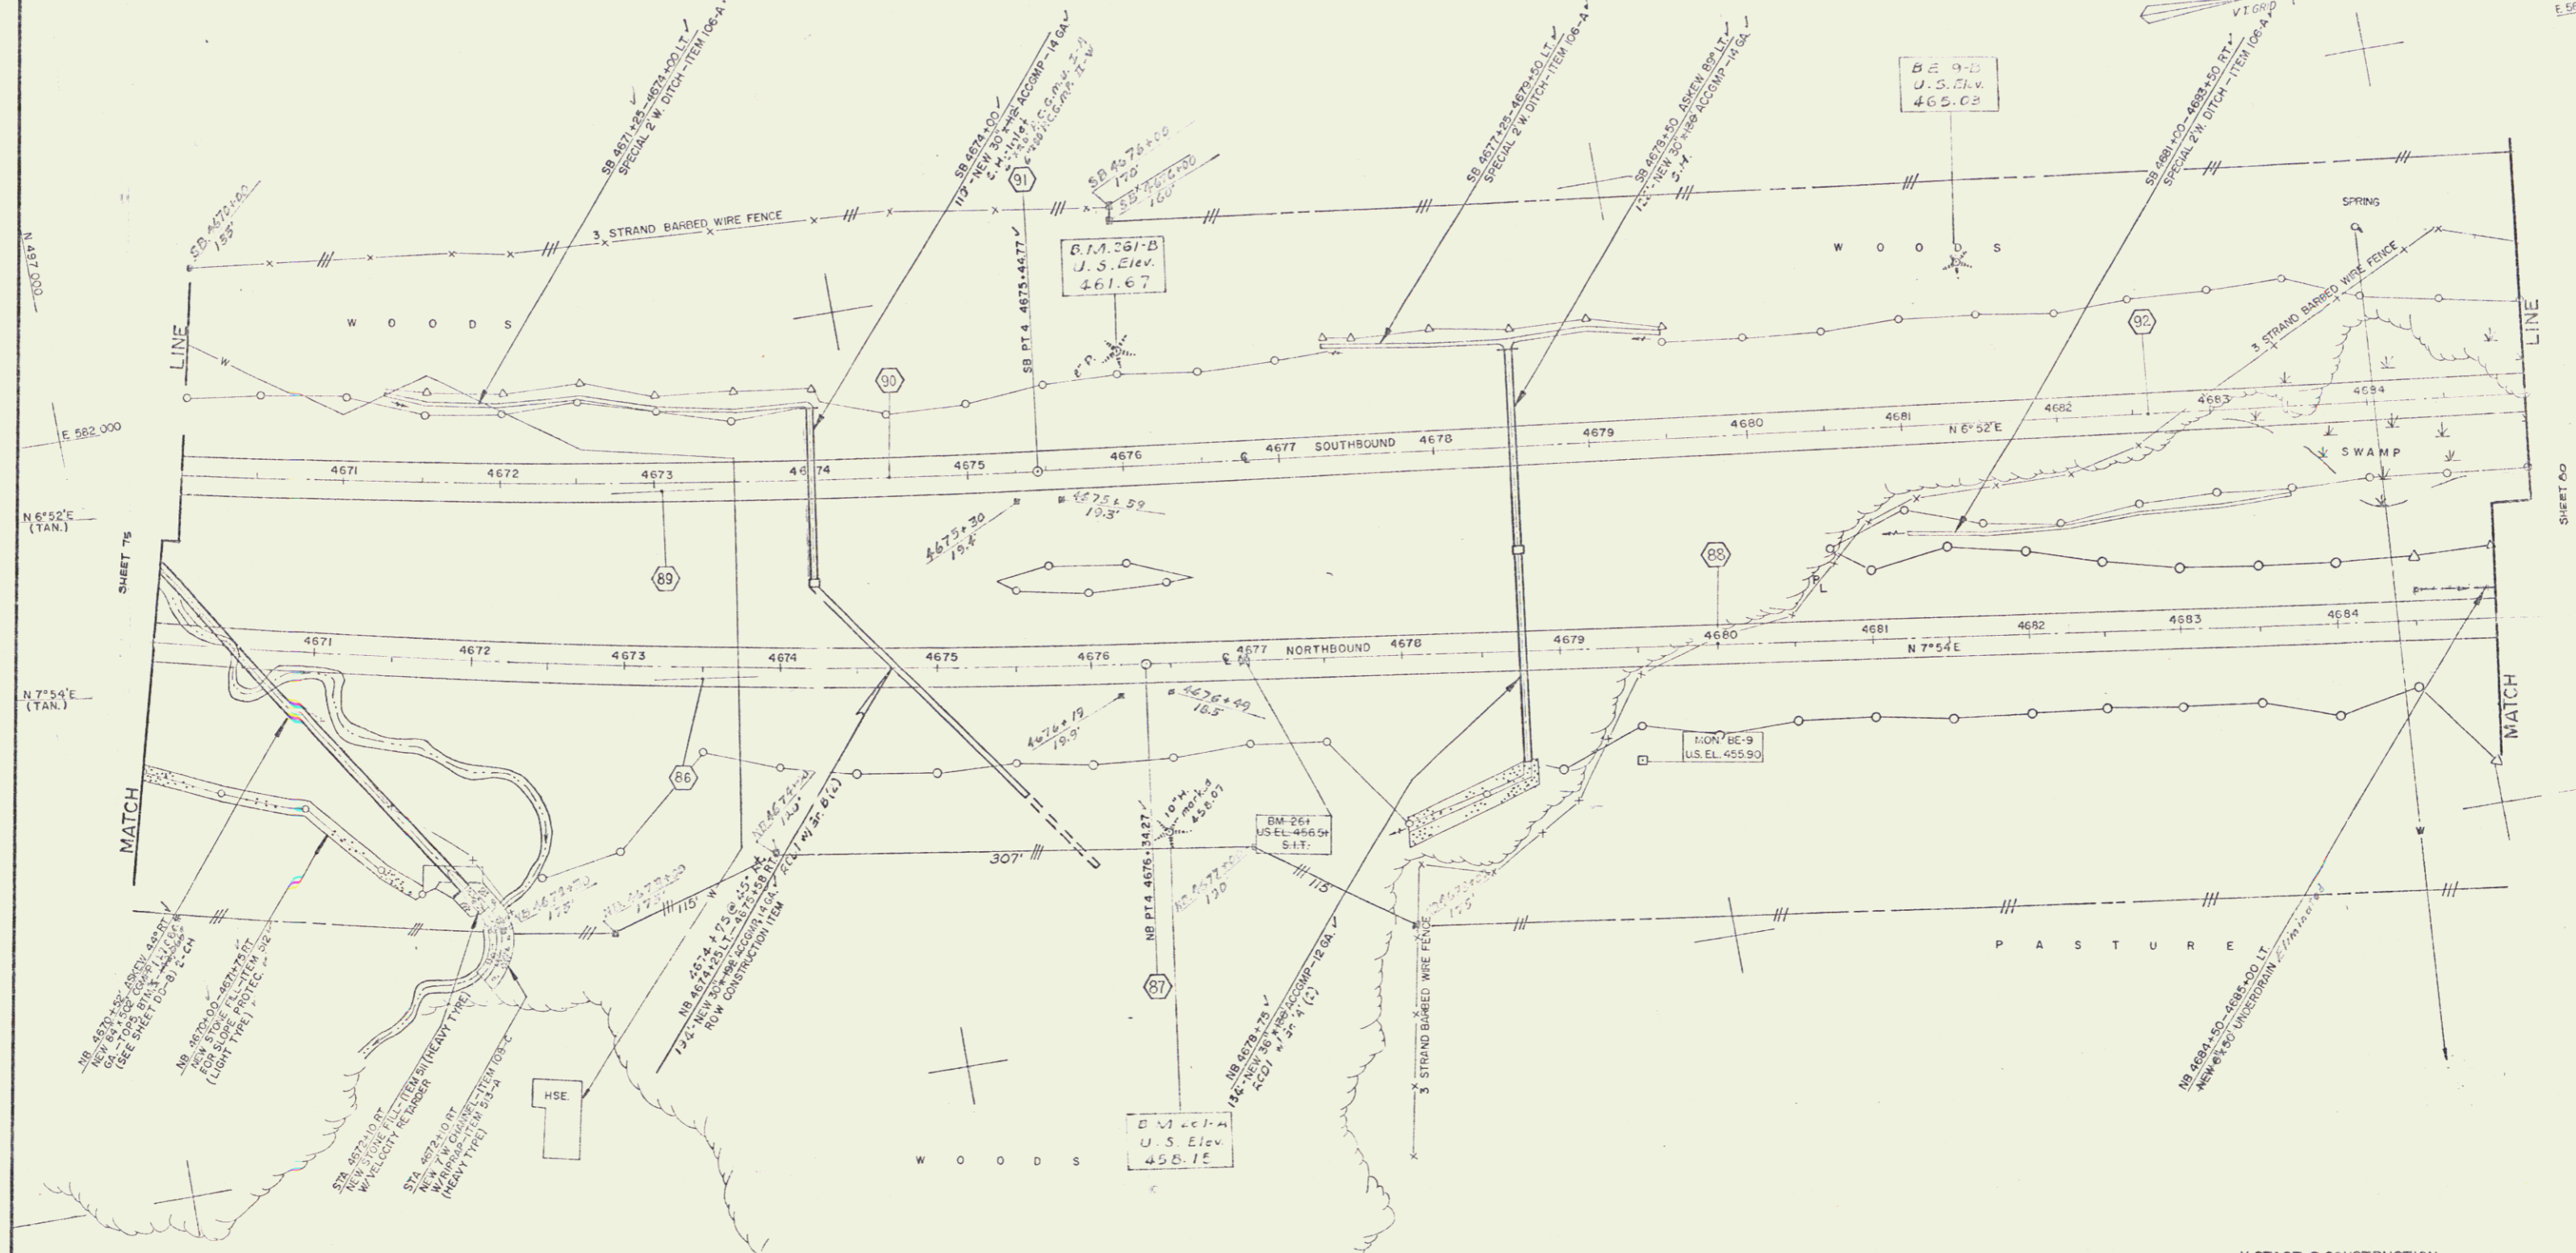

CONTROL OF ACCESS IS COMPLETE ON THIS SHEET

PLAN SCALE
0 50 100
100 FEET

* STAGE 2 CONSTRUCTION

THETFORD - FAIRLEE
CONTRACT STAGE 2 CONSTRUCTION
STA. 4670+00 TO STA. 4685+00

DESIGNED BY: [blank] CHECKED BY: [blank] DATE: [blank]
PROJECT: I 91-2 (5) SHEET 78 OF 130

79