


DEMOLITION AND DISPOSAL OF BUILDINGS ITEM 505	DRILLING & BLASTING OF SOLID ROCK ITEM 114
NB 4724+00 LT	SB 4715+00-4722+00

* TREATED TIMBER CURB ITEM 508	PROPERTY LINE FENCE ITEM 503 - II MOD.
NB 4715+00-4722+00 LT	NB 4715+00-4730+00 RT SB 4720+00-4730+00 LT NB 4715+00-4724+50 RT SB 4720+72-4730+00 LT

* THREE CABLE GUARD RAIL WITH LIGHT STEEL POSTS ITEM 528	* STD STEEL BEAM GUARD RAIL WITH STEEL POSTS ITEM 505A
NB 4715+00-4718+44 RT NB 4720+50-4724+50 RT NB 4715+00-4723+50 LT SB 4715+00-4723+46 RT	NB 4718+36-4720+61 RT

CONSTRUCT PROPERTY LINE FENCE ITEM 503-II PRIOR TO COMMENCEMENT OF OTHER WORK IN THIS AREA.

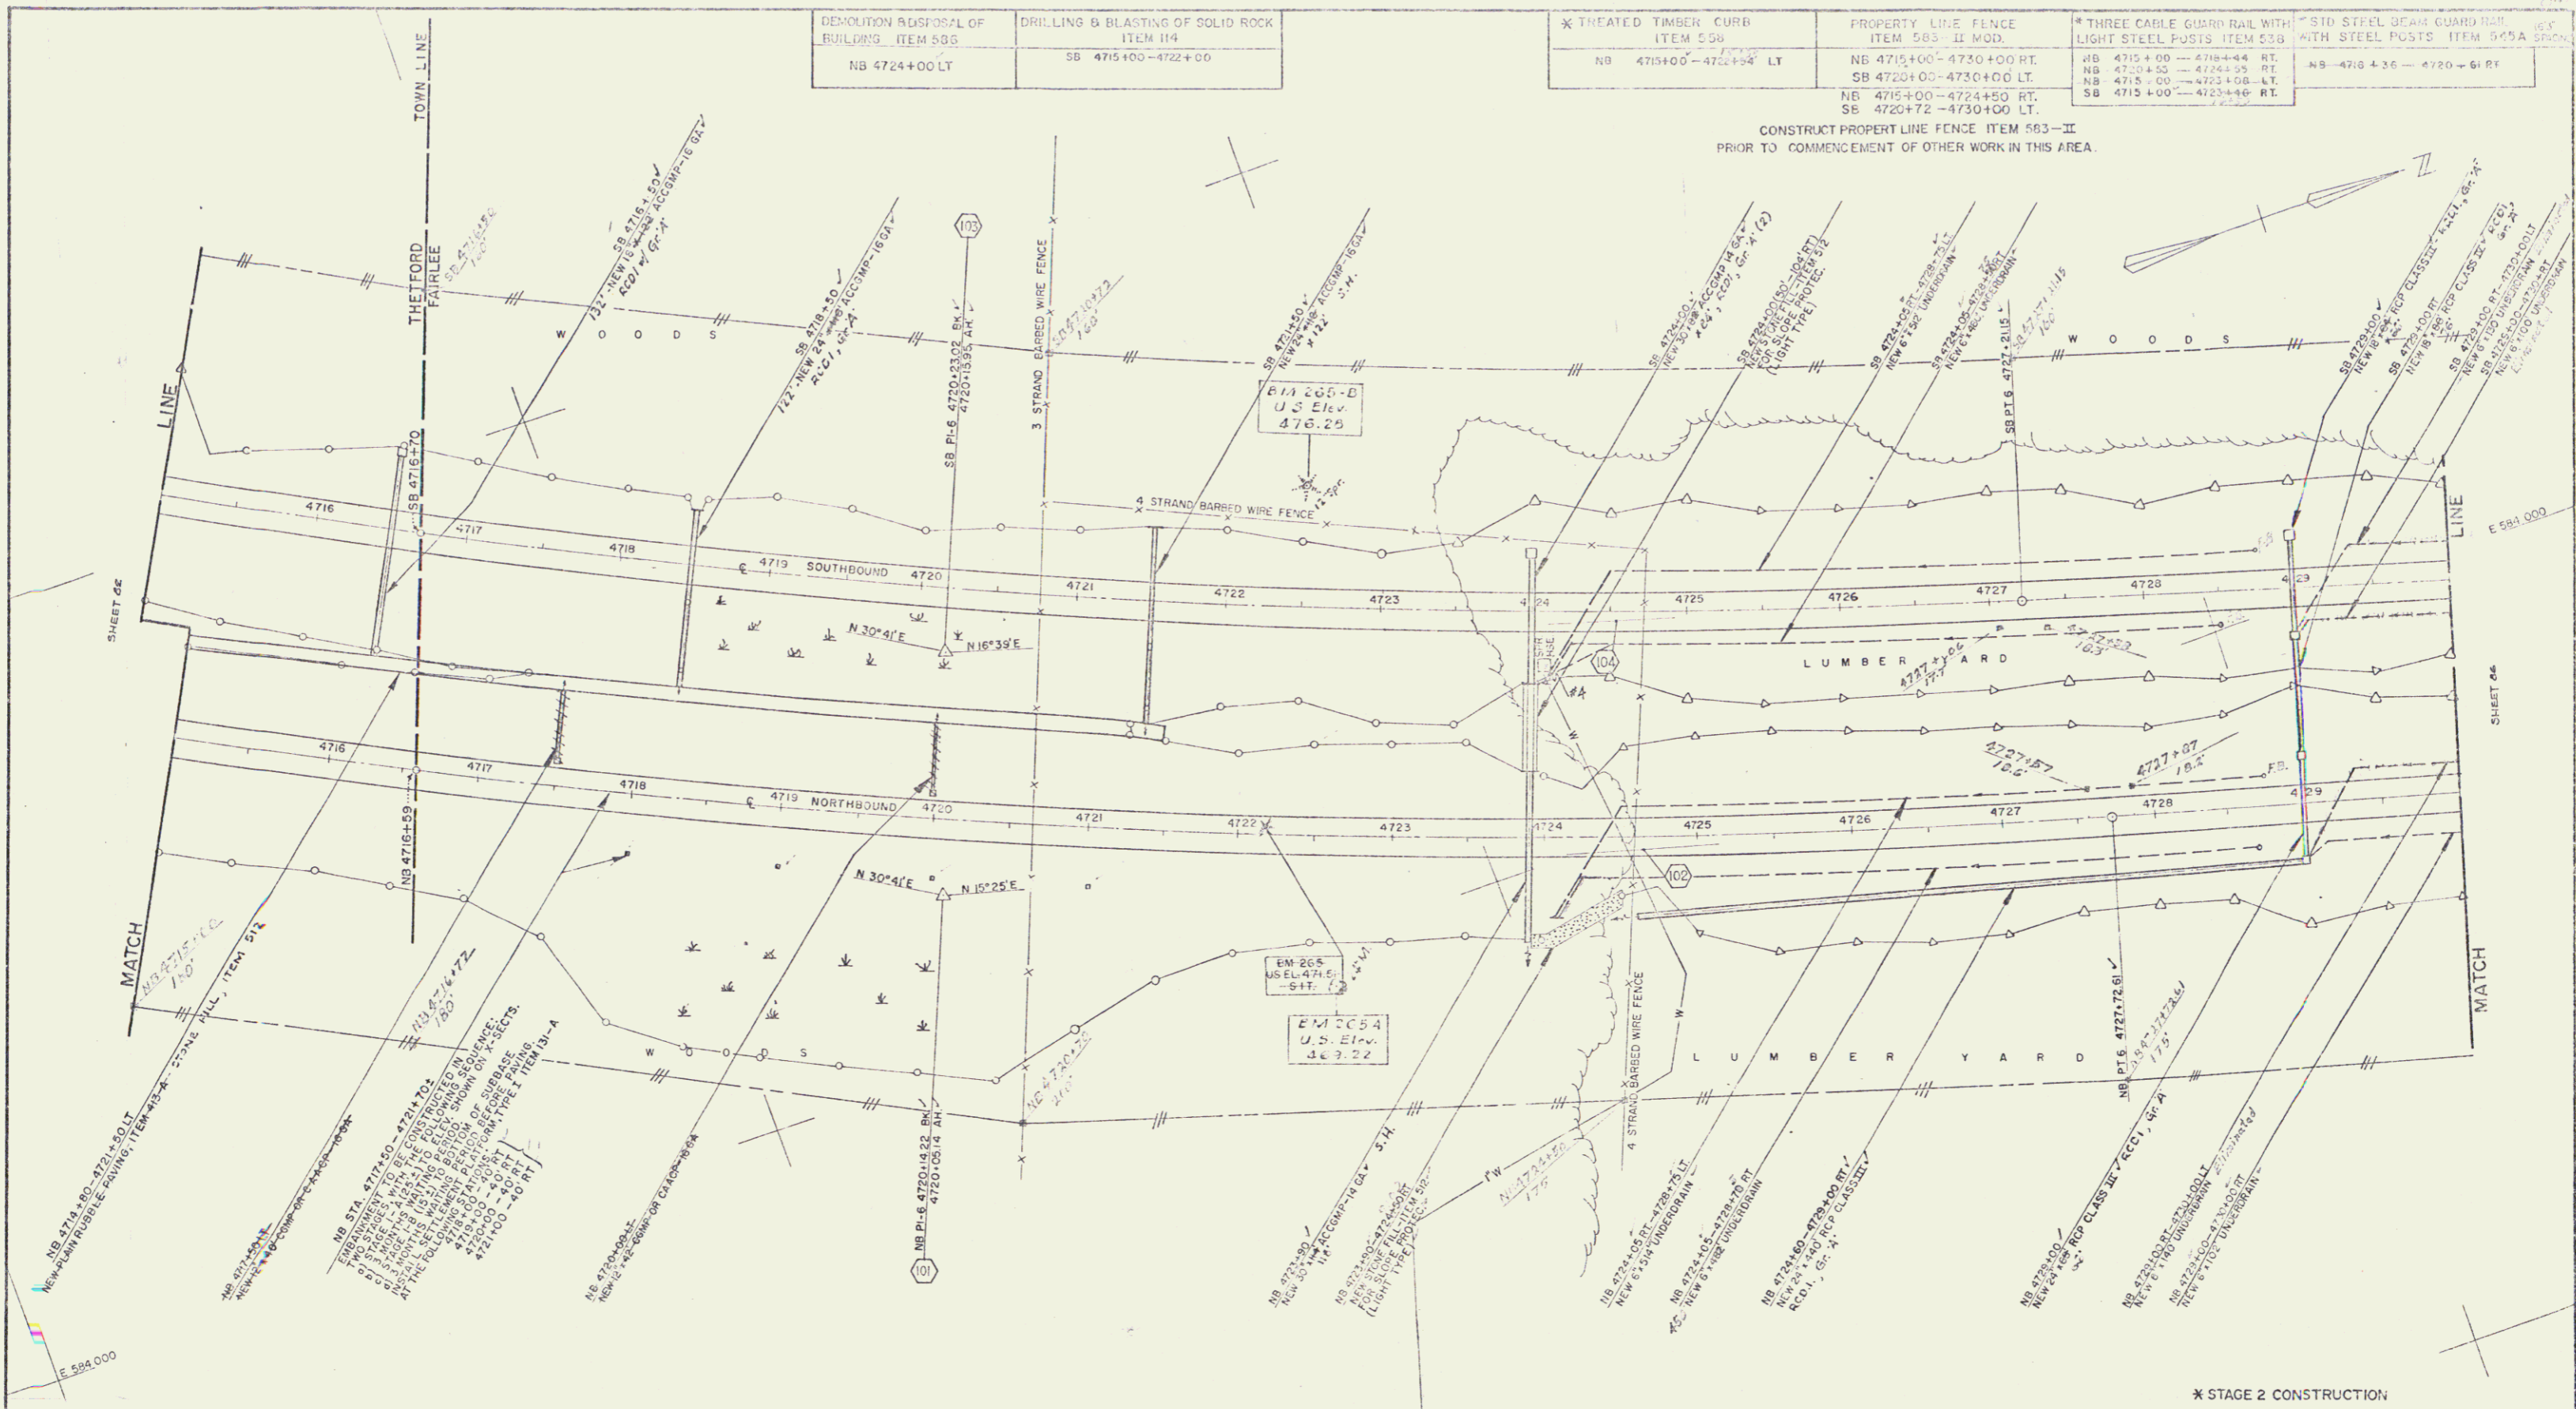

NB TIES		SB TIES		CURVE DATA	
RE-6" BIRCH	RE-FN POST	RE-9" HEM	FN POST	NB P1-6	SB P1-6
RE-6" BIRCH	RE-FN POST	RE-6" HEM	FN POST	N 501.65+61	N 501.70+46
RE-6" HEM	RE-FN POST	RE-6" HEM	FN POST	E 583.988+92	E 583.725+51
EL 6	P.O.T	EL 6	P.O.T	0+1100	0+1100
				Δ = 15°15'11"	Δ = 16°02'
				R = 5729.58'	R = 5728.58'
				T = 167.47'	T = 705.90'
				L = 152.506'	L = 1491.33'
				E = 5117'	E = 4323'
				BANK 5/16" PER FT.	BANK 5/16" PER FT.

* STAGE 2 CONSTRUCTION

CONTROL OF ACCESS IS COMPLETE ON THIS SHEET

PLAN SCALE
0 50 100
100 FEET

THETFORD - FAIRLEE
CONTRACT STAGE 2 CONSTRUCTION
STA. 4715+00 TO STA. 4730+00

PROJECT 1 91-2 (9) SHEET 245 OF 245 (24) 59 of 100