

PROPERTY LINE FENCE ITEM 593-1E M.O.D.
SB 4730+00-4736+00 LT
NB 4730+00-4736+75 RT
NB 4730+13-4736+00 RT
SB 4730+48-4736+00 LT

BRIDGE RAILING (FOR BRIDGE APPROACHES) ITEM 572
NB 4735+38-4735+65 RT
NB 4735+25-4735+52 RT
NB 4735+73-4735+98 LT
NB 4735+57-4735+82 RT
SB 4735+30-4735+55 RT
SB 4735+37-4735+62 RT
SB 4735+62-4735+87 LT
SB 4735+68-4735+93 LT

¾ JUTE MATTING ITEM 623
NB 4733+00-4736+25 LT (M20)
NB 4734+75-4735+50 LT (M20)



STANDARD STEEL BEAM CHANNEL WITH STEEL POSTS ITEM 625A'S M.O.D.
NB 4735+58 RT - TO 4735+85 LT
SB 4735+59 RT - TO 4735+86 LT
NB 4735+85 RT - TO 4735+112 LT
NB 4735+85 RT - TO 4735+112 LT
TREATED TIMBER CURB ITEM 628
NB 4735+65-4735+80 RT

STONE FILL FOR SLOPE PROTECT. (HEAVY TYPE) ITEM 58
NB 4735+40 RT - TO 4735+60 RT
(W/ VELOCITY RETARDER)

RIPRAP - ITEM 58-A (HEAVY TYPE)
NB 4735+40 RT - TO 4735+60 RT


SB 4730+00-4736+00 LT
CONSTRUCT PROPERTY LINE FENCE ITEM 593-1E M.O.D.
PRIOR TO COMMENCEMENT OF OTHER WORK IN THIS AREA.

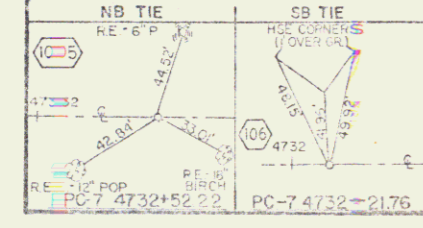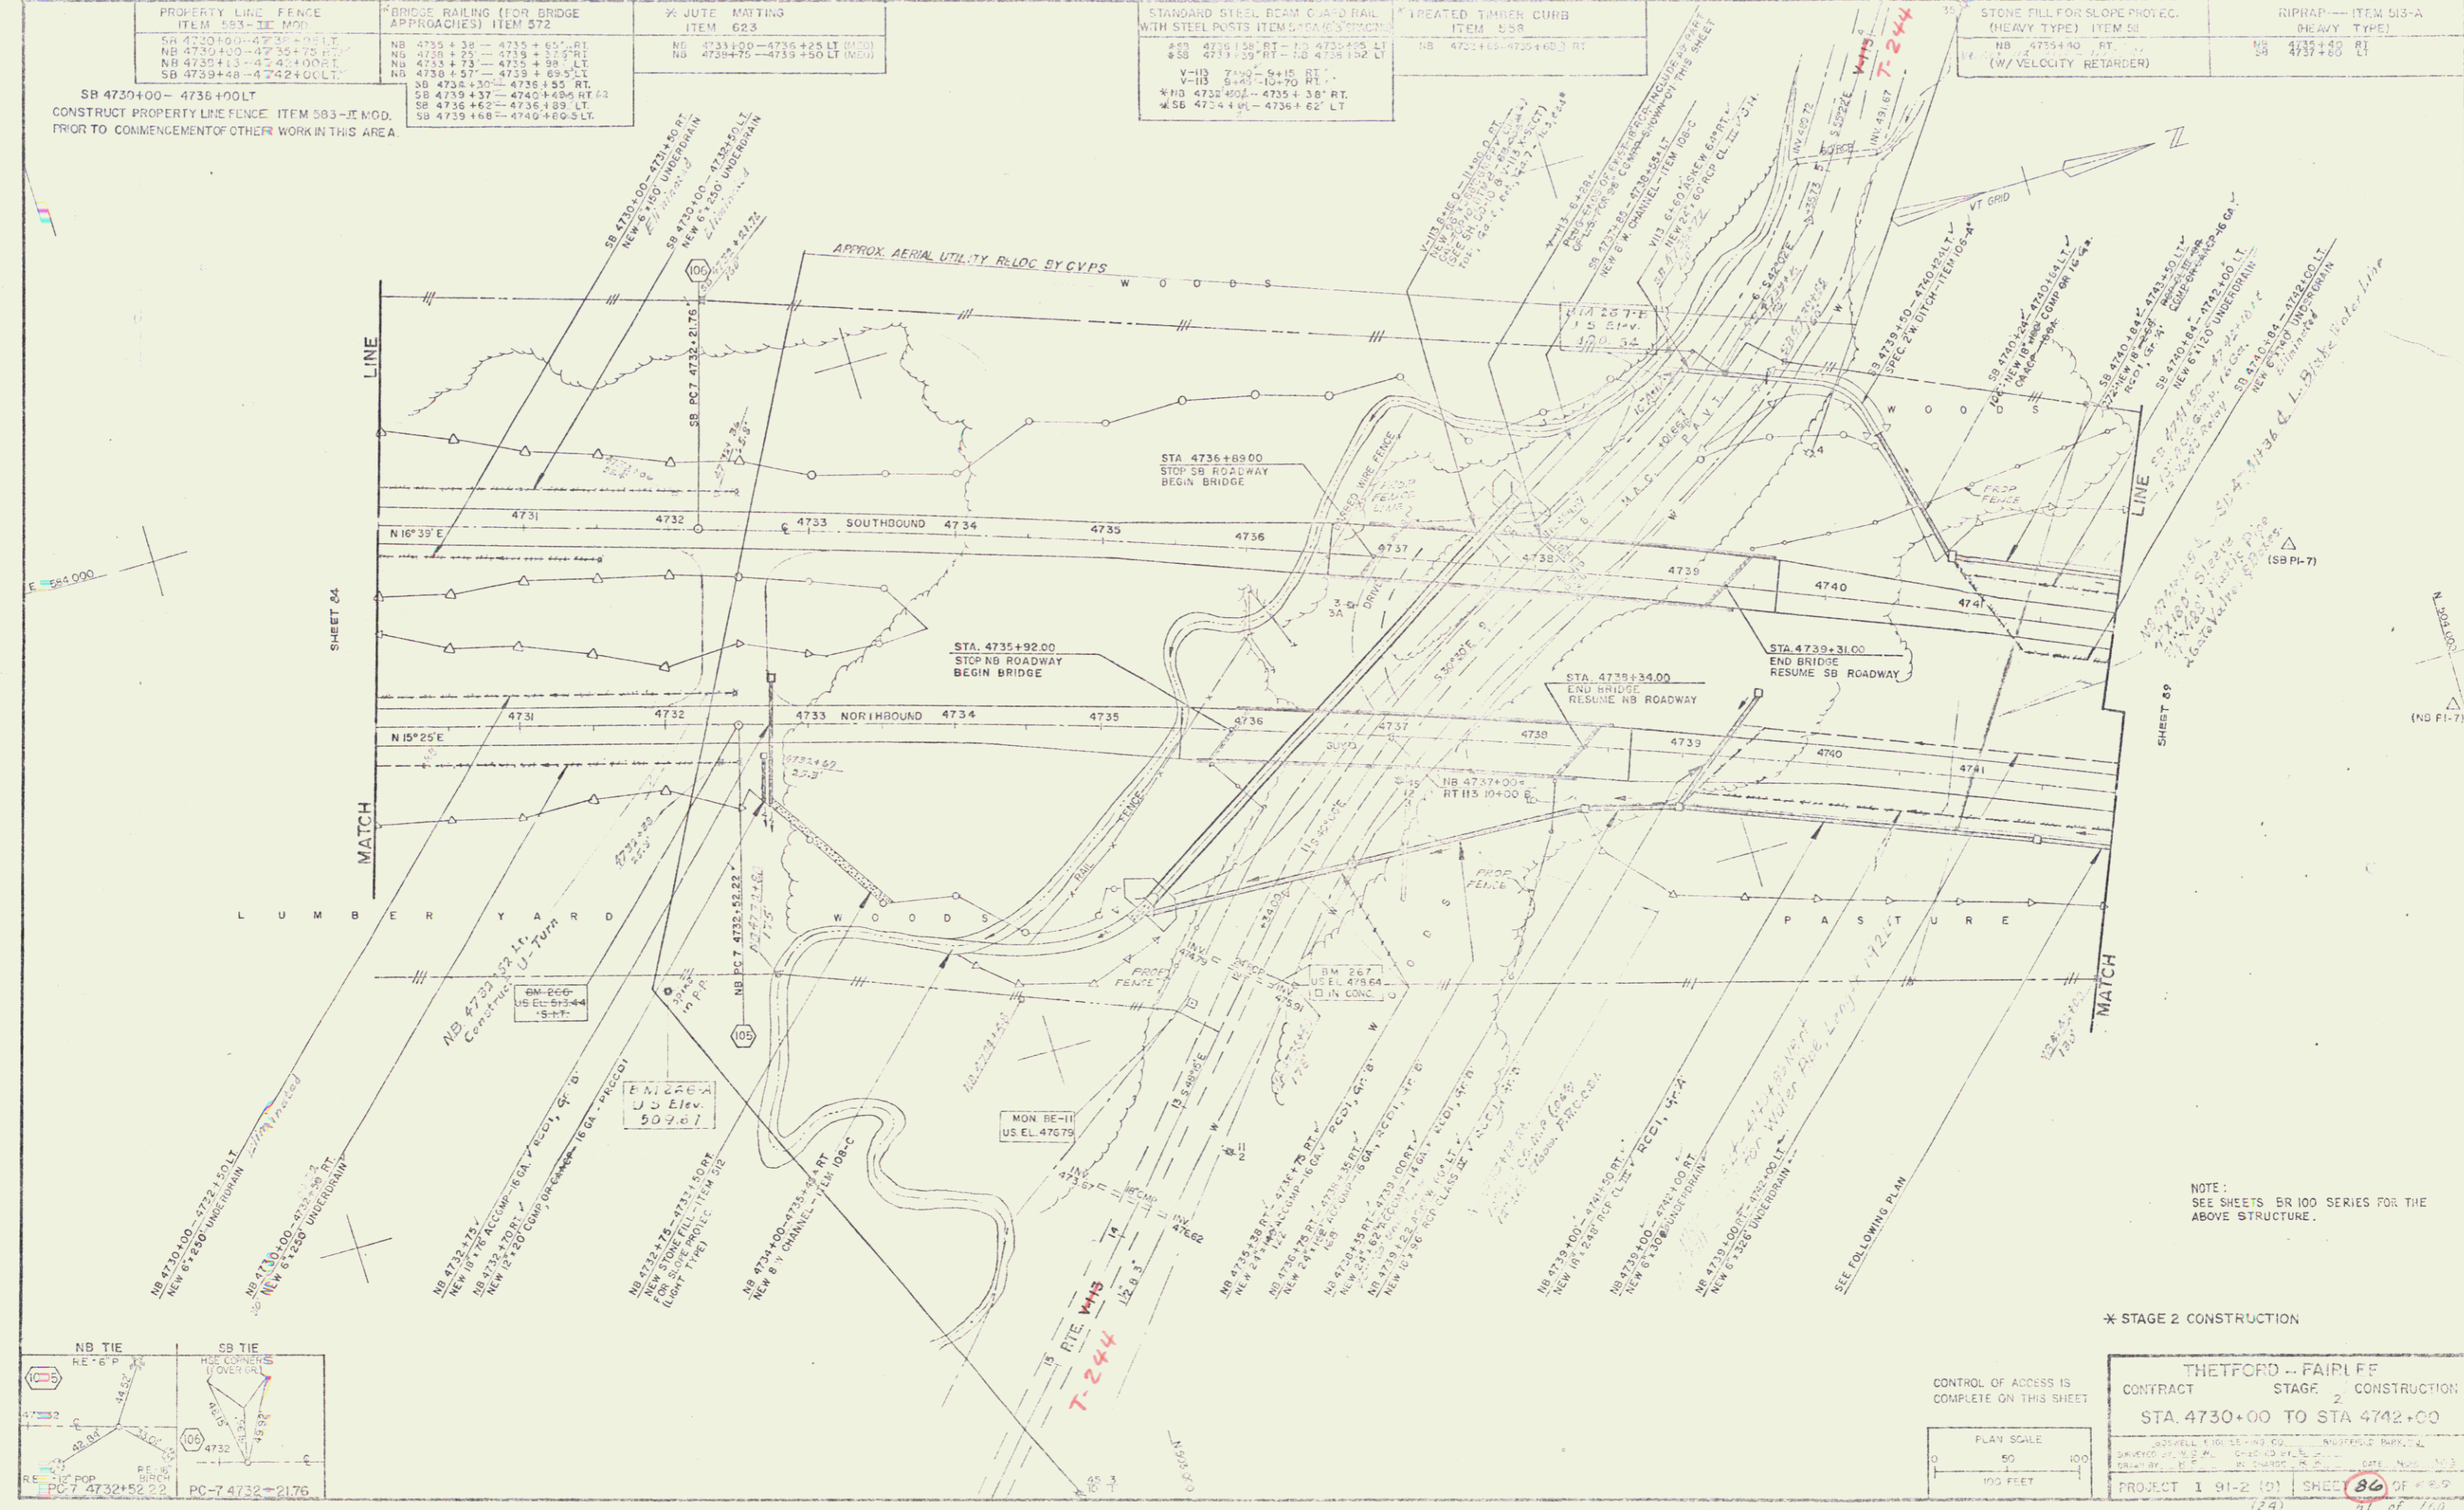

NOTE:
SEE SHEETS BR 100 SERIES FOR THE
ABOVE STRUCTURE.

* STAGE 2 CONSTRUCTION

CONTROL OF ACCESS IS
COMPLETE ON THIS SHEET

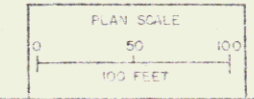

THETFORD - FAIRLEE	
CONTRACT	STAGE 2 CONSTRUCTION
STA. 4730+00 TO STA 4742+00	
DESIGNED BY	DATE
CHECKED BY	DATE
PROJECT 1 91-2 (D)	SHEET 86 OF 89
(24)	87 OF 100