
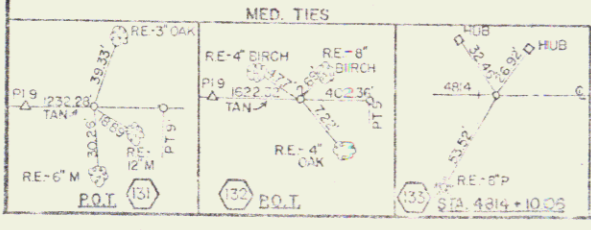


* JUTE MATTING ITEM 223 STA 4800+00 - 4803+50 (INF) STA 4804+00 - 4810+25 (MED) STA 4812+00 - 4814+00 (MED)	DRILLING & BLASTING OF SOLID ROCK SUBGRADE ITEM 115 STA 4806+00 - 4813+50	ADDITIONAL 12" SUBBASE OF SAND ITEM 202 STA 4803+00 - 4805+50 (SB) STA 4804+00 - 4807+00 (WB)	* STD STEEL BEAM GUARD RAIL WITH STEEL POSTS ITEM 545A NB 4807+60 - 4809+10 RT SB 4814+00 - 4815+00 FT SB 4803+30 - 4806+30 LT	* TREATED TIMBER CURB ITEM 55 STA 4814+50 - 4815+00 NB RT	STONE FILL FOR SLOPE PROTECT (HEAVY TYPE)-ITEM 211 STA 4809+70 RT (W/VELOCITY RETARDER)	BRNAP ITEM 513-A (HEAVY TYPE) STA 4803+70 LL
---	--	--	---	---	--	--

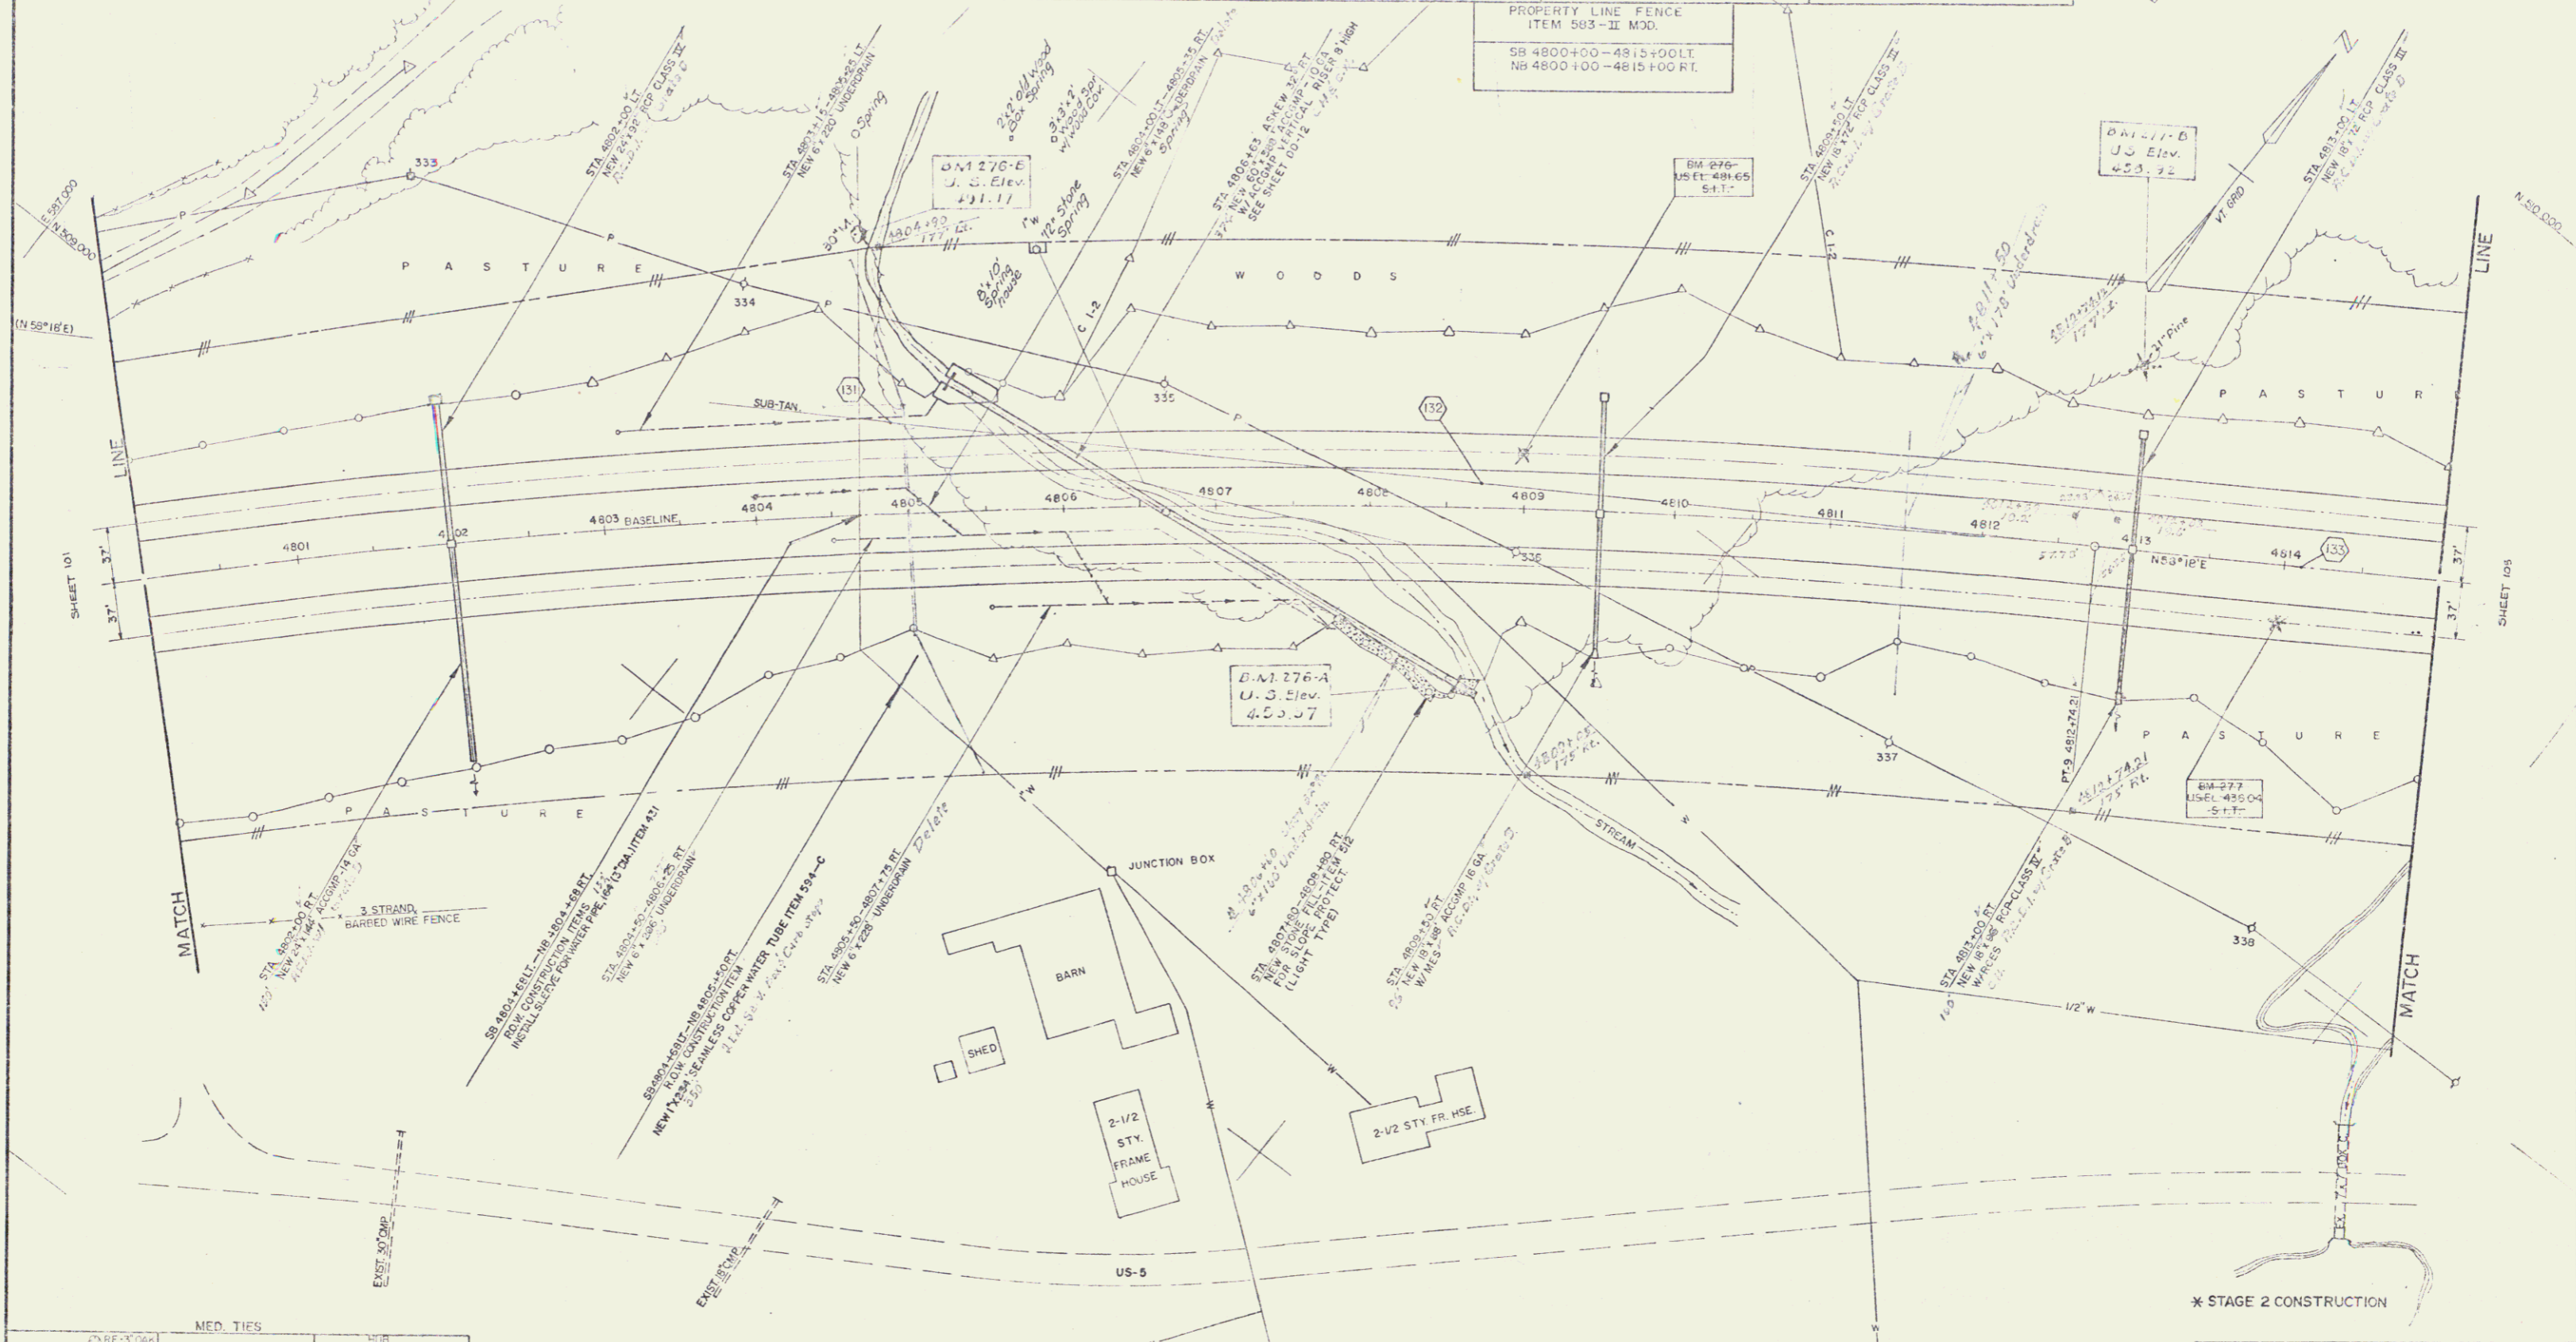

CONTROL OF ACCESS IS COMPLETE ON THIS SHEET

PLAN SCALE
0 50 100
100 FEET

THETFORD - FAIRLEE
CONTRACT STAGE 2 CONSTRUCTION
STA 4800+00 TO STA 4815+00

PROJECT 1 91-2 (3) SHEET 103 OF 100
(24) 72 of 100