
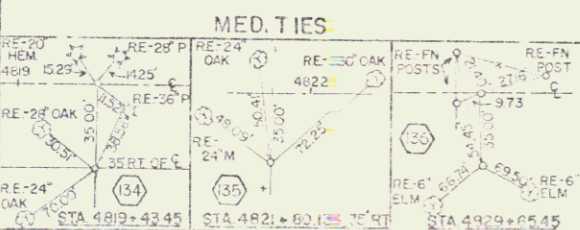


STONE FILL FOR SLOPE PROT. (HEAVY TYPE) ITEM 511 STA. 4818+00 RT.	¾" JUTE MATTING ITEM 623 STA. 4815+00-4819+40 (MED)	MUCK EXCAVATION-ITEM 117 STA. 4815+25-4822+10	THREE CABLE GUARD RAIL WITH LIGHT STEEL POSTS ITEM 539 SB 4816+50-4822+42- LT	TREATED TIMBER CURB ITEM 558 STA. 4815+00-4819+14 No. RT STA. 4817+00-4822+12- No. LT	RIKRAF-ITEM 612-A (HEAVY TYPE) STA. 4819+10 RT STA. 4814+40 LT
* STEEL BEAM GUARD RAIL ITEM 545-A NB 4815+00-4819+30 RT. SB 4818+37-4814+32 Lt.	PROPERTY LINE FENCE ITEM 583-II MOD. SB 4815+00-4830+00 LT NB 4815+00-4819+30 RT.	Chain Link Fence NB. 4825+00 ~ 4830+00 Rt.			

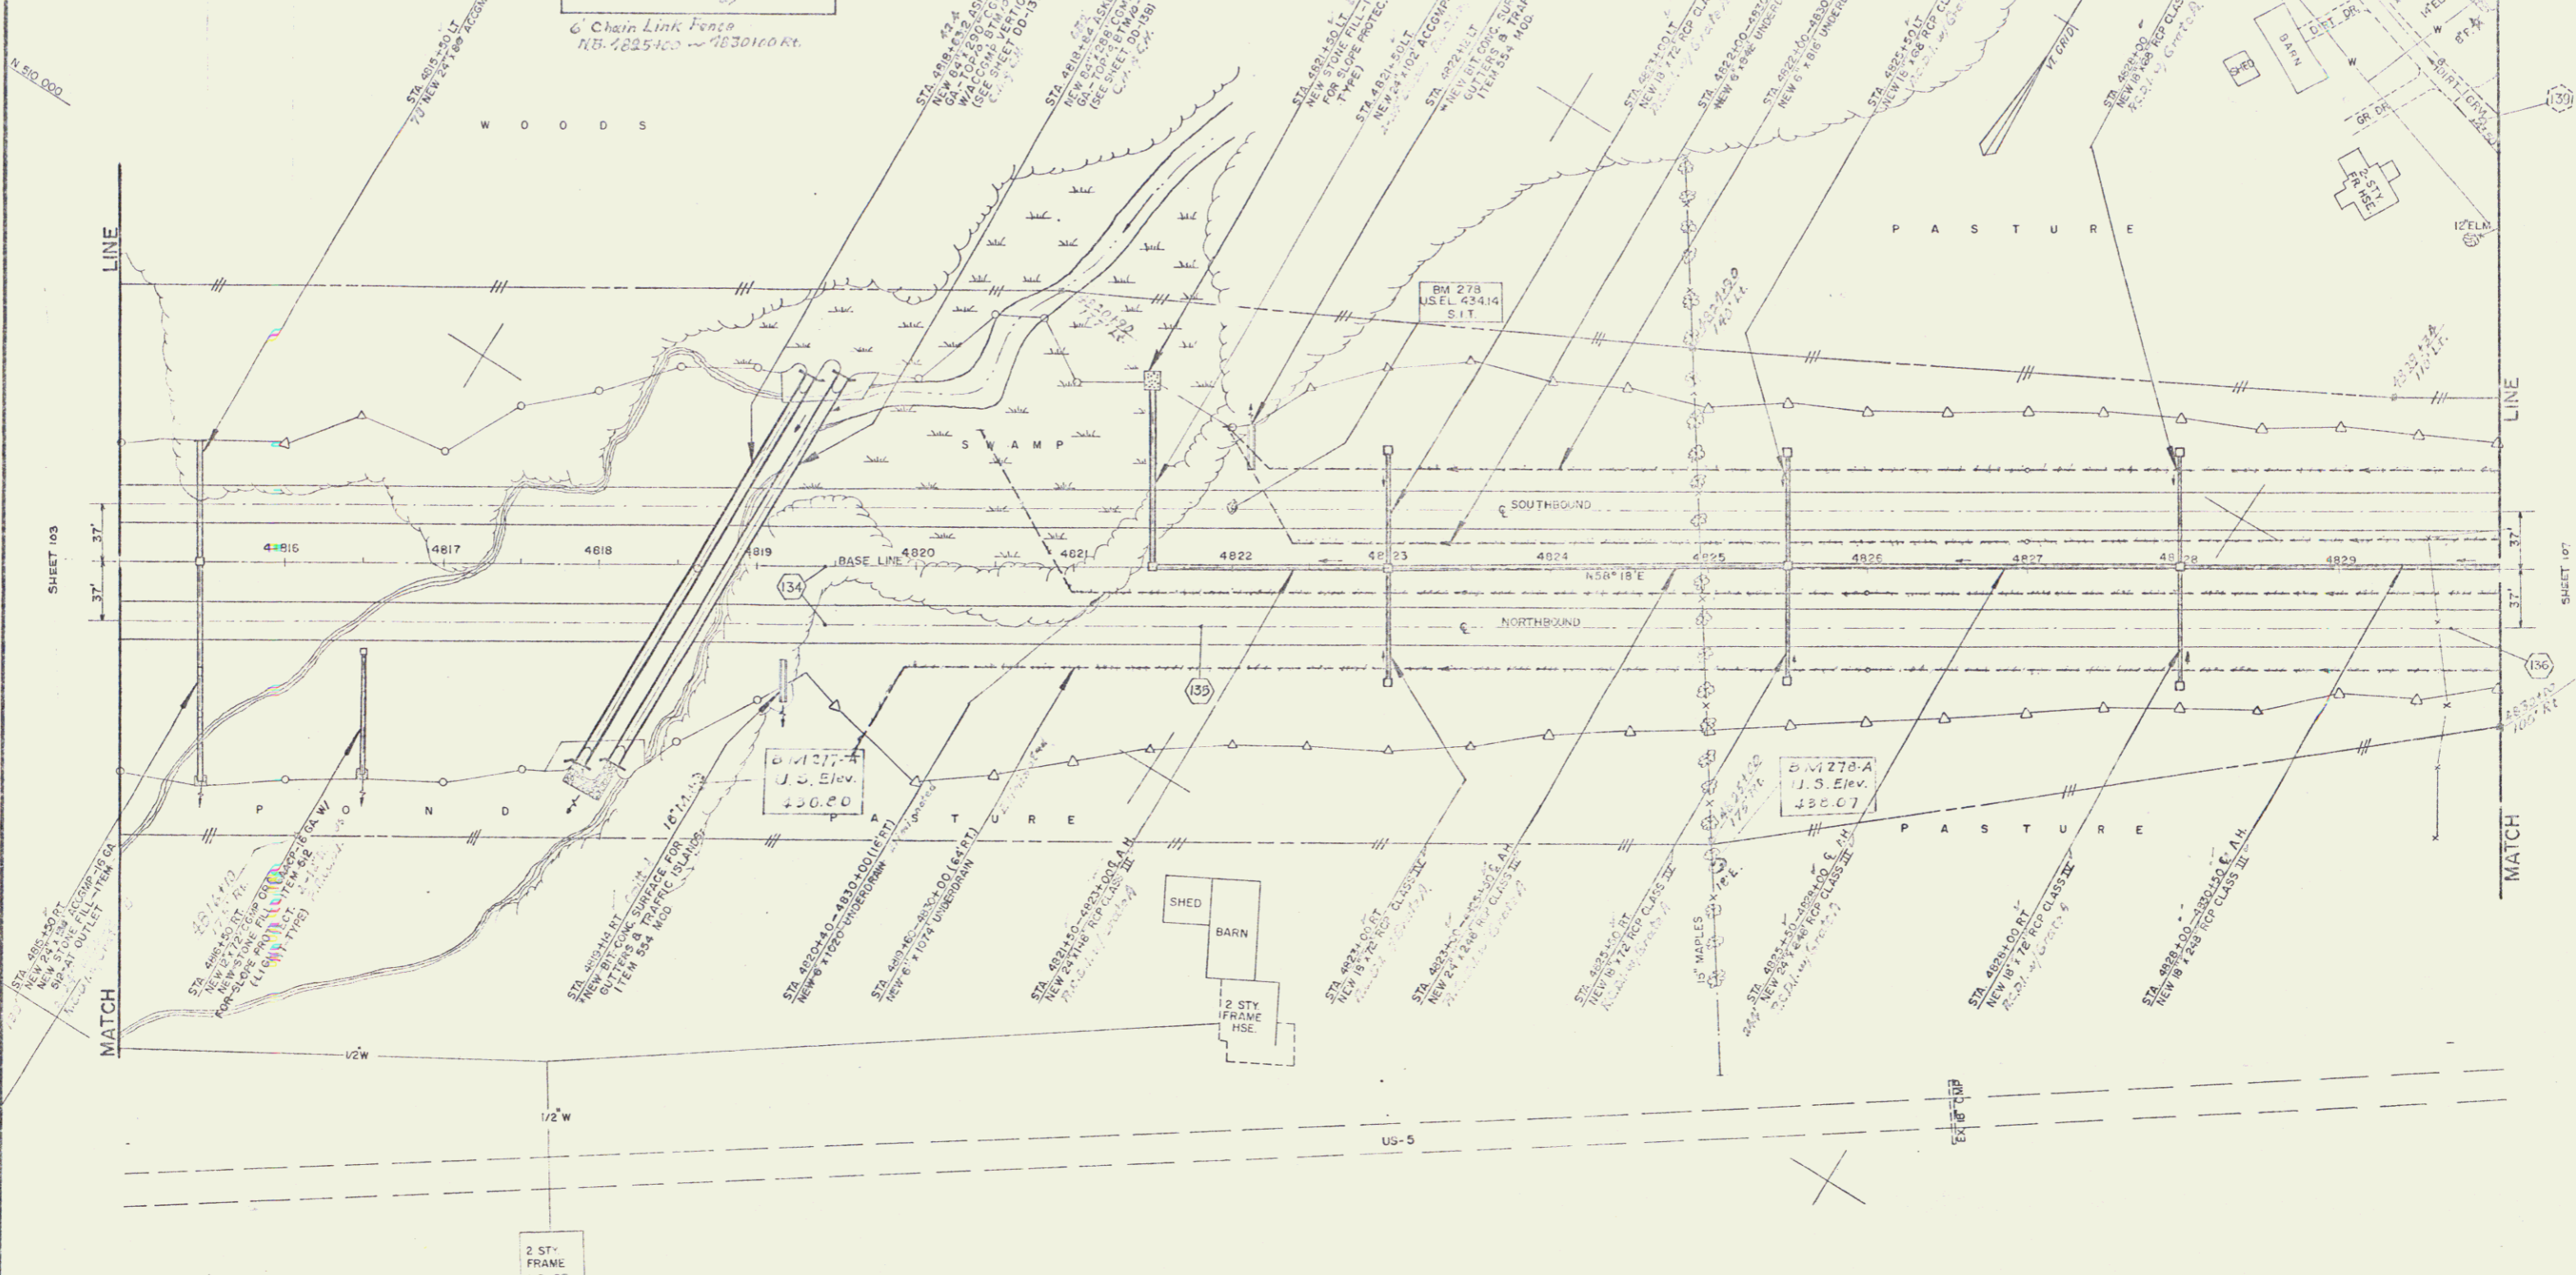

* STAGE 2 CONSTRUCTION

THETFORD-FAIRLEE
CONTRACT STAGE 2 CONSTRUCTION
STA. 4815+00 TO STA. 4830+00

CONTROL OF ACCESS IS COMPLETE ON THIS SHEET

PLAN SCALE
0 50 100
100 FEET

PROJECT I 91-2 (9) SHEET 105 OF 150
(24)