
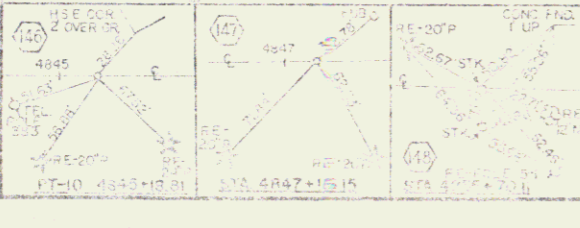


DEMOLITION & DISPOSAL OF BUILDING	ITEM 586	NON-TIMBER CONCRETE CURB	GRANITE SLICE EDGING	THREE CODED GUARD RAIL WITH LIGHT STEEL POSTS	EXCAVATION & REMOVAL OF ROAD SURFACE
RAMP A 215' RT RAMP A 440' RT RAMP A 710' RT RAMP A 810' RT RAMP A 810' LT RAMP A 940' LT RAMP A 940' LT	SAI 11+55 RT SAI 12+35 RT SAI 12+70 RT	STA 4111+31-4111+42.00 LT STA 4151+33-4151+43.00 RT	RAMP A 0+00 LT ISLAND RAMP D 0+00 RT ISLAND	NS 4851+00-4851+00 RT SB 4851+00-4851+00 LT SB 4851+00-4851+00 LT RAMP D 0+00 RT	EXCAVATION & REMOVAL OF ROAD SURFACE FOR PAVEMENTS ITEM 119 RAMP A 0+00-4851+00 RT




VERTICAL GRANITE CURB	BITUMINOUS CONCRETE SIDEWALK	STD STEEL BEAM GUARD RAIL WITH STEEL POSTS
ITEM 586-B SAI 11+35 RT SAI 11+35 RT SAI 11+35 RT SAI 11+35 RT SAI 11+35 RT SAI 11+35 RT	ITEM 582-1000 SAI 11+35-11+35 LT SAI 11+35-11+35 LT SAI 11+35-11+35 LT SAI 11+35-11+35 LT SAI 11+35-11+35 LT SAI 11+35-11+35 LT	NS 4851+00-4851+00 RT SB 4851+00-4851+00 LT SB 4851+00-4851+00 LT SB 4851+00-4851+00 LT SB 4851+00-4851+00 LT SB 4851+00-4851+00 LT

CONSTRUCT DRIVE	BRIDGE RAILING (FOR BRIDGE APPROACHES)	CONC. SURFACE FOR CUTTER B TRAFFIC ISLANDS	CH LINK FENCE
FRONTAGE ROAD 28+00 LT FRONTAGE ROAD 26+50 LT (ROW CONSTRUCTION ITEM)	ITEM 572 SB 4851+09.5-4851+21 LT SB 4851+21.5-4851+28 RT SB 4851+28.5-4851+37 LT NB 4851+16.5-4851+43 RT NB 4851+43-4851+53 LT NB 4851+53-4851+61.5 RT NB 4851+61.5-4851+64 LT SB 4851+79-4851+80 RT	ITEM 554 MOD RAMP A 0+00 LT RAMP D 0+00 RT	ITEM 573 SAI 11+35-11+35 LT SAI 11+35-11+35 LT SAI 11+35-11+35 LT SAI 11+35-11+35 LT SAI 11+35-11+35 LT SAI 11+35-11+35 LT

PROPERTY LINE FENCE	APPROX AERIAL UTILITY RELOC ROUTE BY ECVS
ITEM 122-1100 SB 4843+00-4843+88 RT -SAI 6+88 LT - SAI 8+00 LT	ITEM 119 RAMP A 0+00-4851+00 RT

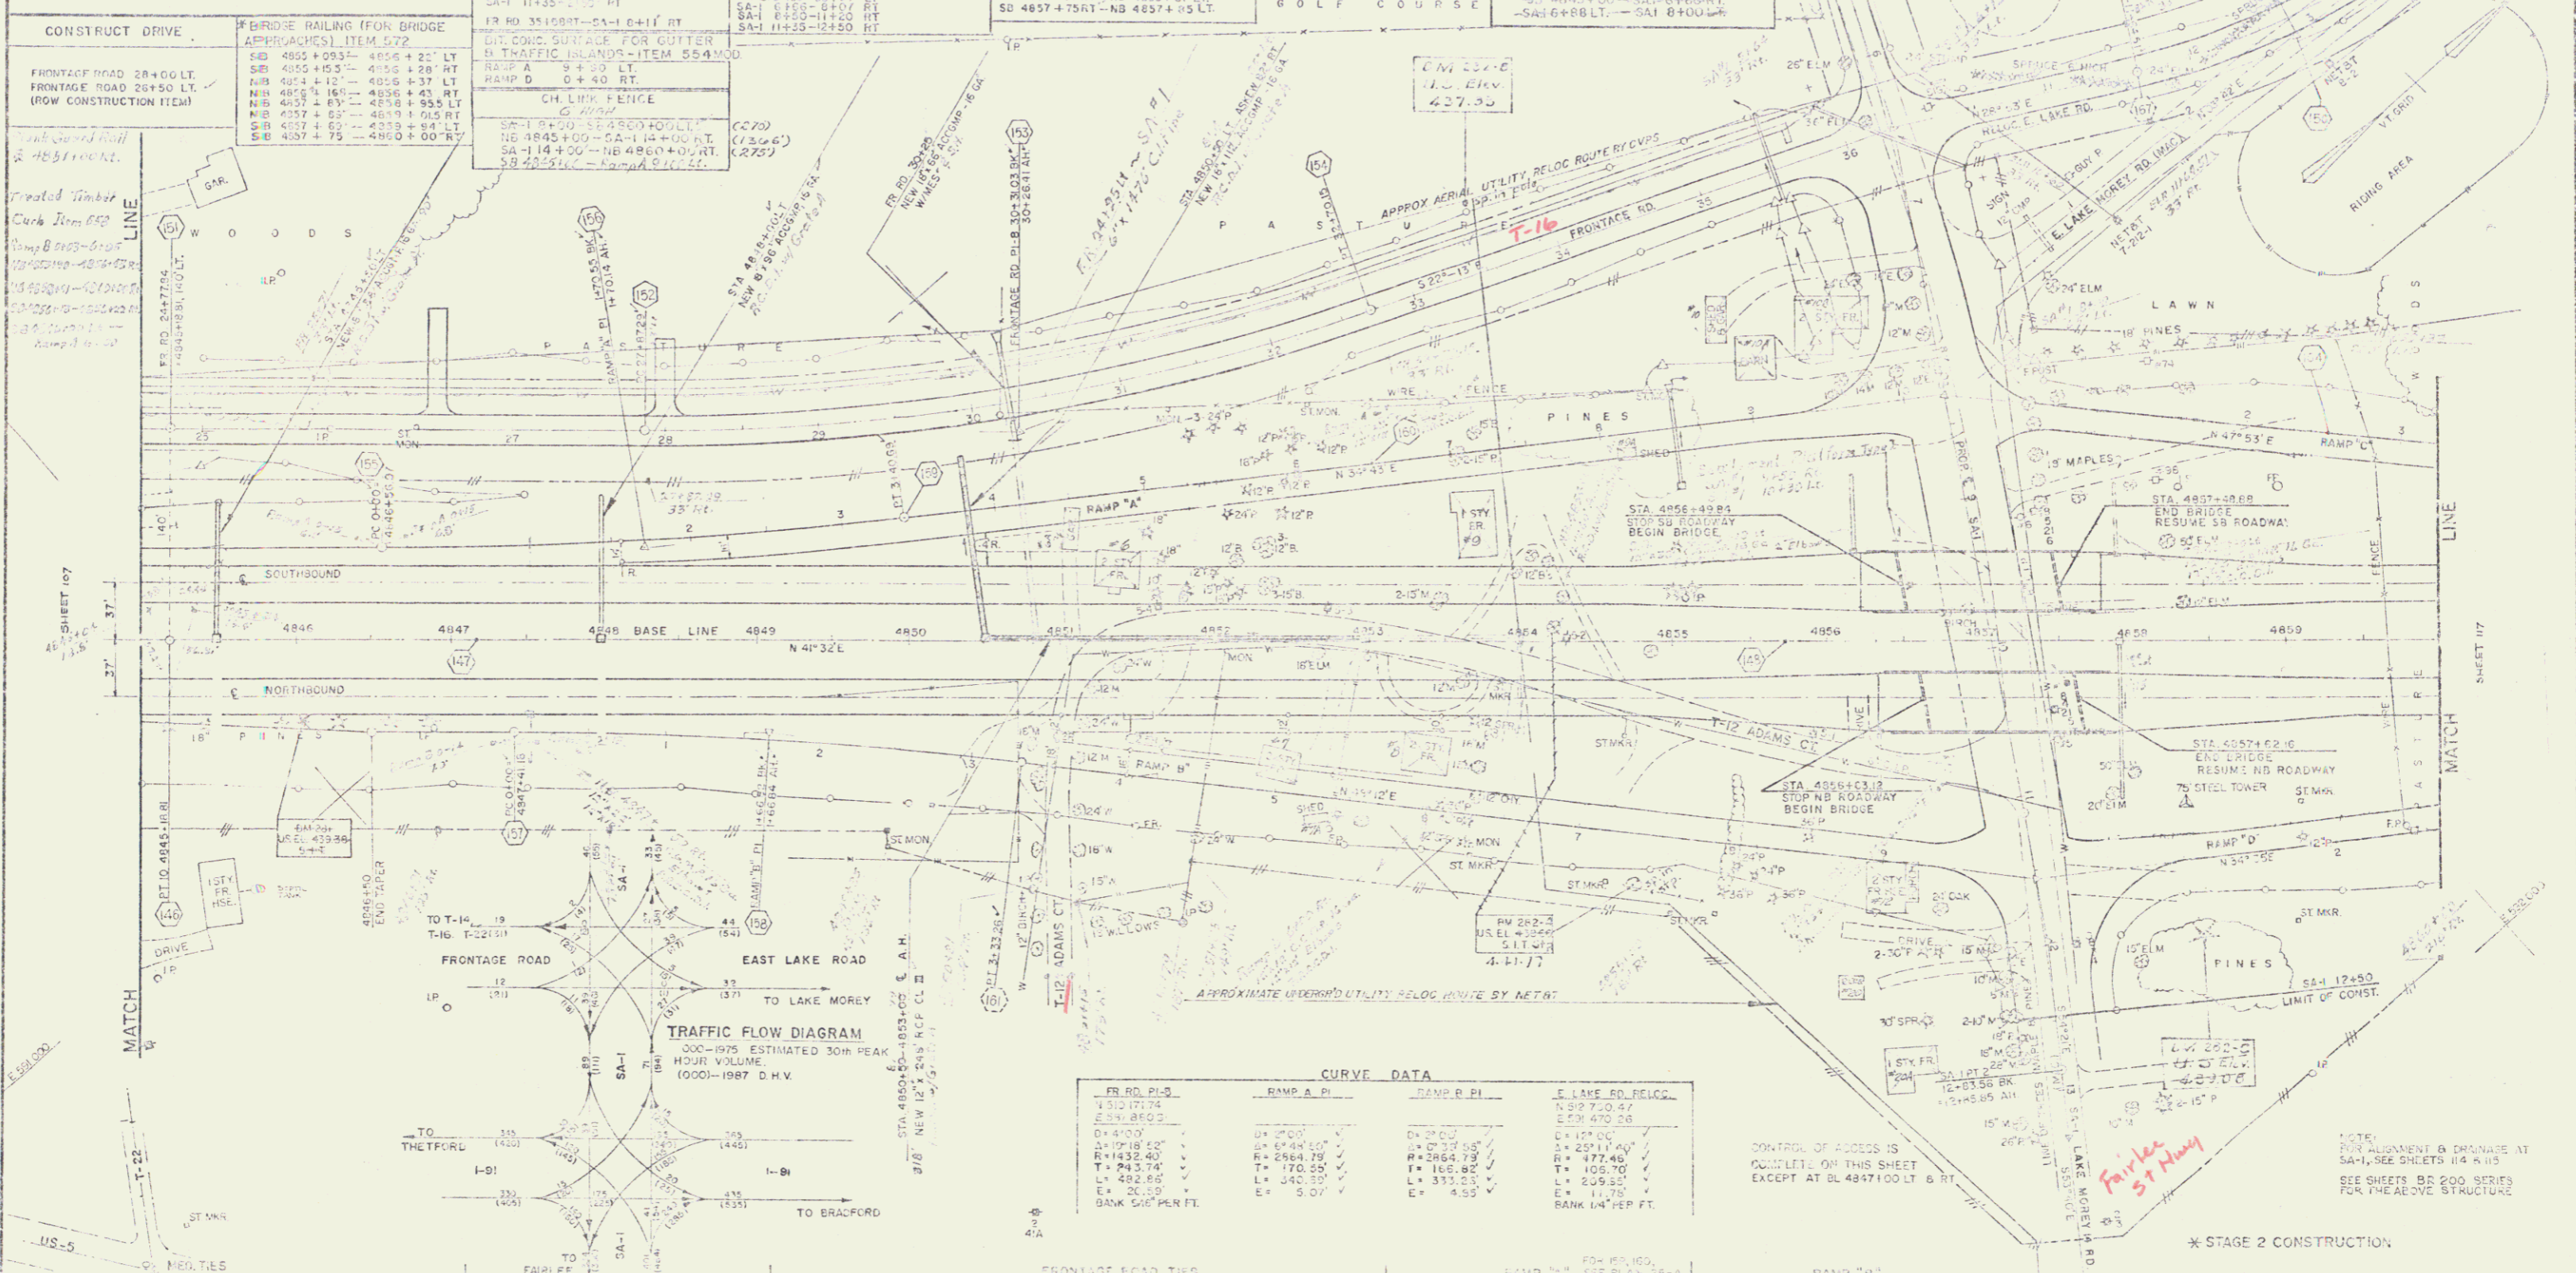

FR. RD. P.D.	RAMP A PI	RAMP B PI	E LAKE RD. RELOC.
1310.7174	1310.7174	1310.7174	1310.7174
254.8900	254.8900	254.8900	254.8900
1018.52	1018.52	1018.52	1018.52
1432.40	1432.40	1432.40	1432.40
74.74	74.74	74.74	74.74
482.80	482.80	482.80	482.80
20.50	20.50	20.50	20.50
BANK CUT PER FT.	E = 5.07	E = 4.55	BANK IN PER FT.

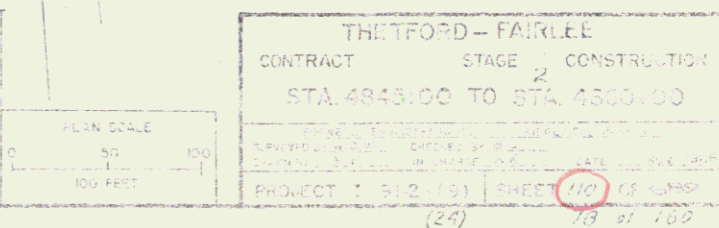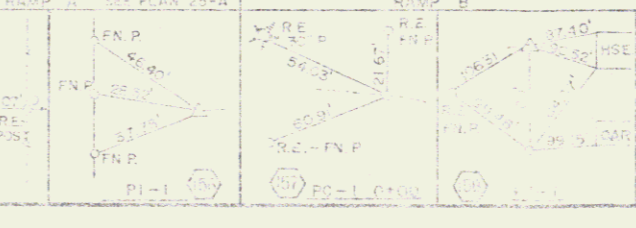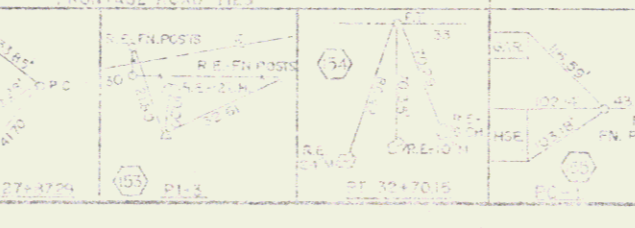

THETFORD - FAIRLEE  
CONTRACT STAGE 2 CONSTRUCTION  
STA 4843+00 TO STA 4850+00  
PROJECT 1-512-1131 SHEET 112 OF 118  
(24) 11/17/80