


DEMOLITION & DISPOSAL OF BUILDING ITEM 586	DRILLING & BLASTING OF SOLID ROCK SUBGRADE ITEM 115	THREE CYCLE GUARD RAIL WITH LIGHT STEEL POSTS ITEM 478
4893+00-0 4893+00-LT 4893+30-RT 4894+00-LT 4894+30-RT 4895+00-0 4895+00-LT 4895+30-0 4895+30-LT 4896+00-RT	490+50-490+00	STA 4893+00-4907+00 SB RT STA 4893+30-4907+00 SB RT



w/ Gully Chain Link Fence
4897+50 ~ 4897+95 Ht.

PROPERTY LINE FENCE
ITEM 583 - II MOD
NB 4894+50-4907+00 RT
SB 4894+50-4897+00 LT

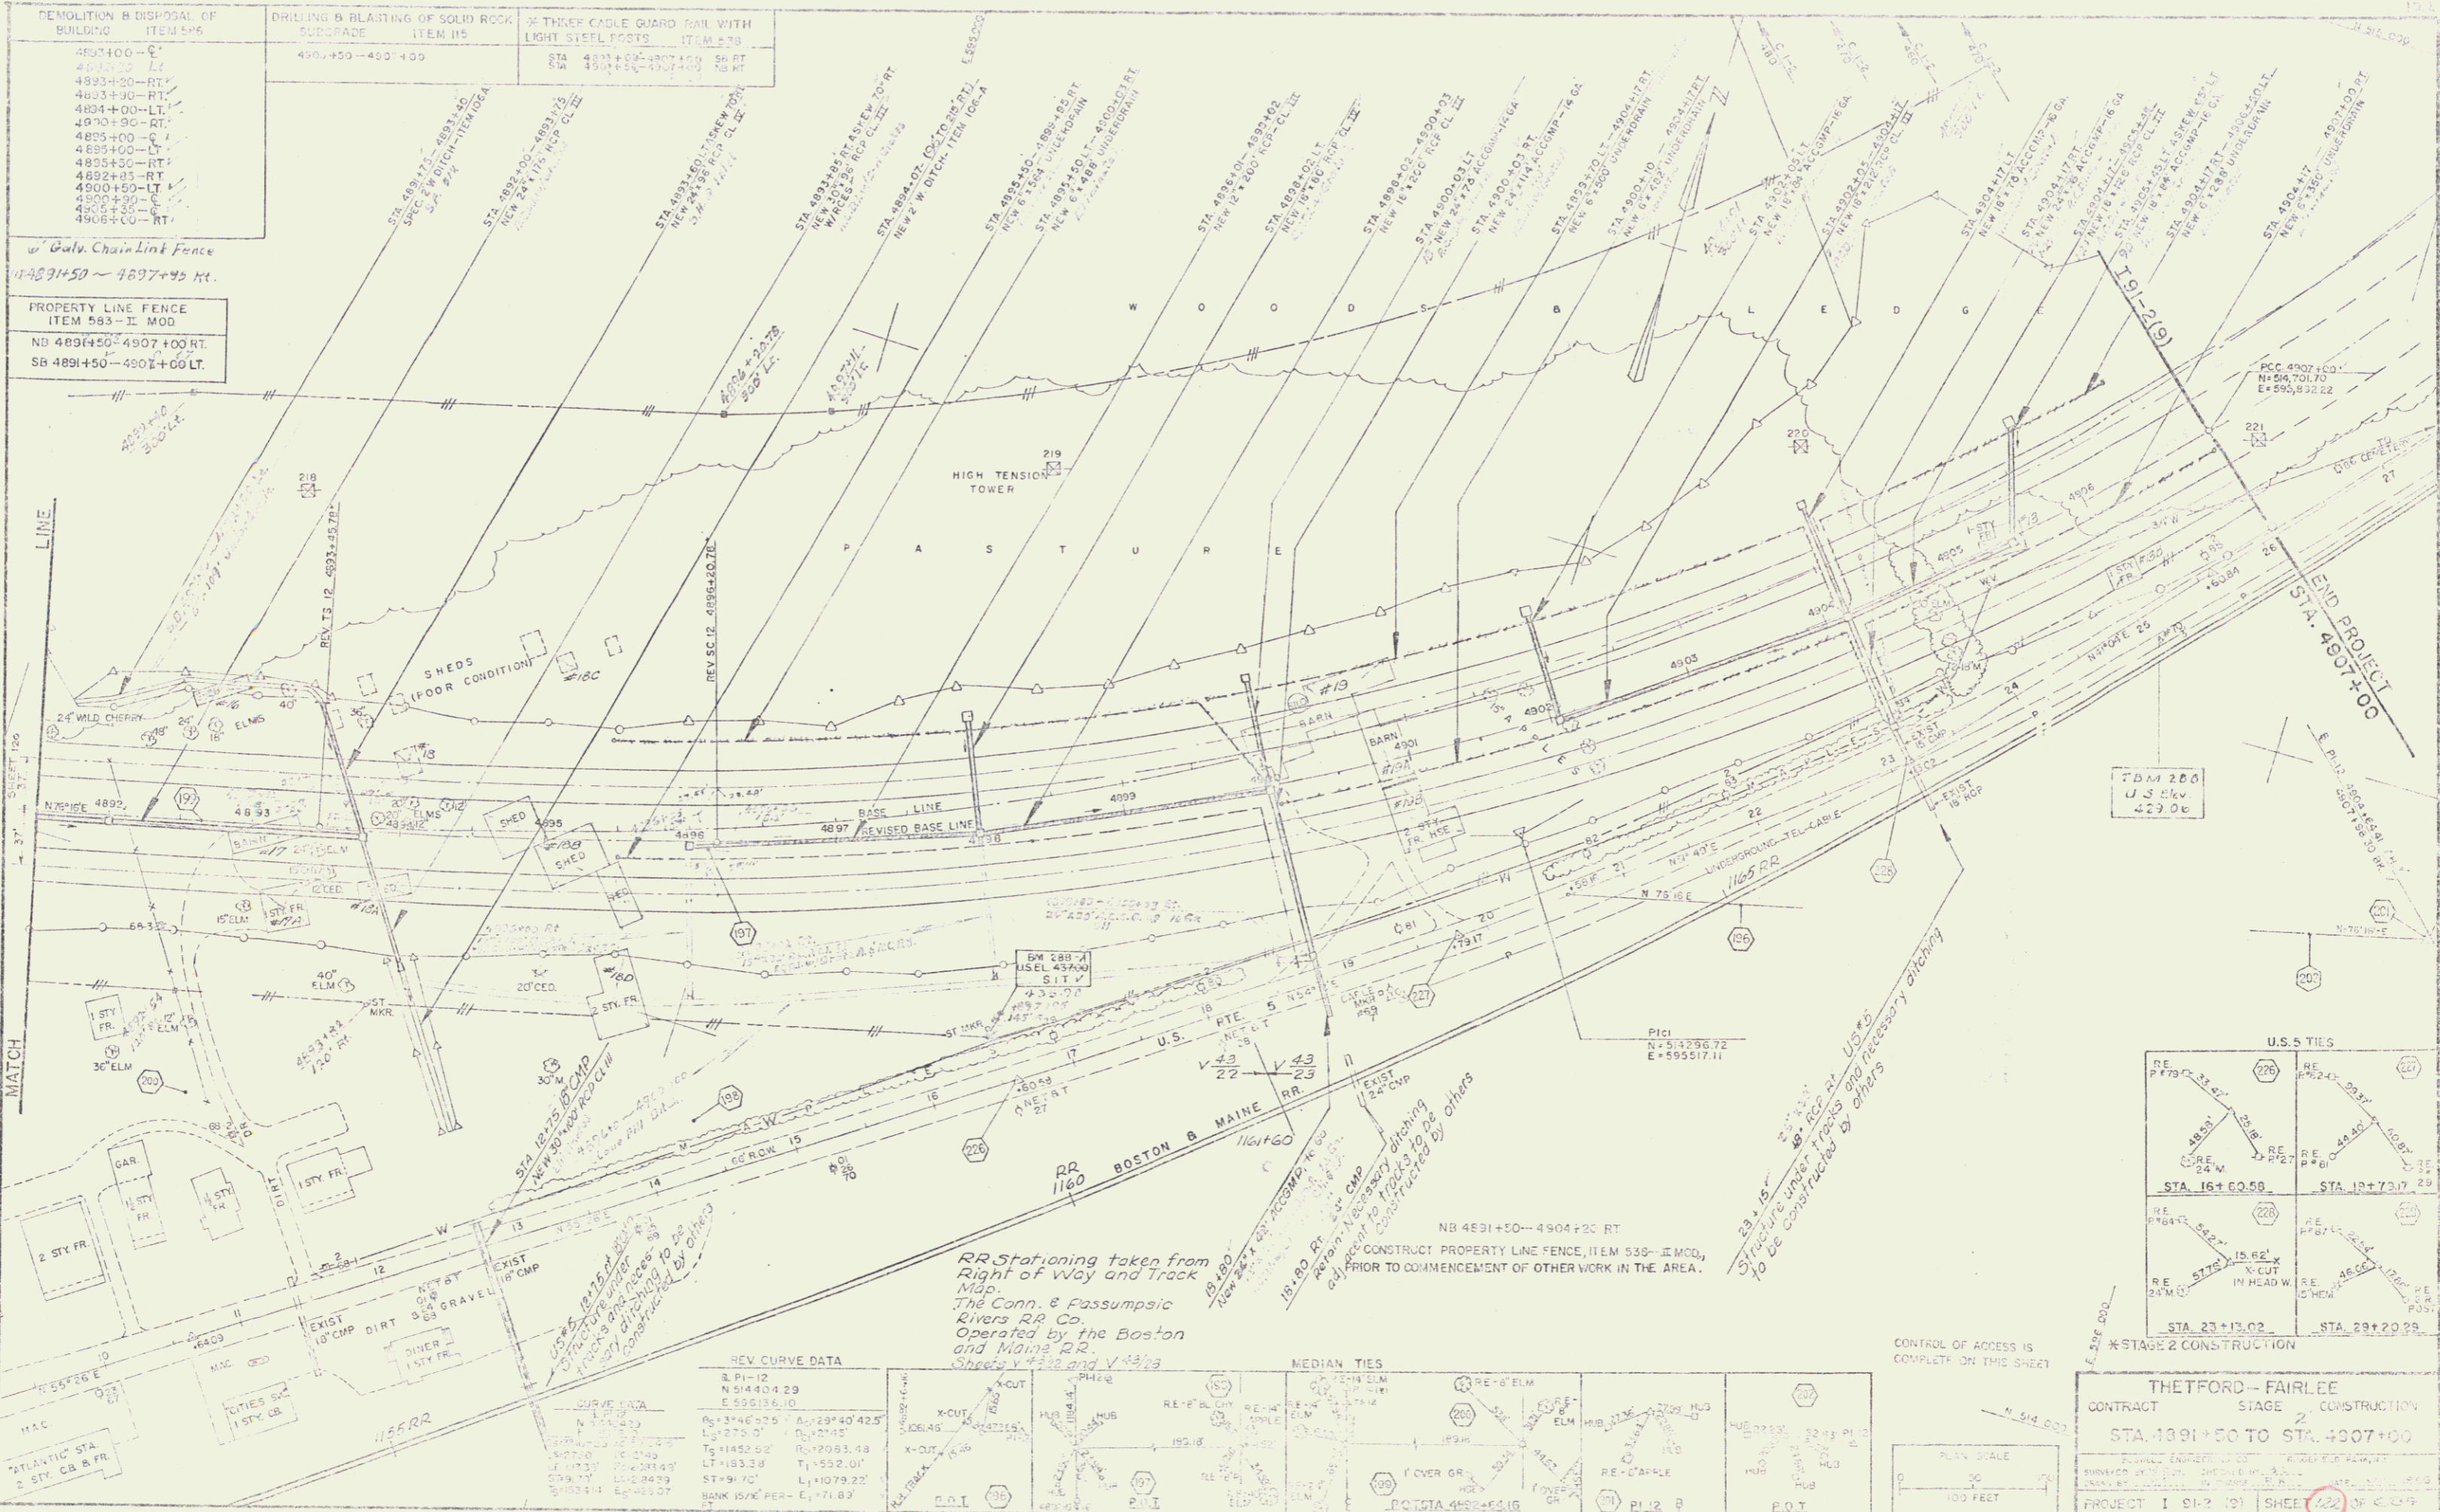

REV. CURVE DATA

3. PI=12 N 51440.29 E 596156.10	R=3746.25 L=772.07 T=1183.38 ST=91.70 BANK 15%/PER E=171.82	Δ=29°40'42.5" R=7083.08 T=552.01 L=11079.22
---------------------------------------	---	--

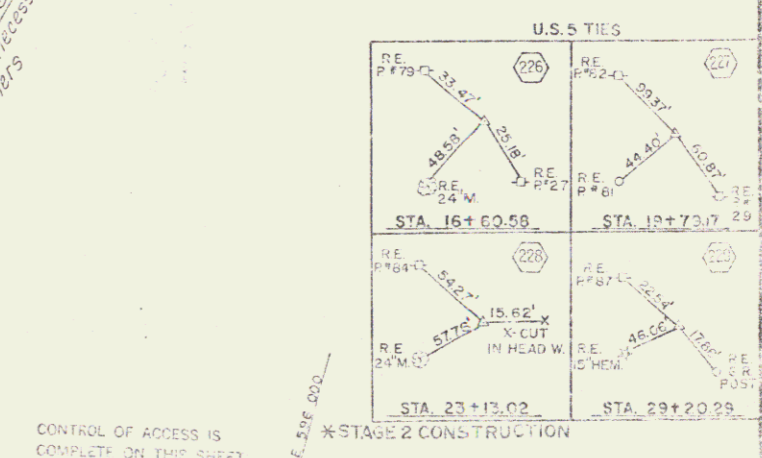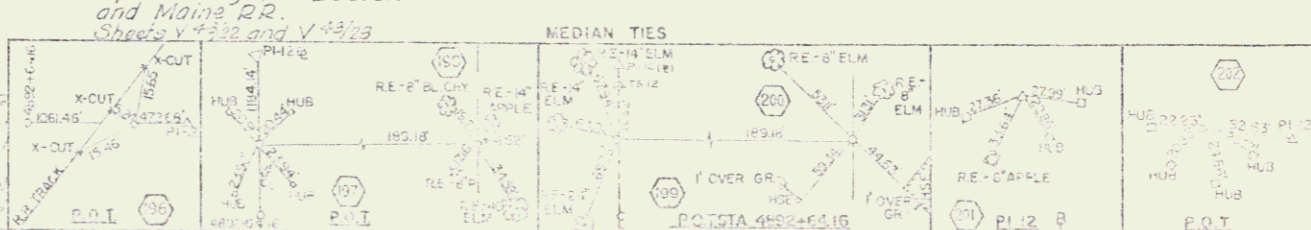

THETFORD - FAIRLEE
CONTRACT STAGE 2 CONSTRUCTION
STA. 4891+50 TO STA. 4907+00

PROJECT 1 91-2 (2) SHEET 122 OF 139
(24) 85 67 100