



TWO CABLE CABLE PER ITEM 581	100' OVER RAIL OF SOLE ROAD SUBGRADE ITEM 110	CONSTRUCT DRIVE
276+00 - 281+00	276+00 - 281+00	14' 2.4' PER LT.

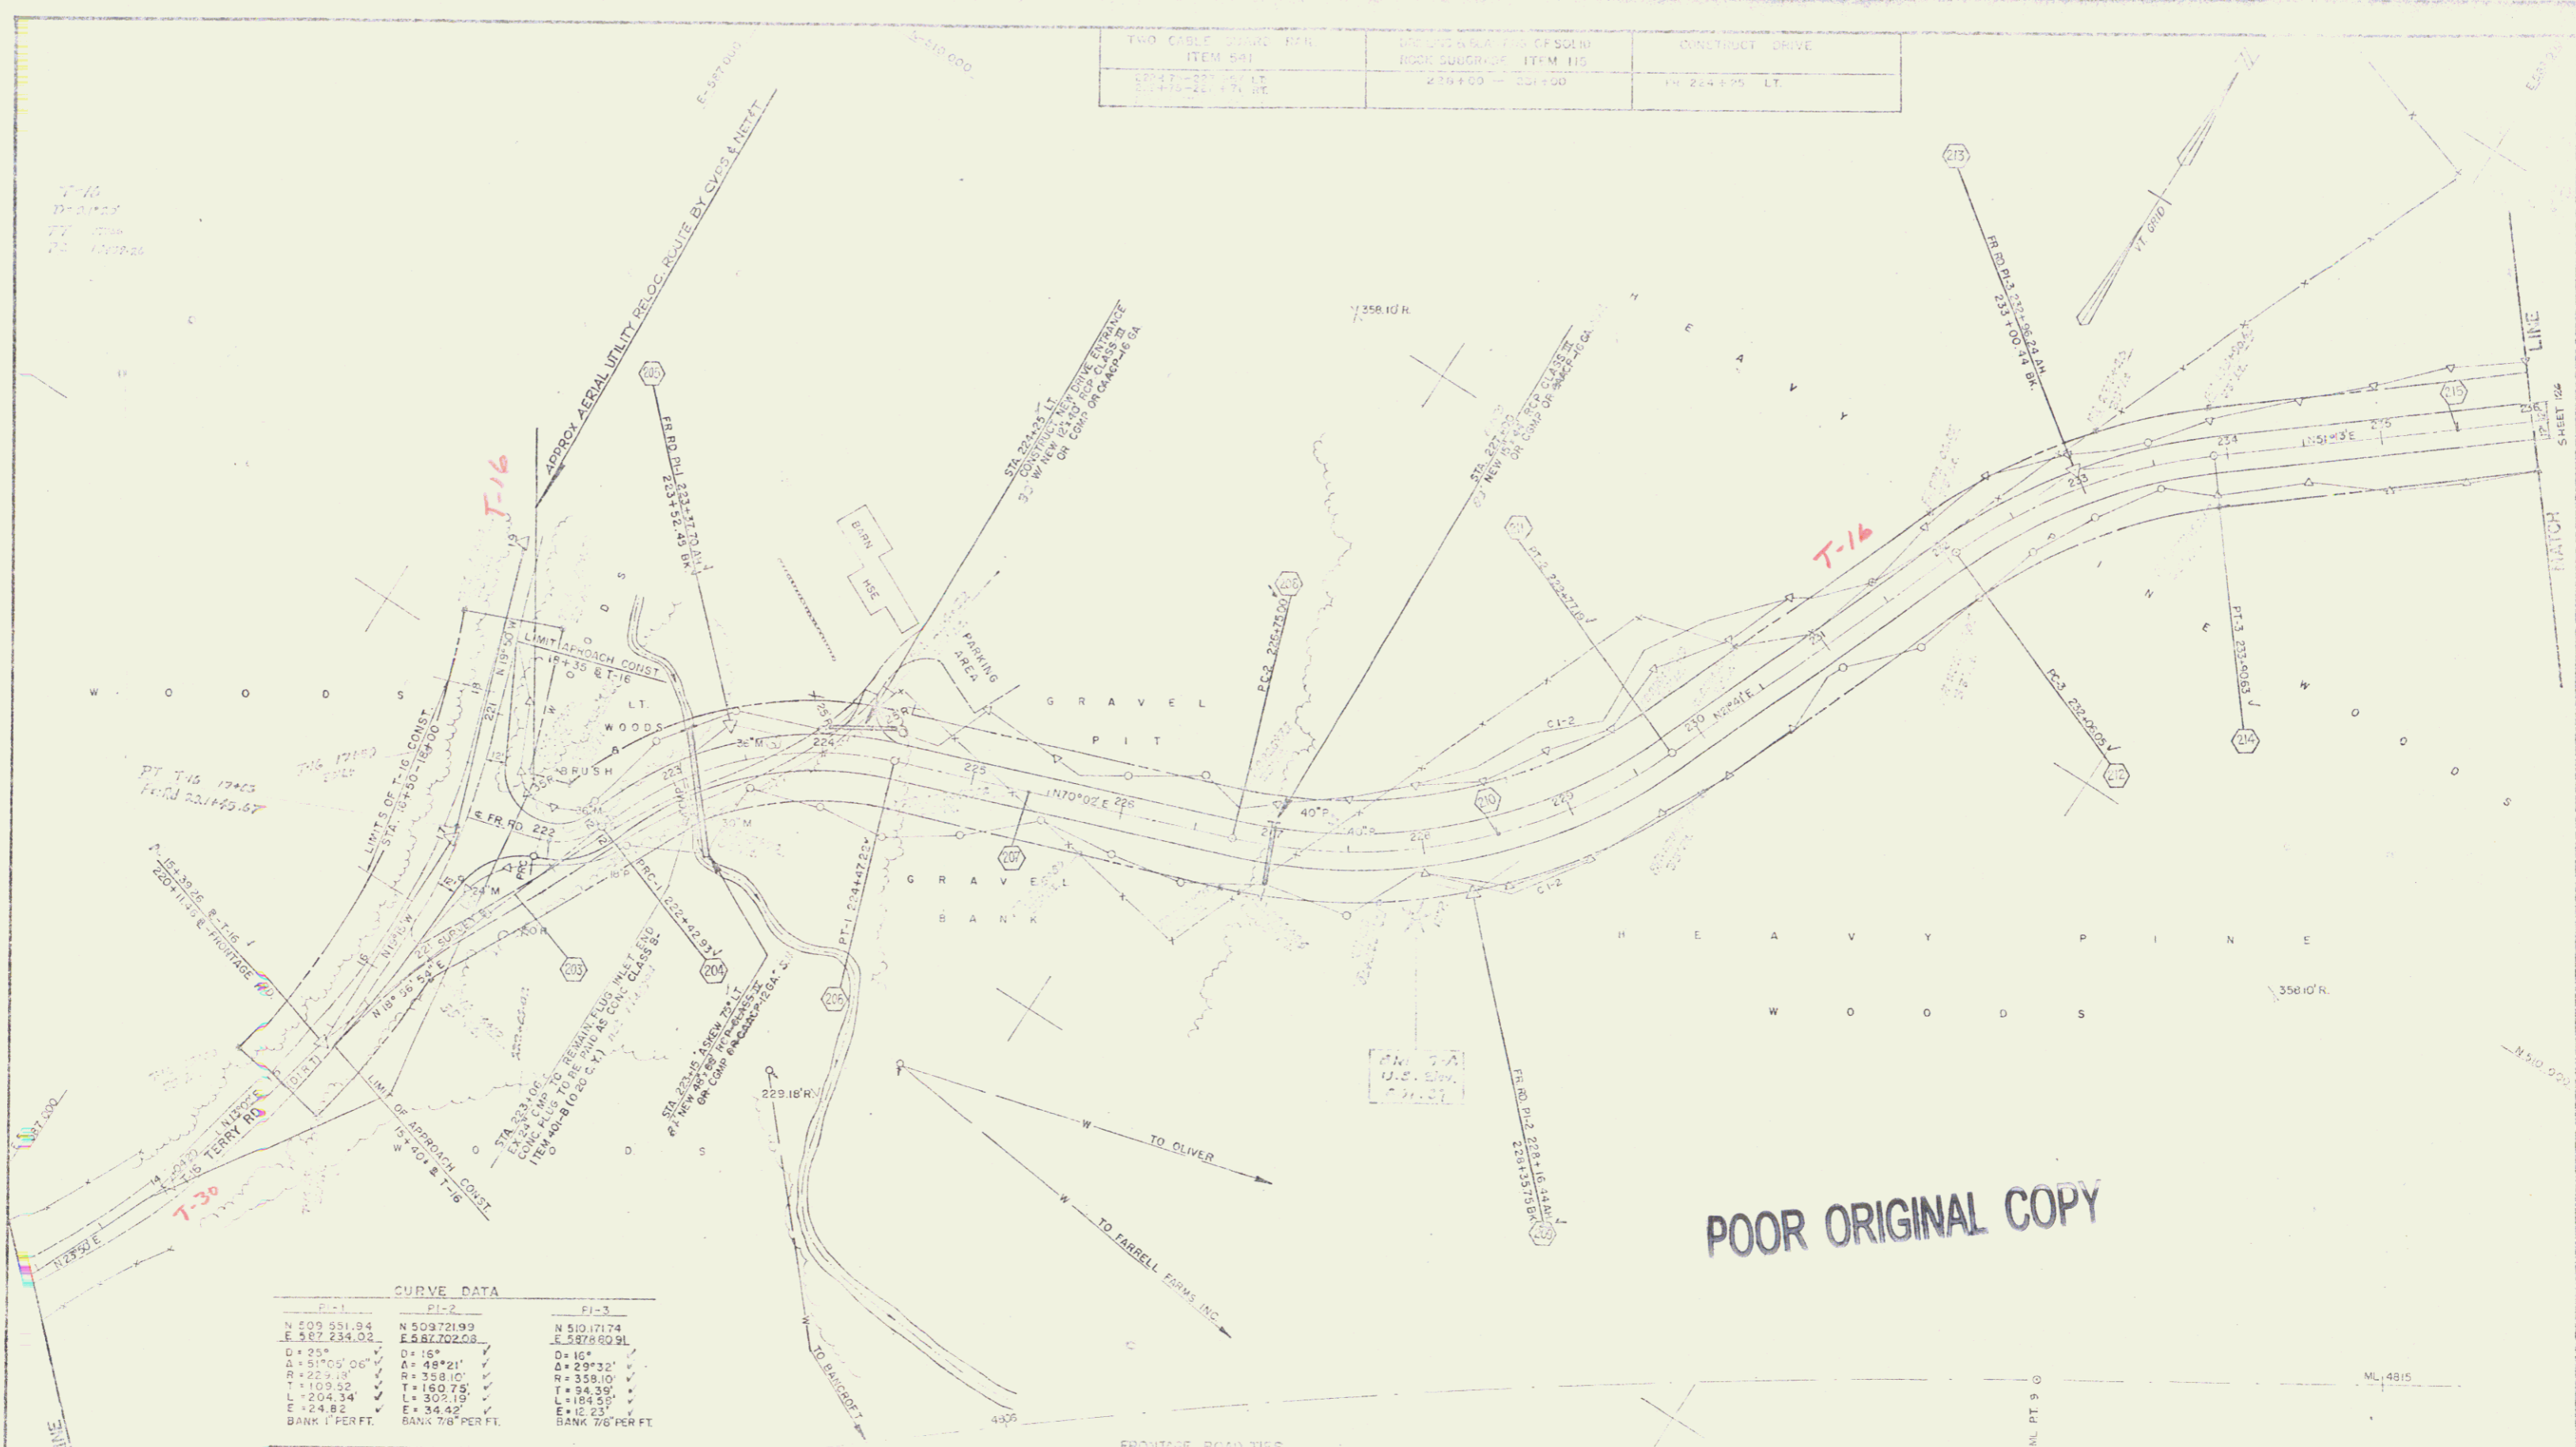

POOR ORIGINAL COPY

CURVE DATA		
PI-1	PI-2	PI-3
N 409 551.04	N 509 721.99	N 510 101.74
E 387 234.02	E 582 702.08	E 587 809.91
D = 25'	D = 18' 21"	D = 16'
A = 51° 05' 06"	A = 48° 21'	A = 29° 32'
R = 25.41'	R = 338.10'	R = 338.10'
T = 109.55'	T = 160.75'	T = 94.39'
L = 204.34'	L = 305.19'	L = 184.53'
E = 24.82'	E = 34.42'	E = 12.23'
BANK 1 PER FT.	BANK 7/8 PER FT.	BANK 7/8 PER FT.

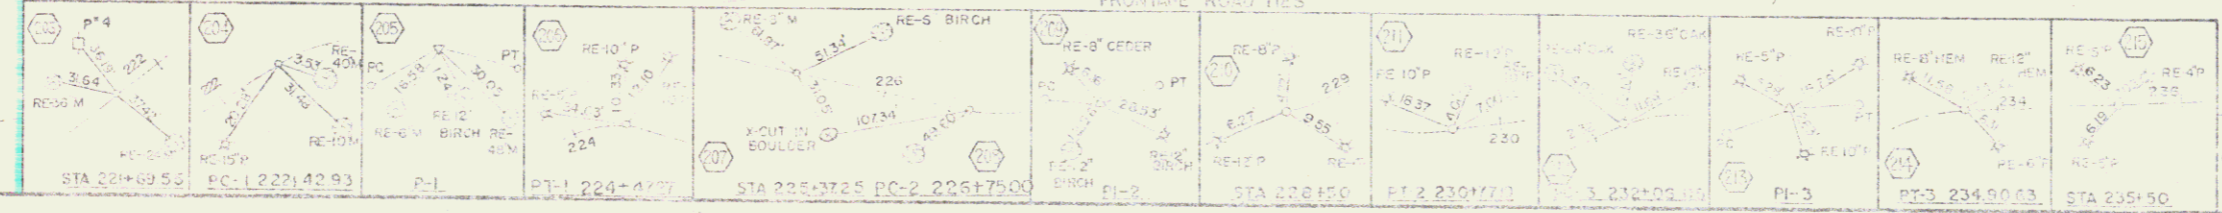

THETFORD - FAIRLEE
 CONTRACT STAGE I CONSTRUCTION
 T16-T14-FRONTAGE RD.
 STA 221+00 TO 235+00

PLAN SCALE
 0 50 100 FEET

PROJECT I 81.2 (9) | SHEET 129 OF 153